U.S. ROUTE 2
MARSHFIELD
F028-3(28)

FINAL SURVEY
NOTE BOOK No.
SURVEYED
PLOTTED
TEMPLATE
AREAS
AREAS CHECKED
BY
DATE

ORIGINAL SURVEY
NOTE BOOK No.
SURVEYED
PLOTTED
TEMPLATE
AREAS
AREAS CHECKED
BY
DATE

REV. STA. 176+55, LT
END STONE LINED DITCH
TYPE I, 6' WIDE.
MATCH EXISTING BROOK
@ 176+55

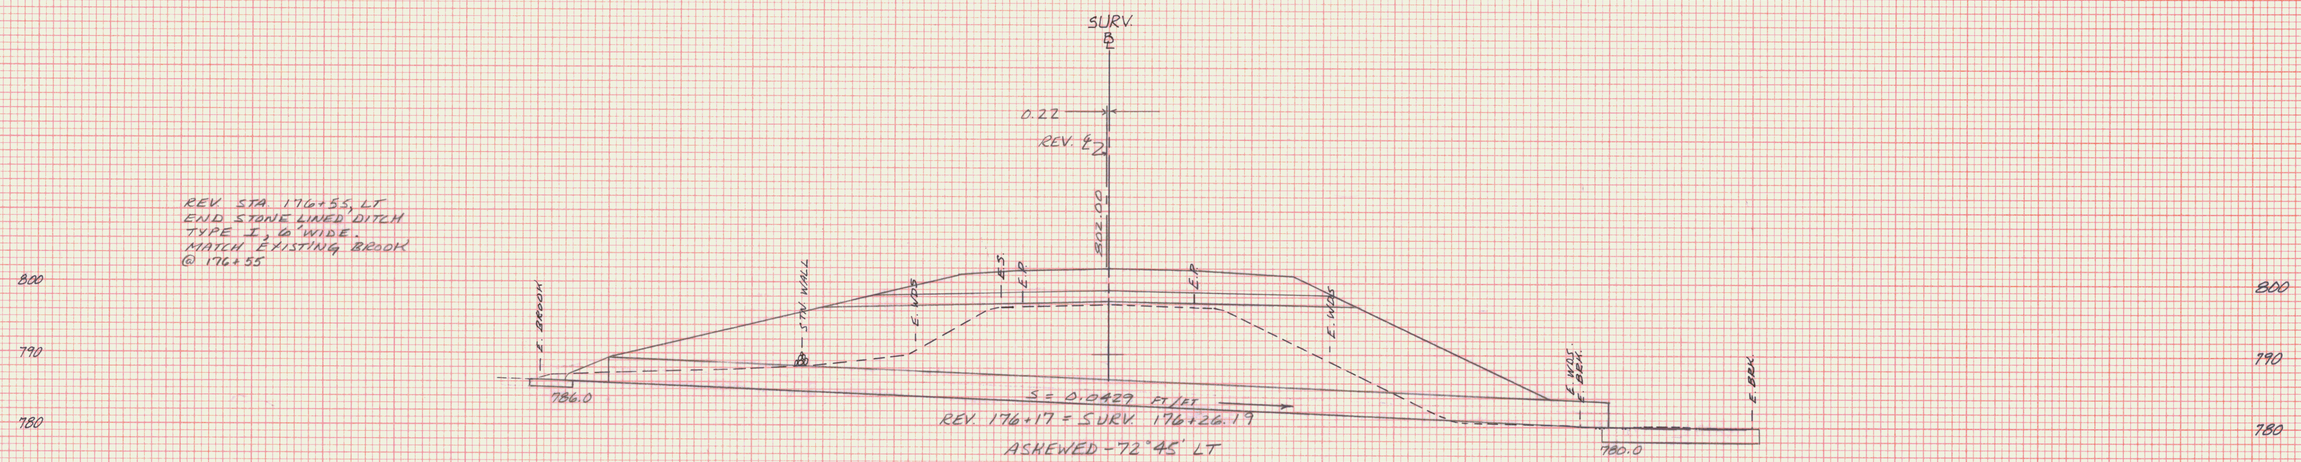

REV. STA. 176+17 ASKEWED 72°45' LT
NEW 42" x 140' PCCSP 0.109", CAAP 0.105"
w/ES @ INLET, PAD W/STONE
FILL TYPE II @ OULET 5' WIDE x 2' DEEP
EXTENDING 21' BEYOND END OF CULVERT.

STA. 176+26.19 STA.
TOWN MARSHFIELD
PROJECT F NO. 028-3(28)
SHEET 213 OF 342 SHEETS
HORIZ. AND VERT. SCALE
0 10 20
VT. SURVEY
SURVEYED BY: CONSULTANTS DATE