U.S. ROUTE 2
MARSHFIELD
F028-3(28)

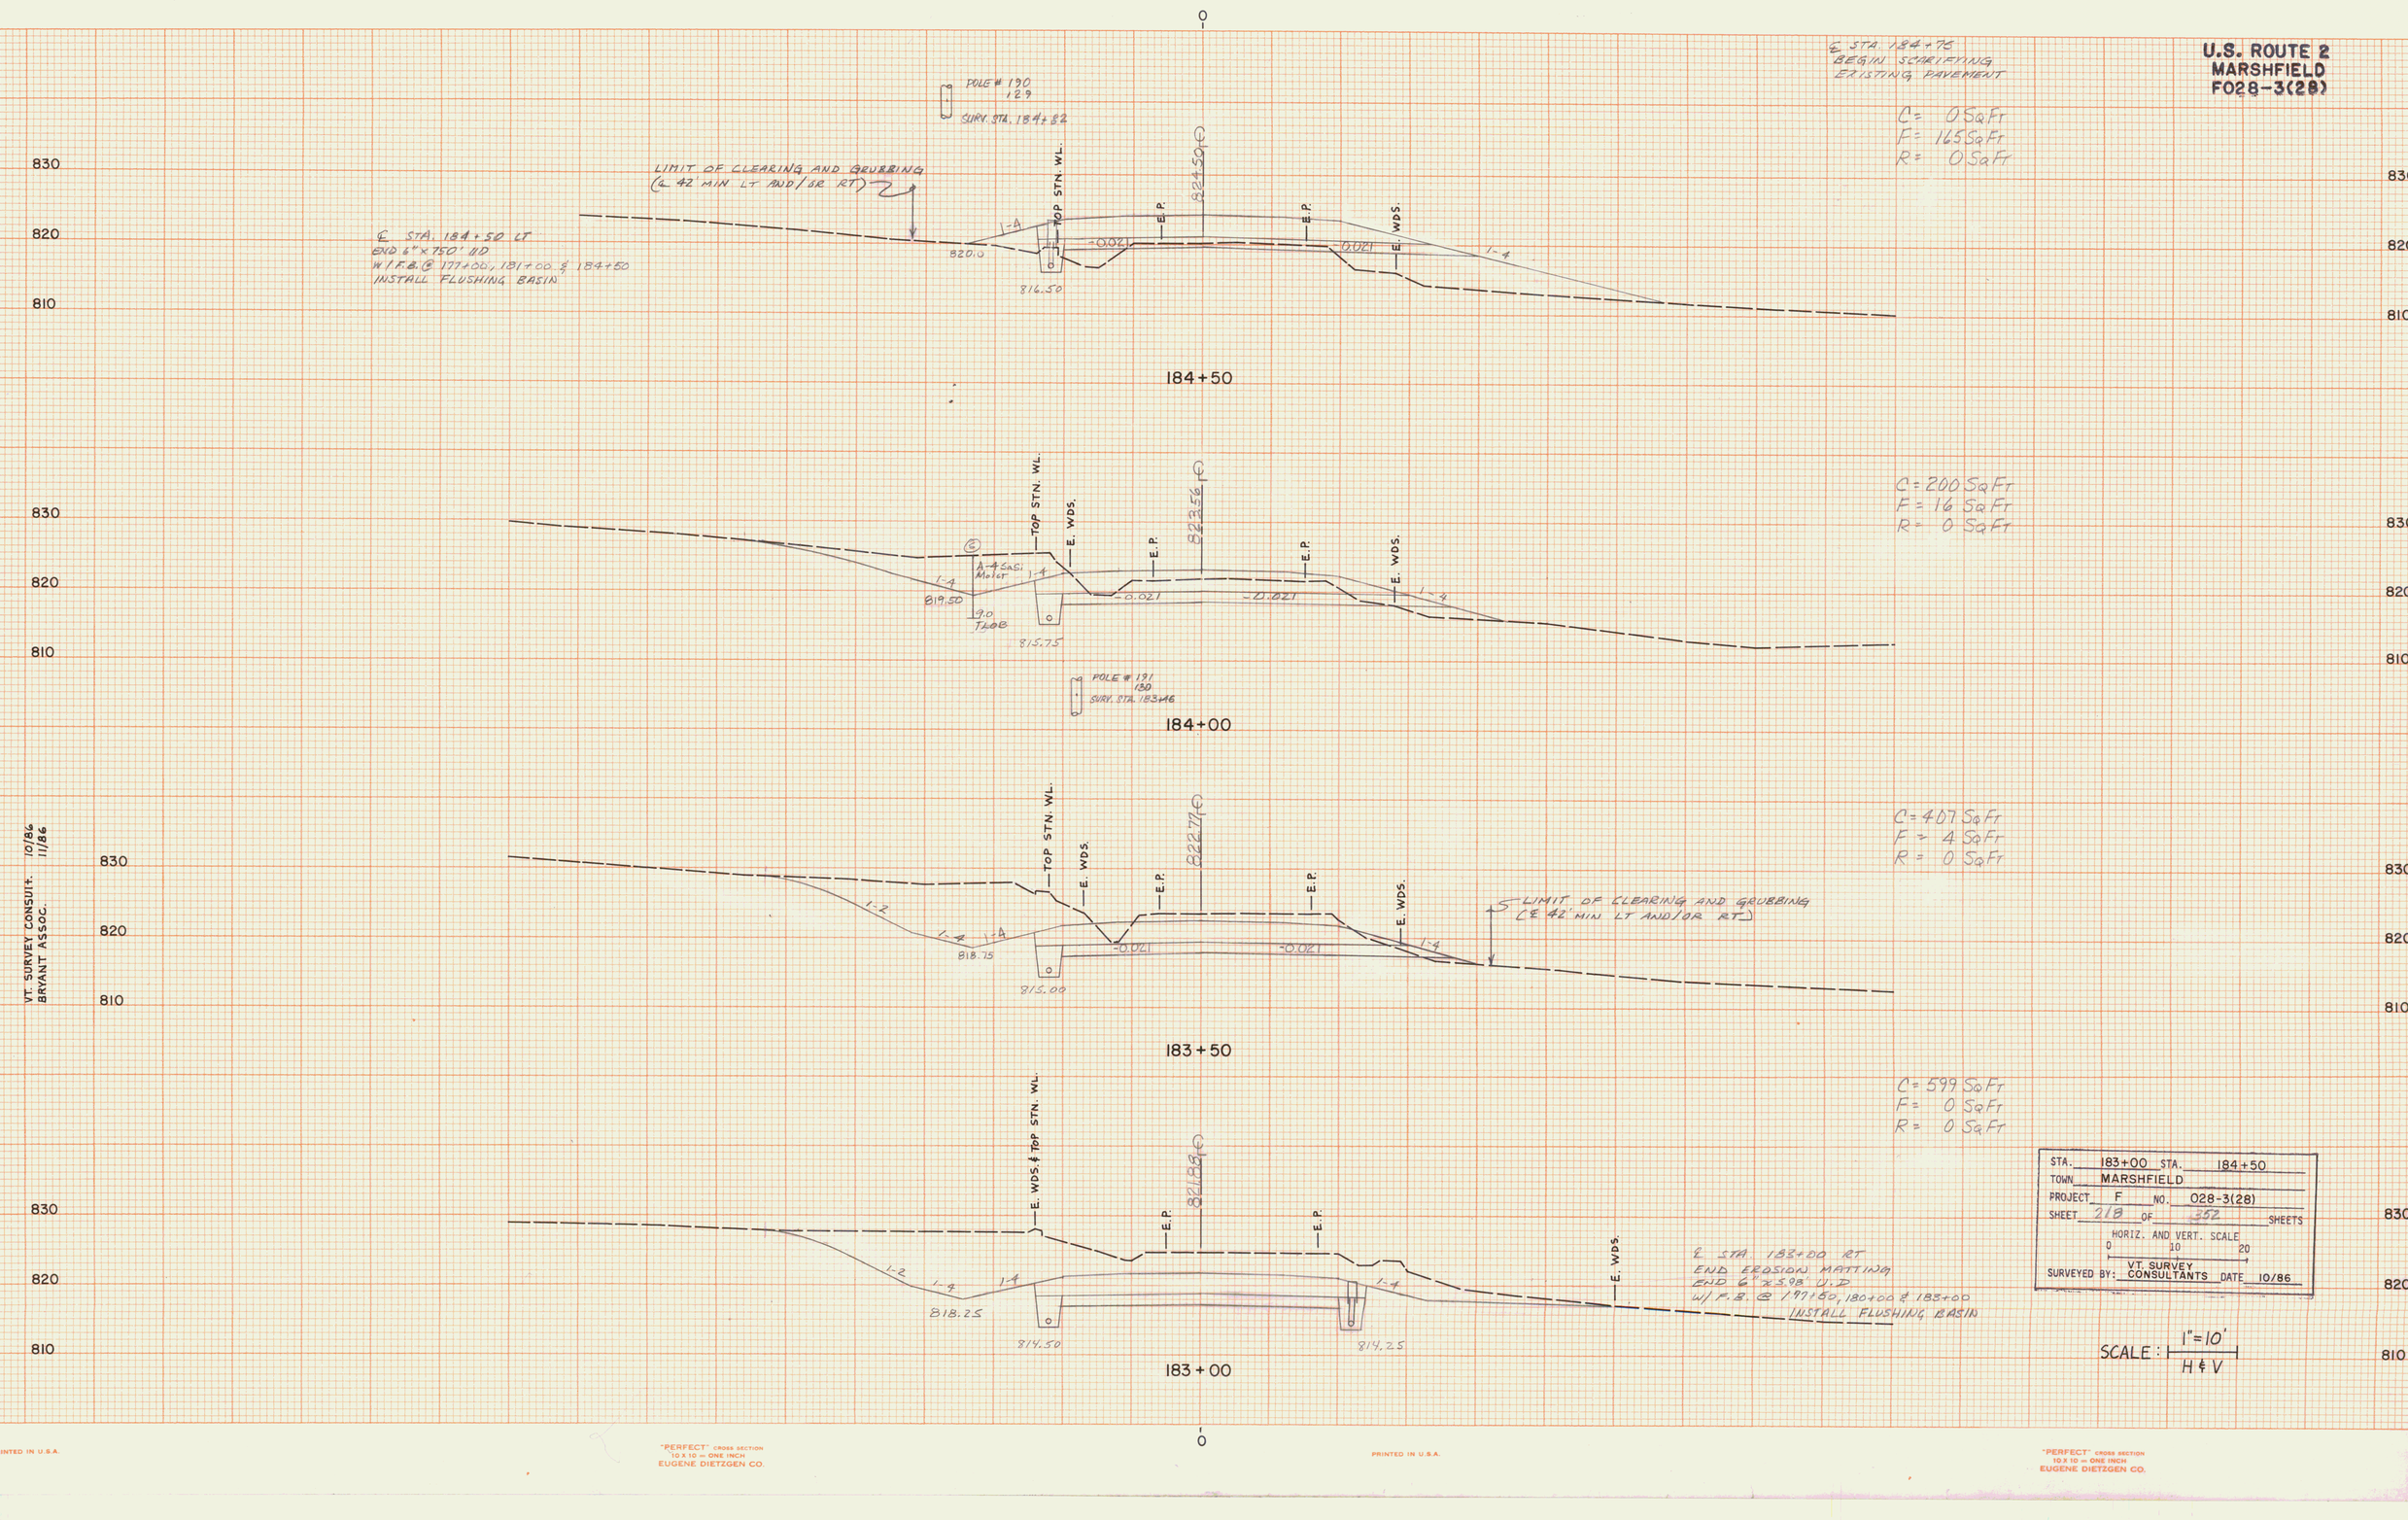

VT. SURVEY CONSULT. 10/86
BRYANT ASSOC. 11/86

STA.	183+00 STA. 184+50
TOWN	MARSHFIELD
PROJECT	F NO. 028-3(28)
SHEET	218 OF 252 SHEETS
HORIZ. AND VERT. SCALE	0 10 20
SURVEYED BY:	VT. SURVEY CONSULTANTS DATE 10/86

SCALE: 1"=10' H & V

PRINTED IN U.S.A.
"PERFECT" CROSS SECTION 10 X 10 — ONE INCH EUGENE DIETZGEN CO.