U.S. ROUTE 2
MARSHFIELD
F028-3(28)

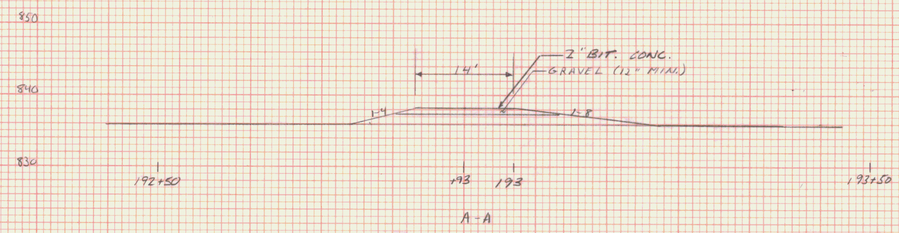

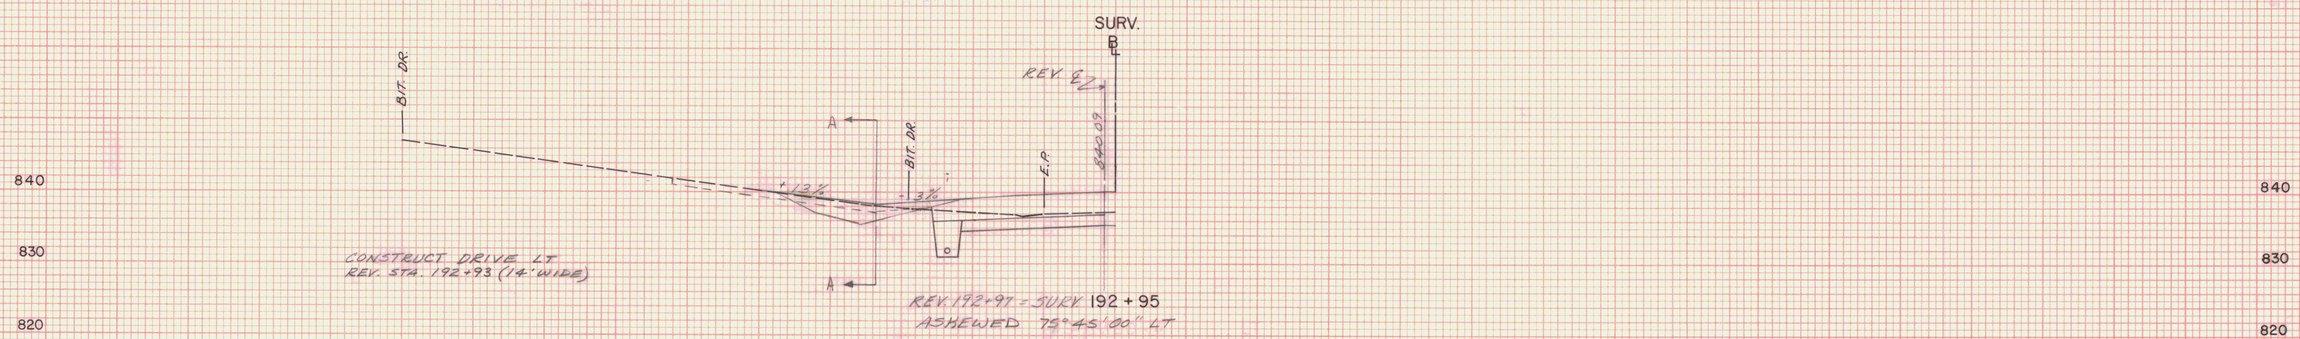

STA. 192 + 95	STA.		
TOWN MARSHFIELD			
PROJECT F	NO. 028-3(28)		
SHEET 224 OF 352	SHEETS		
HORIZ. AND VERT. SCALE 0 10 20			
SURVEYED BY: VT. SURVEY CONSULTANTS	DATE 10/86		

FINAL SURVEY — NOTE BOOK No. — SURVEYED / PLOTTED / TEMPLATE / AREAS / AREAS CHECKED — BY — DATE

ORIGINAL SURVEY — NOTE BOOK No. — SURVEYED / PLOTTED / TEMPLATE / AREAS / AREAS CHECKED — BY VT. SURVEY Consult. GRANIT ASSOC. — DATE 10/86 11/86

PLATE 3 CROSS SECTION O. P. R. & R. E. STANDARD
DIETZGEN CORPORATION