U.S. ROUTE 2
MARSHFIELD
F028-3(28)

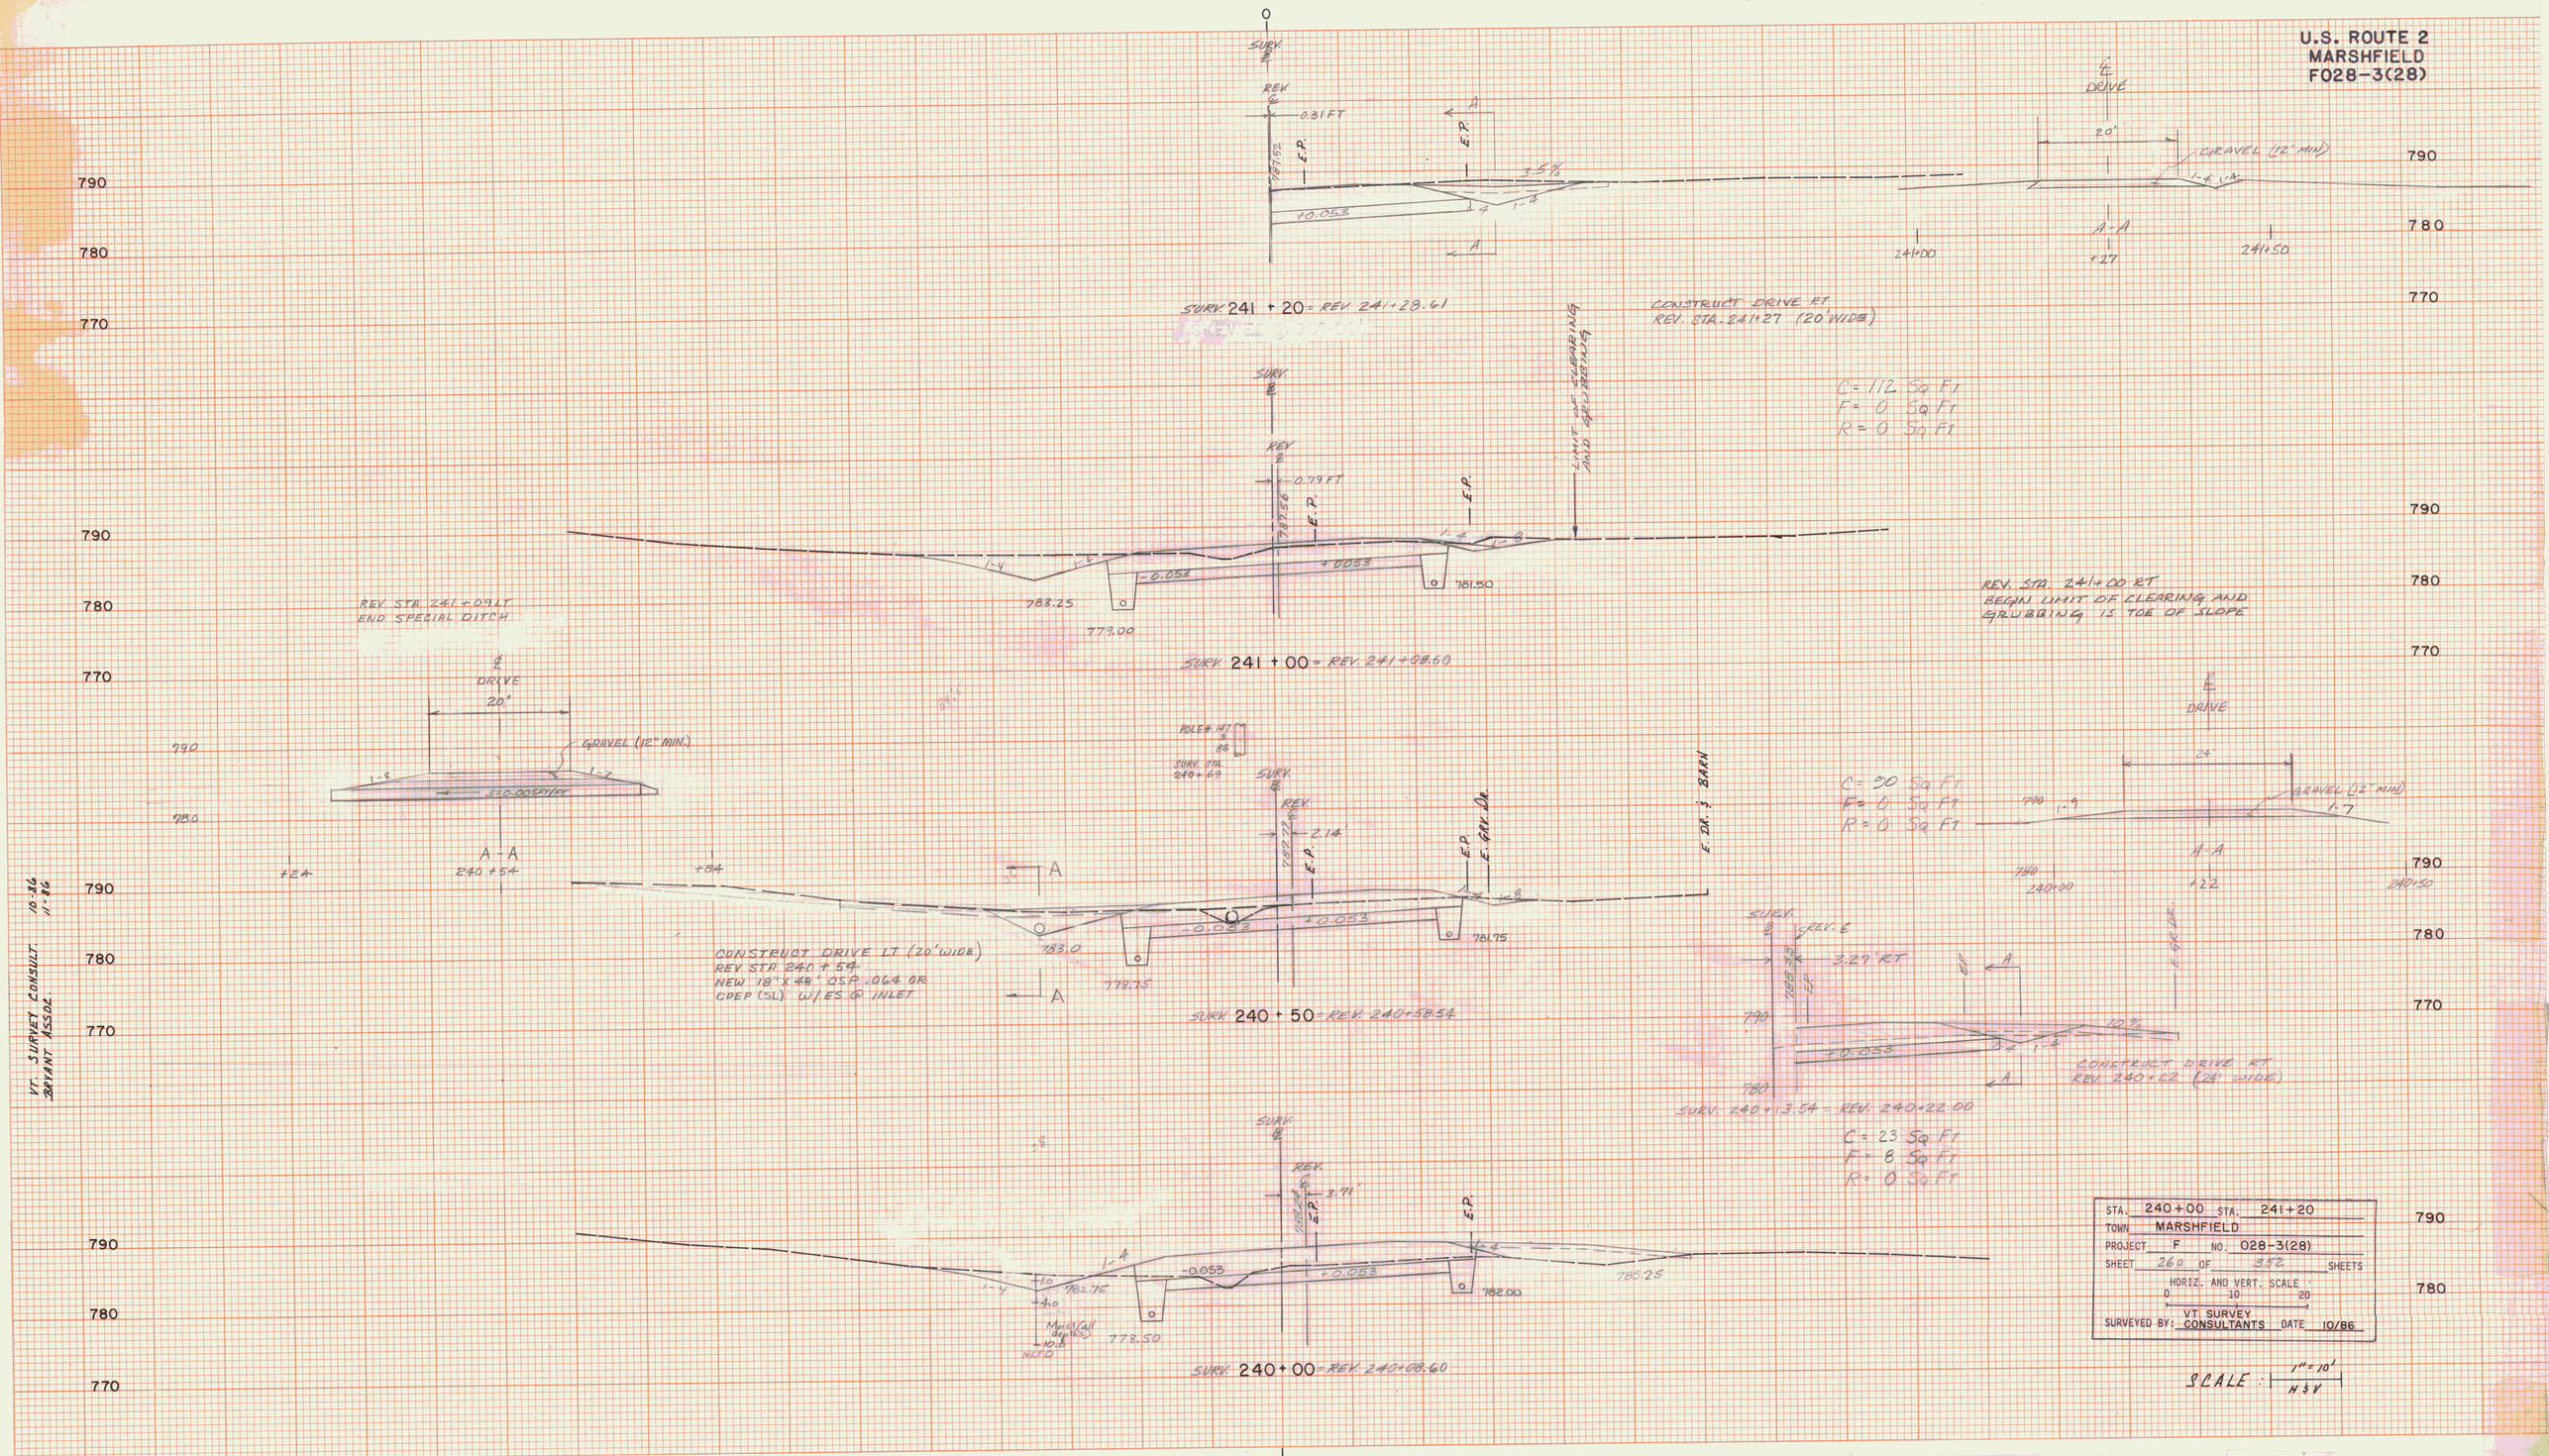

STA. 240+00	STA. 241+20
TOWN MARSHFIELD	
PROJECT F	NO. 028-3(28)
SHEET 260	OF 352 SHEETS

HORIZ. AND VERT. SCALE
0 10 20

VT. SURVEY CONSULTANTS
SURVEYED BY: DATE 10/86

SCALE: 1" = 10' / H & V

VT. SURVEY CONSULT. 10-86
BRYANT ASSOC. 11-86

"PERFECT" CROSS SECTION
10 X 10 — ONE INCH
EUGENE DIETZGEN CO.

PRINTED IN U.S.A.

"PERFECT" CROSS SECTION
10 X 10 — ONE INCH
EUGENE DIETZGEN CO.