U.S. ROUTE 2
MARSHFIELD
F028-3(28)

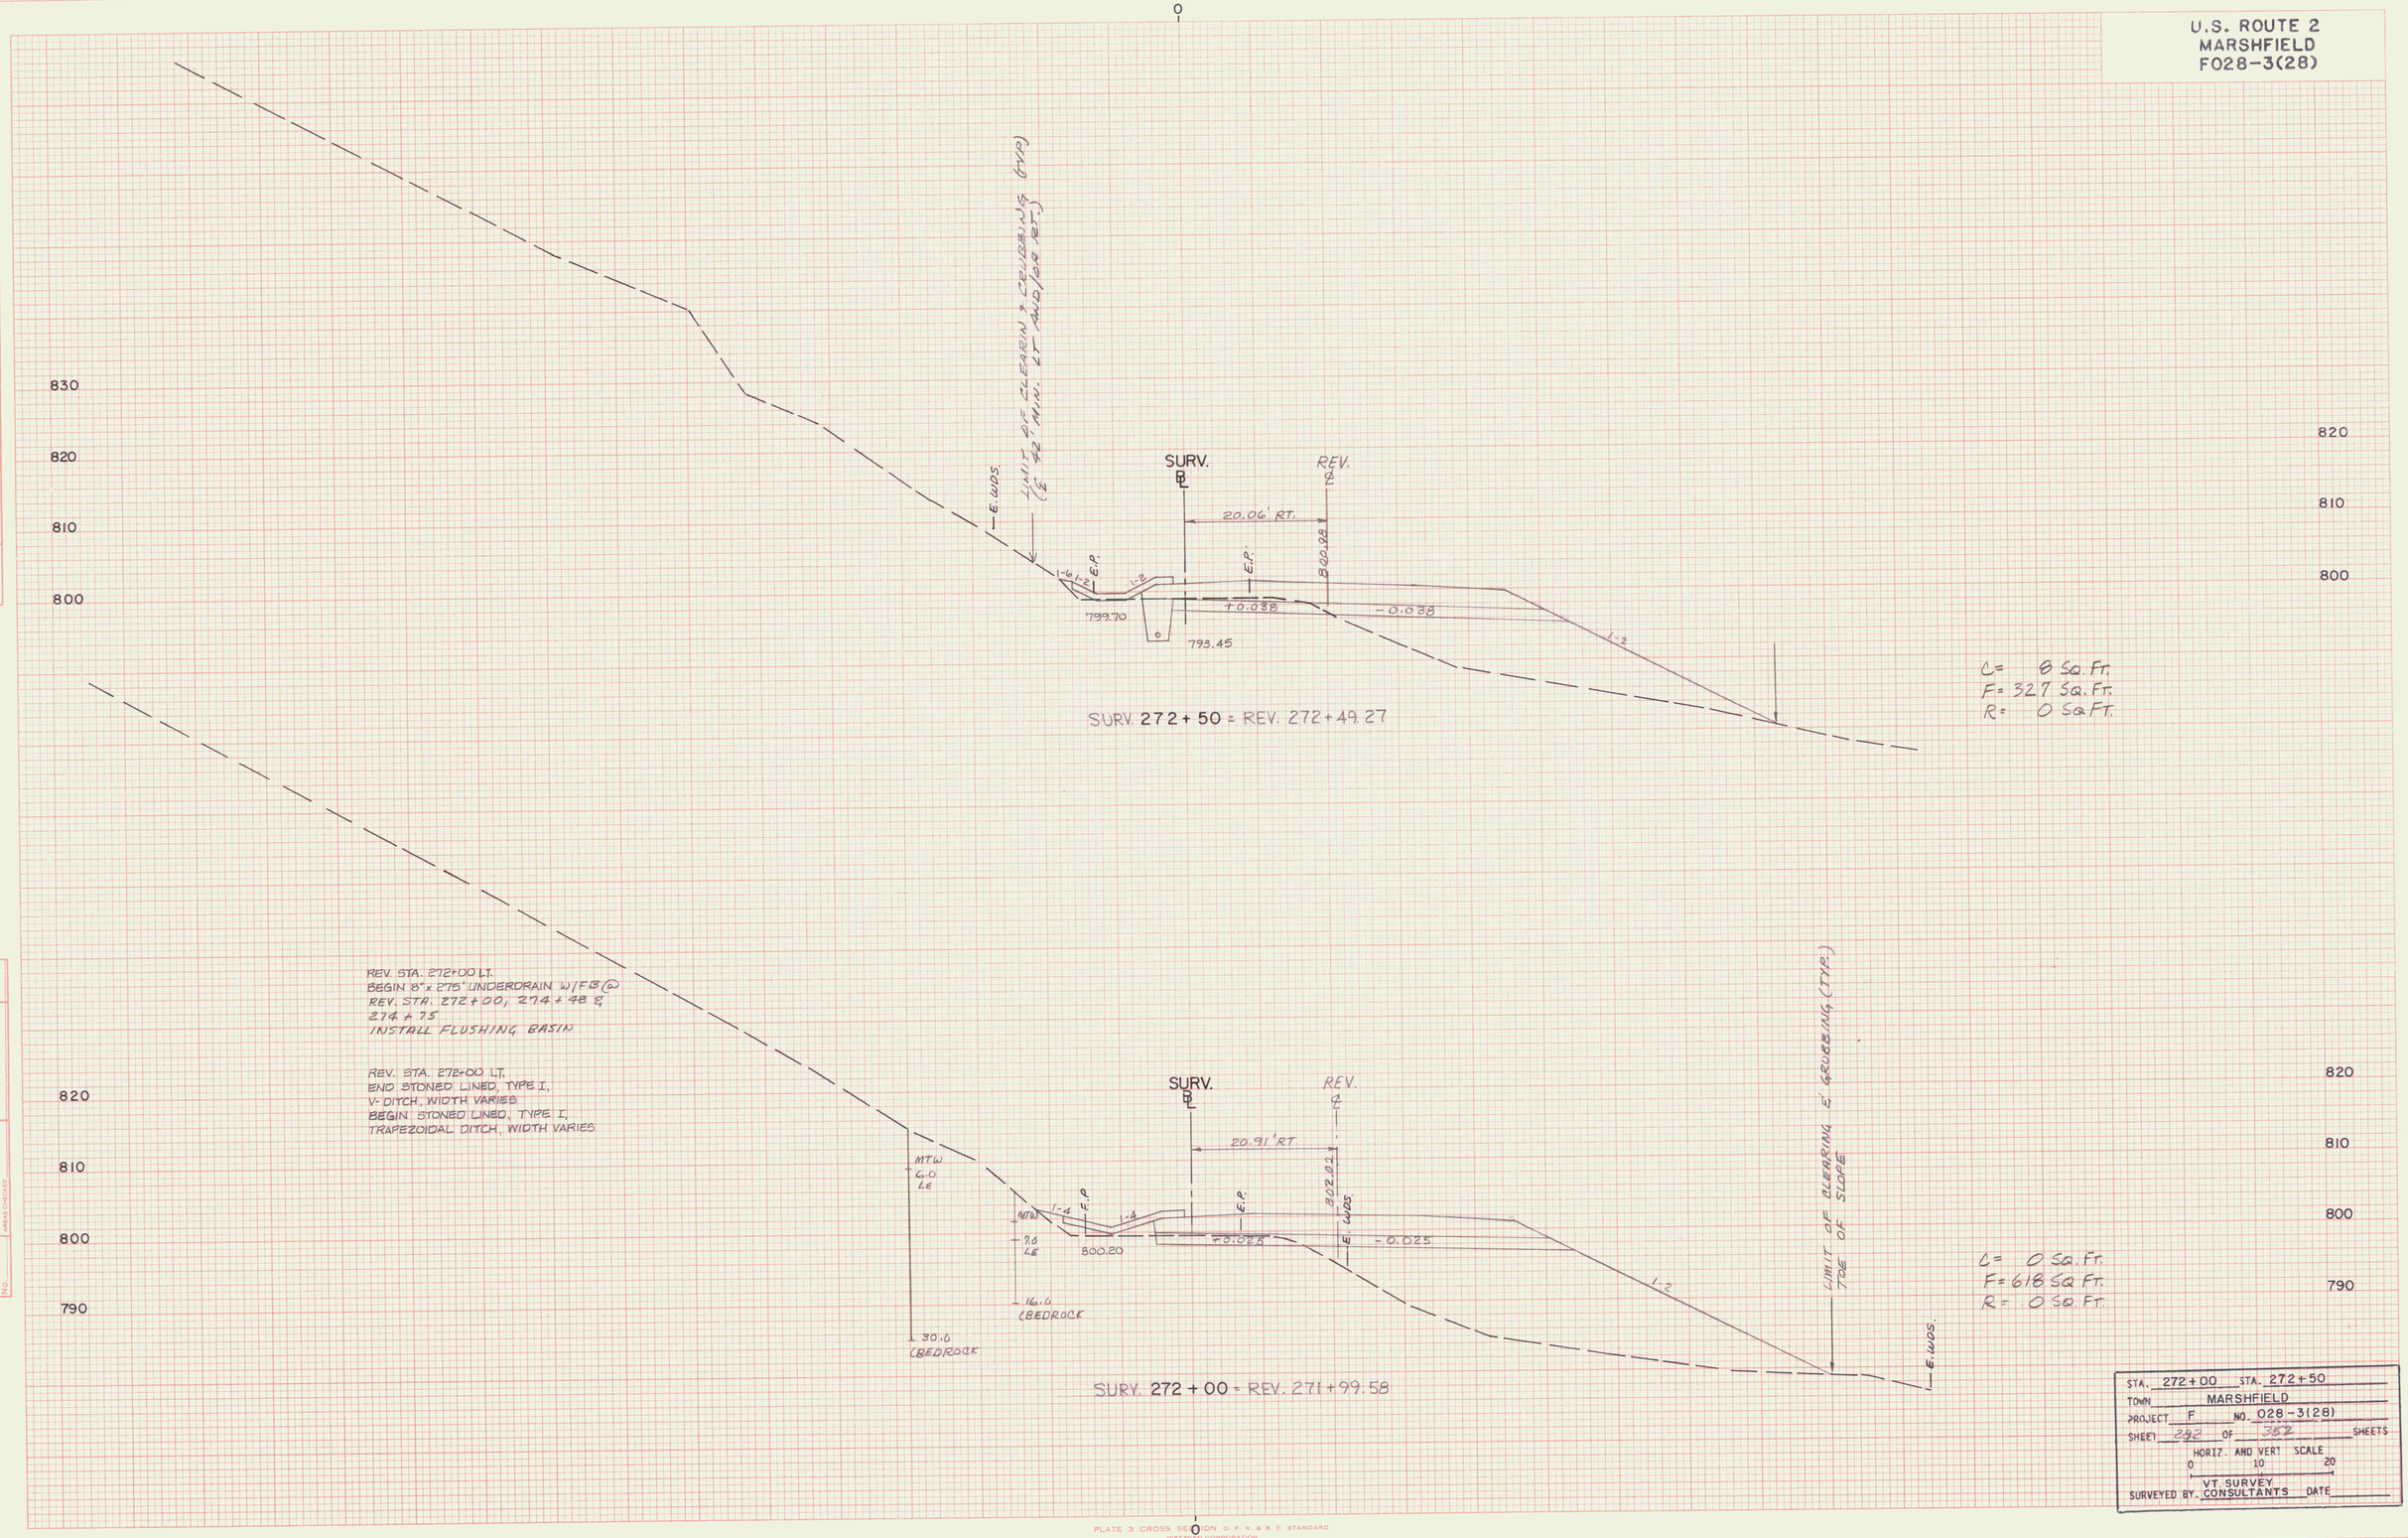


| | |
|---|---|
| STA. 272+00 | STA. 272+50 |
| TOWN MARSHFIELD | |
| PROJECT F | NO. 028-3(28) |
| SHEET 282 OF 382 | SHEETS |
| HORIZ. AND VERT. SCALE 0 10 20 | |
| SURVEYED BY VT. SURVEY CONSULTANTS | DATE |

FINAL SURVEY — NOTE BOOK No. — SURVEYED, PLOTTED, TEMPLATE, AREAS, AREAS CHECKED — BY — DATE

ORIGINAL SURVEY — NOTE BOOK No. — SURVEYED, PLOTTED, TEMPLATE, AREAS, AREAS CHECKED — BY — DATE

PLATE 3 CROSS SECTION O. P. R. & R. E. STANDARD
DIETZGEN CORPORATION