


FINAL SURVEY	DATE
	BY
	NO.
	REVISIONS

ORIGINAL SURVEY	DATE
	BY
	NO.
	REVISIONS

U.S. ROUTE 2
MARSHFIELD
F028-3(28)

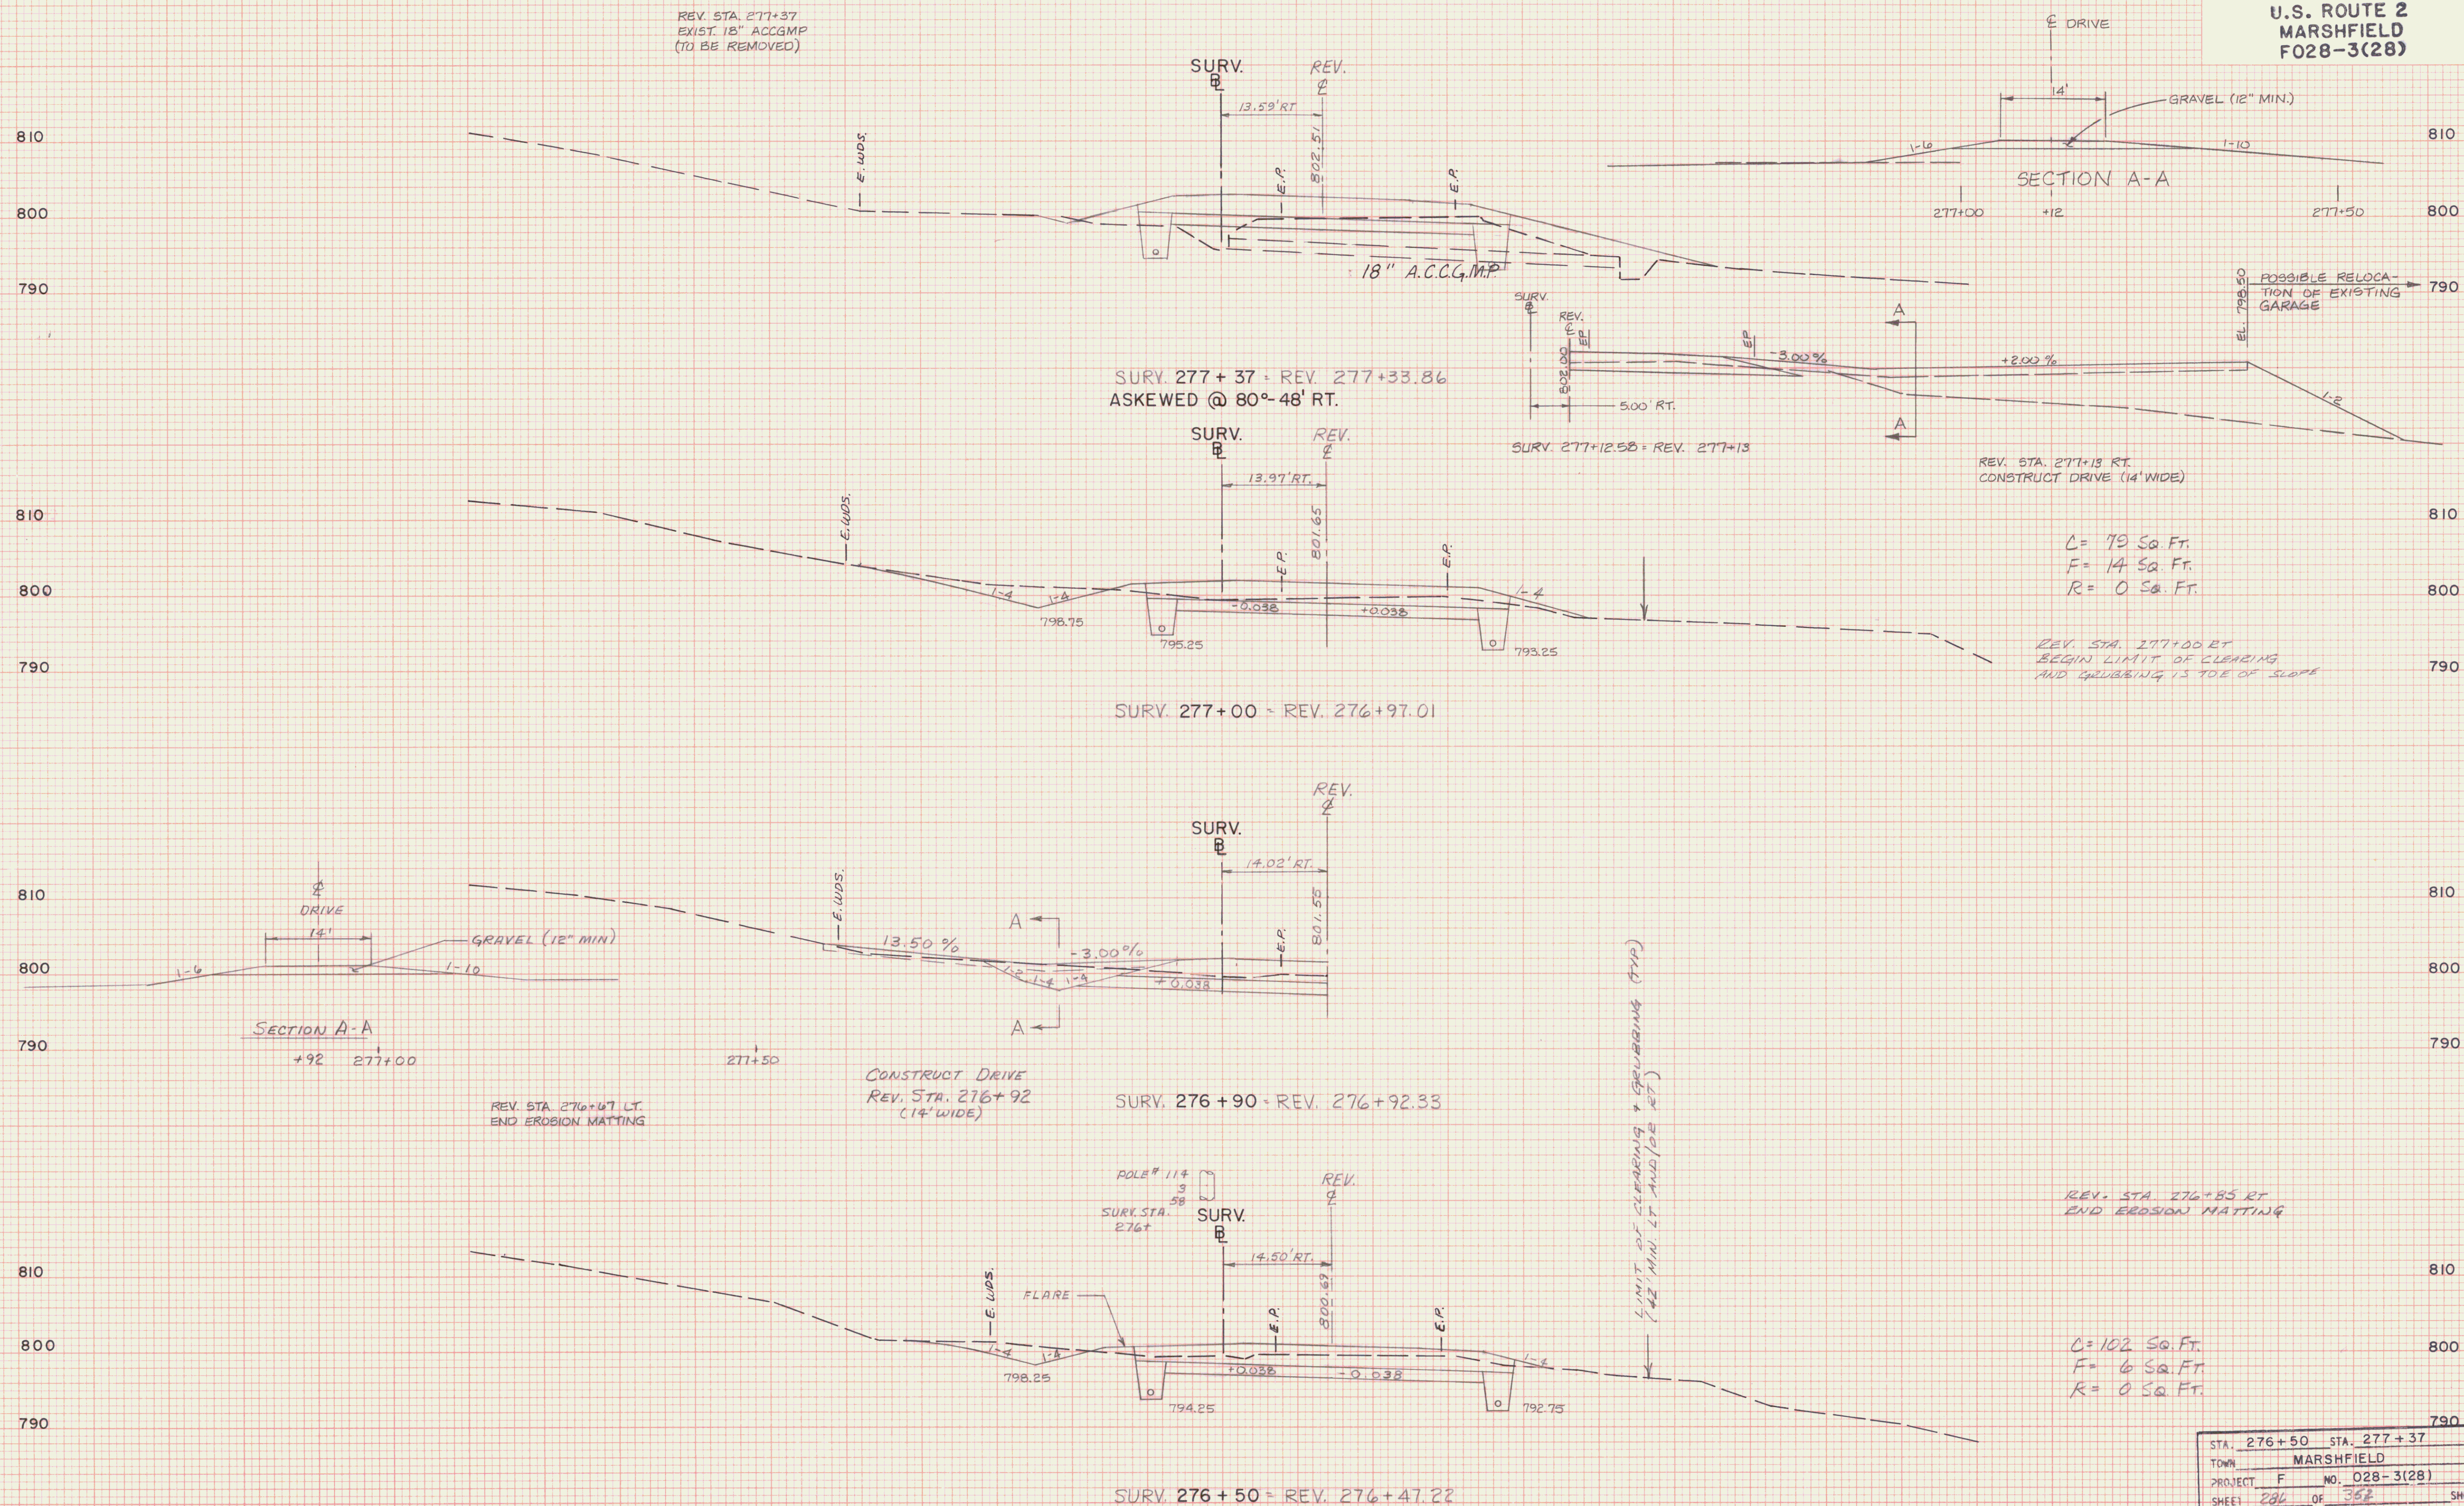

STA. 276+50	STA. 277+37
TOWN	MARSHFIELD
PROJECT	F NO. 028-3(28)
SHEET	286 OF 362 SHEETS
HORIZ. AND VERT. SCALE	
0 10 20	
VT. SURVEY	
CONSULTANTS DATE	