T.H. 35
REV. P.O.C. 305+64.81 RT. = T.H. 35 ℄ P.O.T. 89+87.36

U.S. ROUTE 2
MARSHFIELD
F028-3(28)

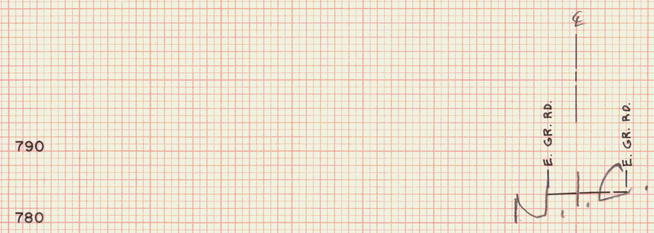

91 + 50

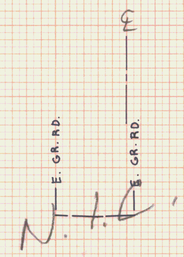

93 + 00

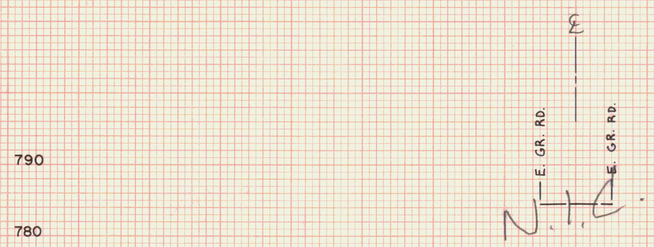

91+00

92+50

90+36.37

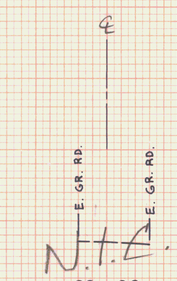

92 + 00

TH #35 2 OF 2

STA.	90+36.37	STA.	93+00
TOWN	MARSHFIELD		
PROJECT	F	NO.	028-3(28)
SHEET	326	OF	352 SHEETS

HORIZ. AND VERT. SCALE
0 10 20

SURVEYED BY: VT. SURVEY CONSULTANTS DATE 12/86

FINAL SURVEY
NOTE BOOK No.
SURVEYED
PLOTTED
TRIANGULATE
AREAS
AREAS CHECKED
BY
DATE

ORIGINAL SURVEY
NOTE BOOK No.
SURVEYED
PLOTTED
TRIANGULATE
AREAS
AREAS CHECKED
BY VT. SURVEY CONSULT. 12/86
BRYANT ASSOC. 1/87
DATE