


DATE	
BY	
SURVEYED	
PLOTTED	
REVIEWED	
DATE	
NO.	

DATE	12/86
BY	VT. SURVEY CONSULTANTS
SURVEYED	BRYANT ASSOC.
PLOTTED	
REVIEWED	
DATE	
NO.	

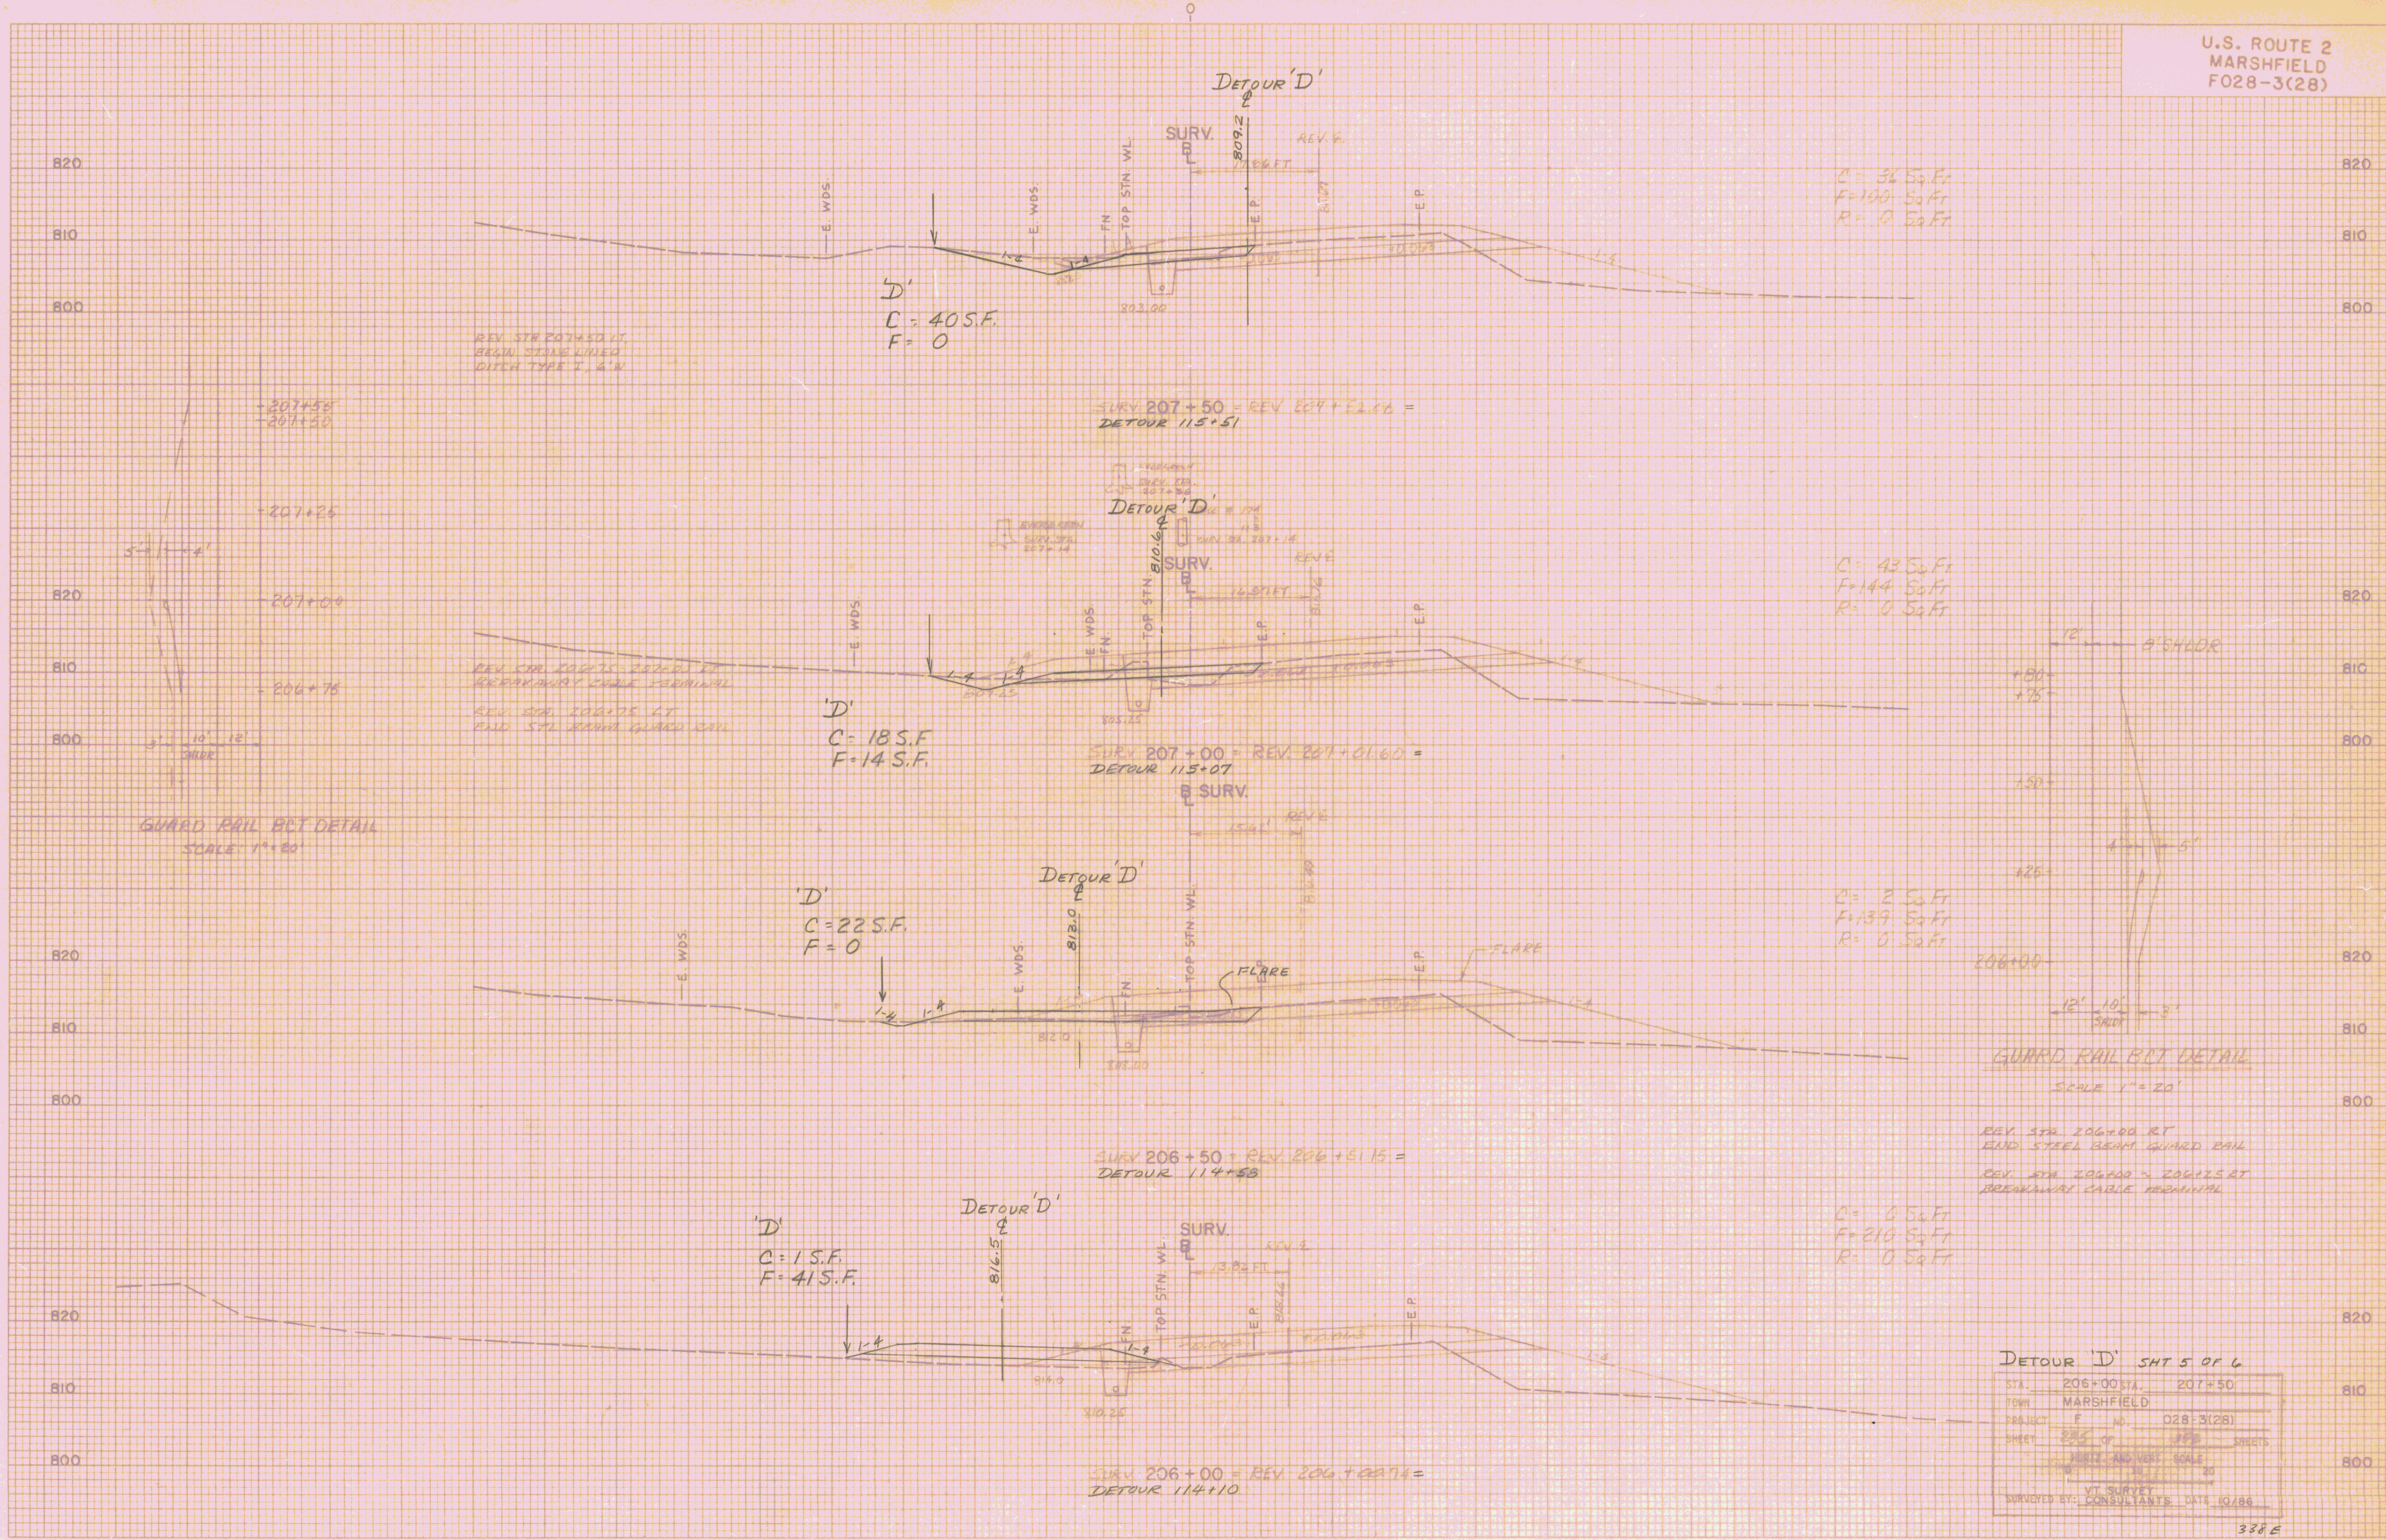

DETOUR 'D' SHT 5 OF 6	
STA.	206+00 STA. 207+50
TOWN	MARSHFIELD
PROJECT	F 028-3(28)
SHEET	285 OF 285 SHEETS
HORIZ. AND VERT. SCALE	
1" = 20'	
VT. SURVEY	
SURVEYED BY: CONSULTANTS DATE 10/86	