


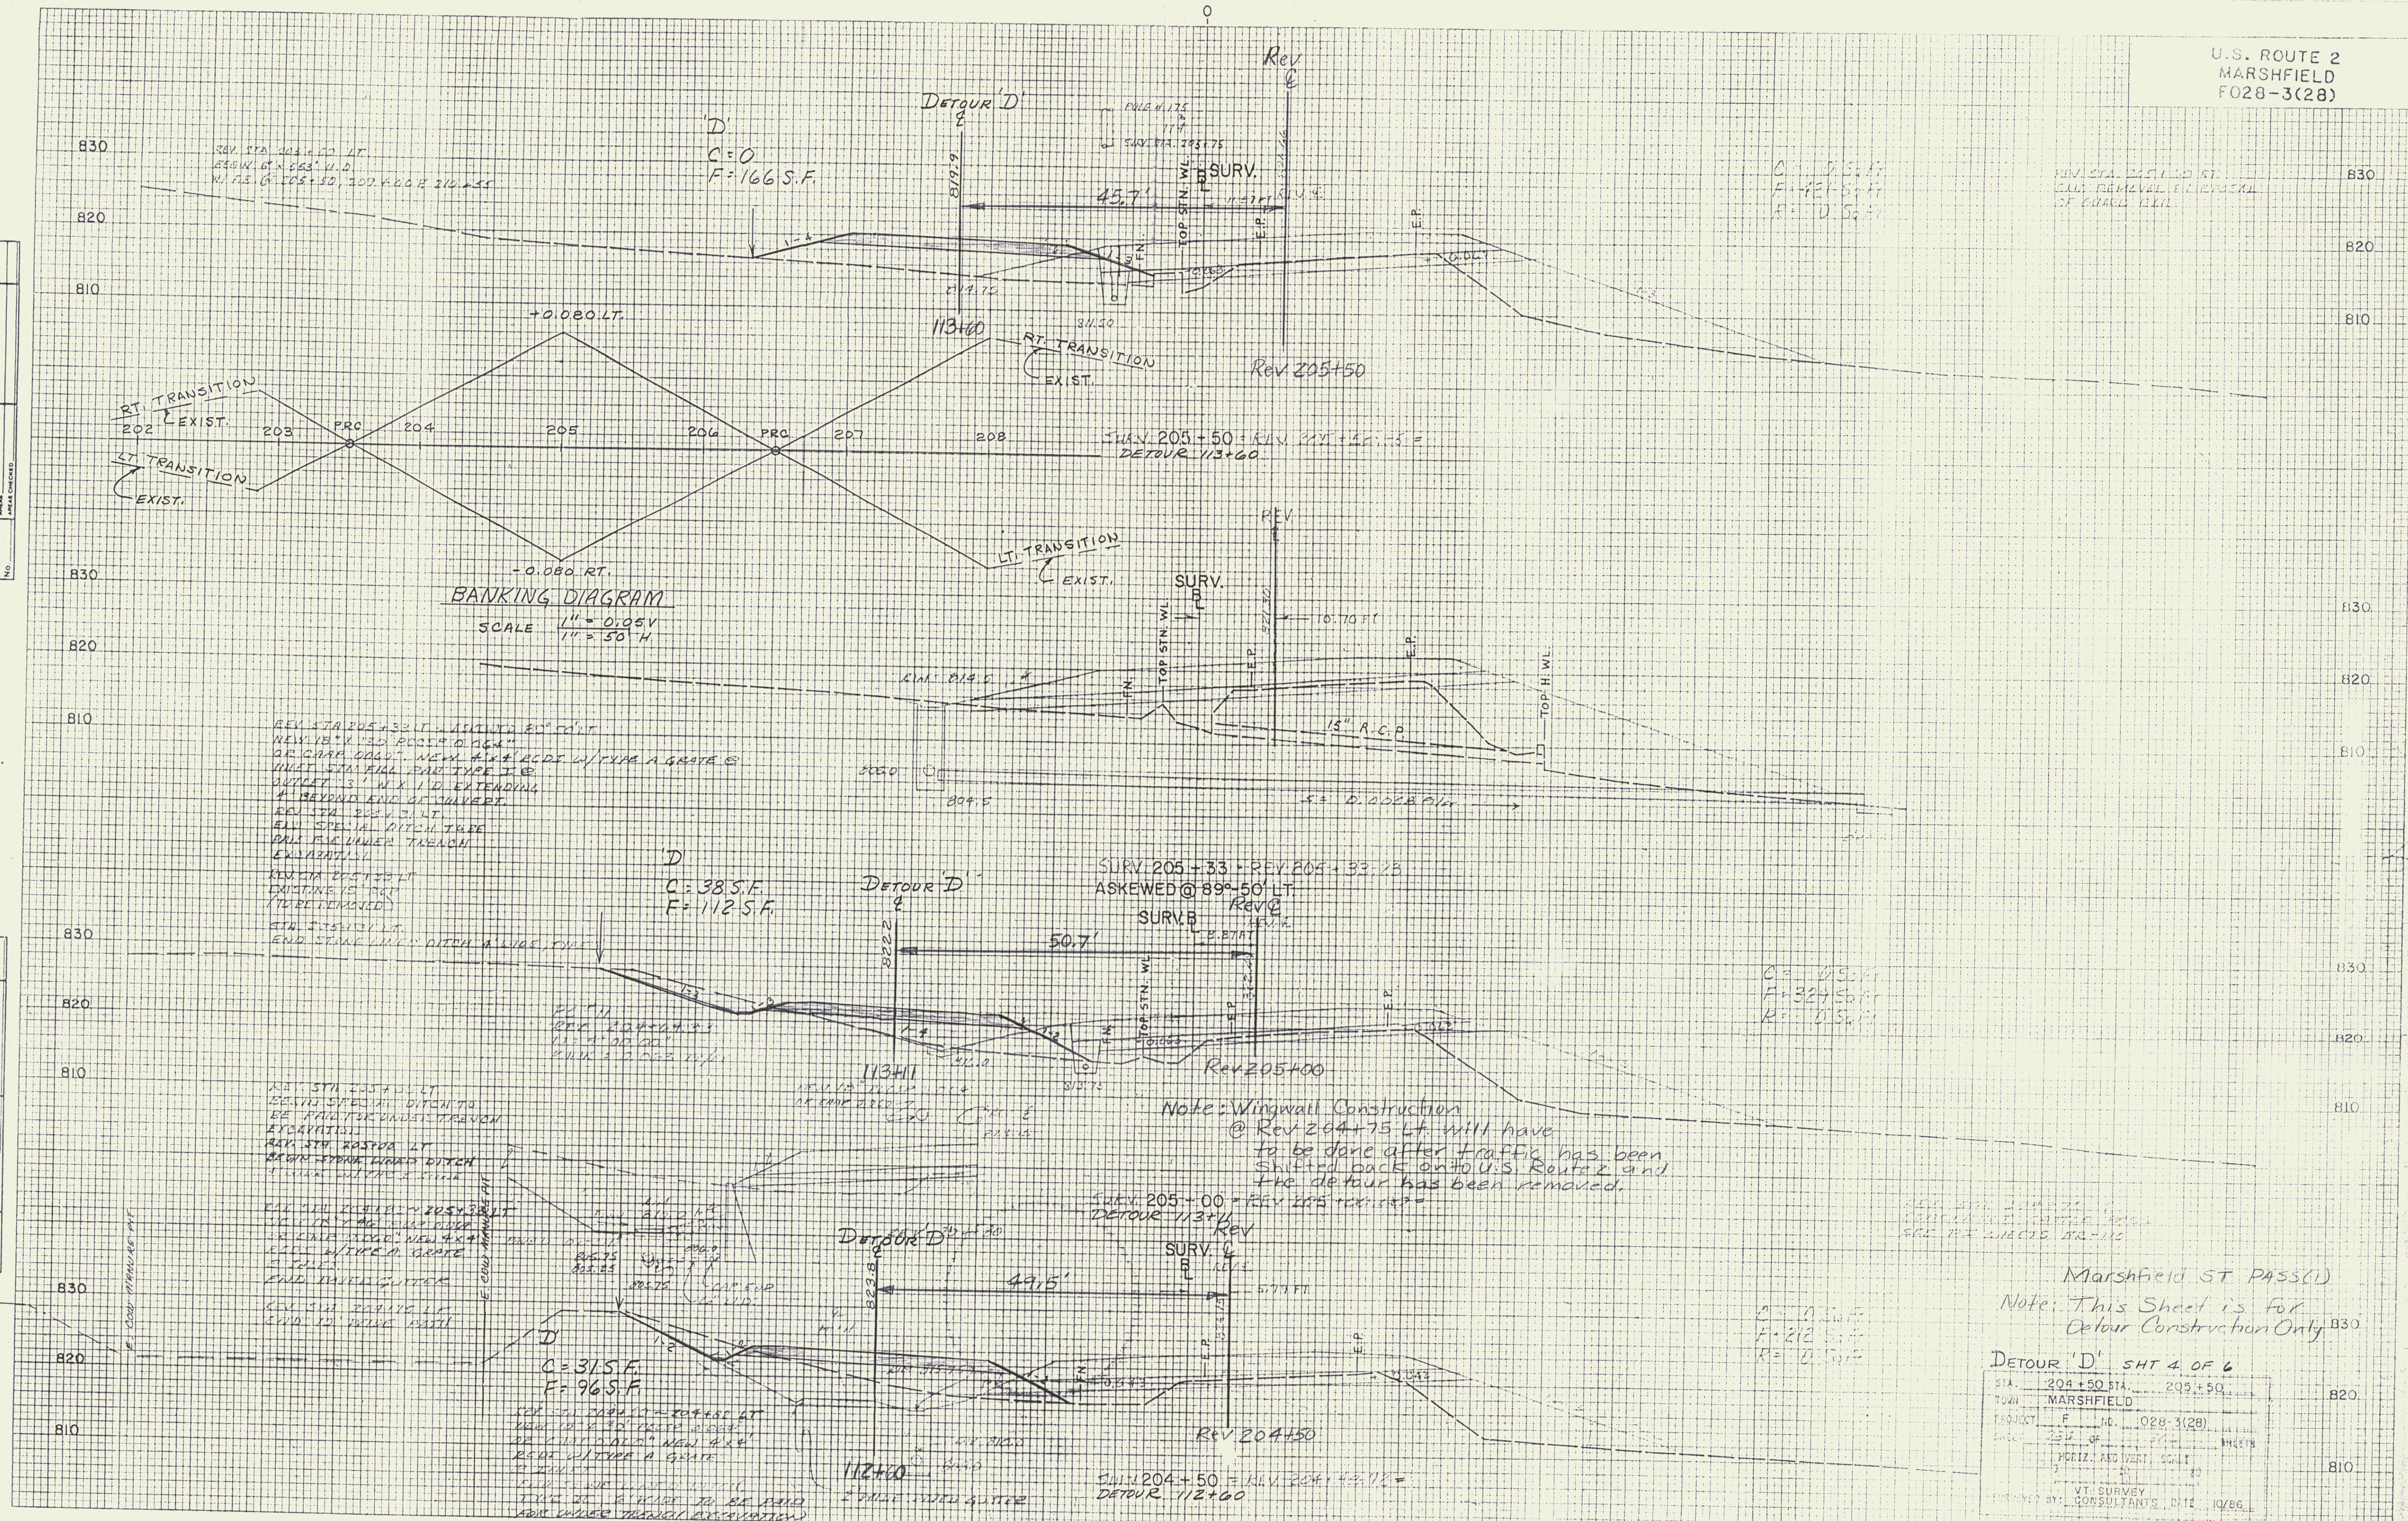

Note: This Sheet is for
 Detail Construction Only B30

DETOUR 'D' SHT 4 OF 6

STA.	204 + 50	STA.	205 + 50
TOWN	MARSHFIELD		
PROJECT	F	NO.	028-3(28)
SHEET	25	OF	27
MORRIS AND WERT		SUNNY	
3		30	
VT. SURVEY			
ENGINEERED BY:		CONSULTANTS	DATE 10/86