


DATE	
BY	
SURVEYED	
PLOTTED	
TEMPLATE	
AREAS CHECKED	
FINAL SURVEY	
NOTE BOOK	
NO.	

DATE	
BY	
SURVEYED	
PLOTTED	
TEMPLATE	
AREAS CHECKED	
ORIGINAL SURVEY	
NOTE BOOK	
NO.	

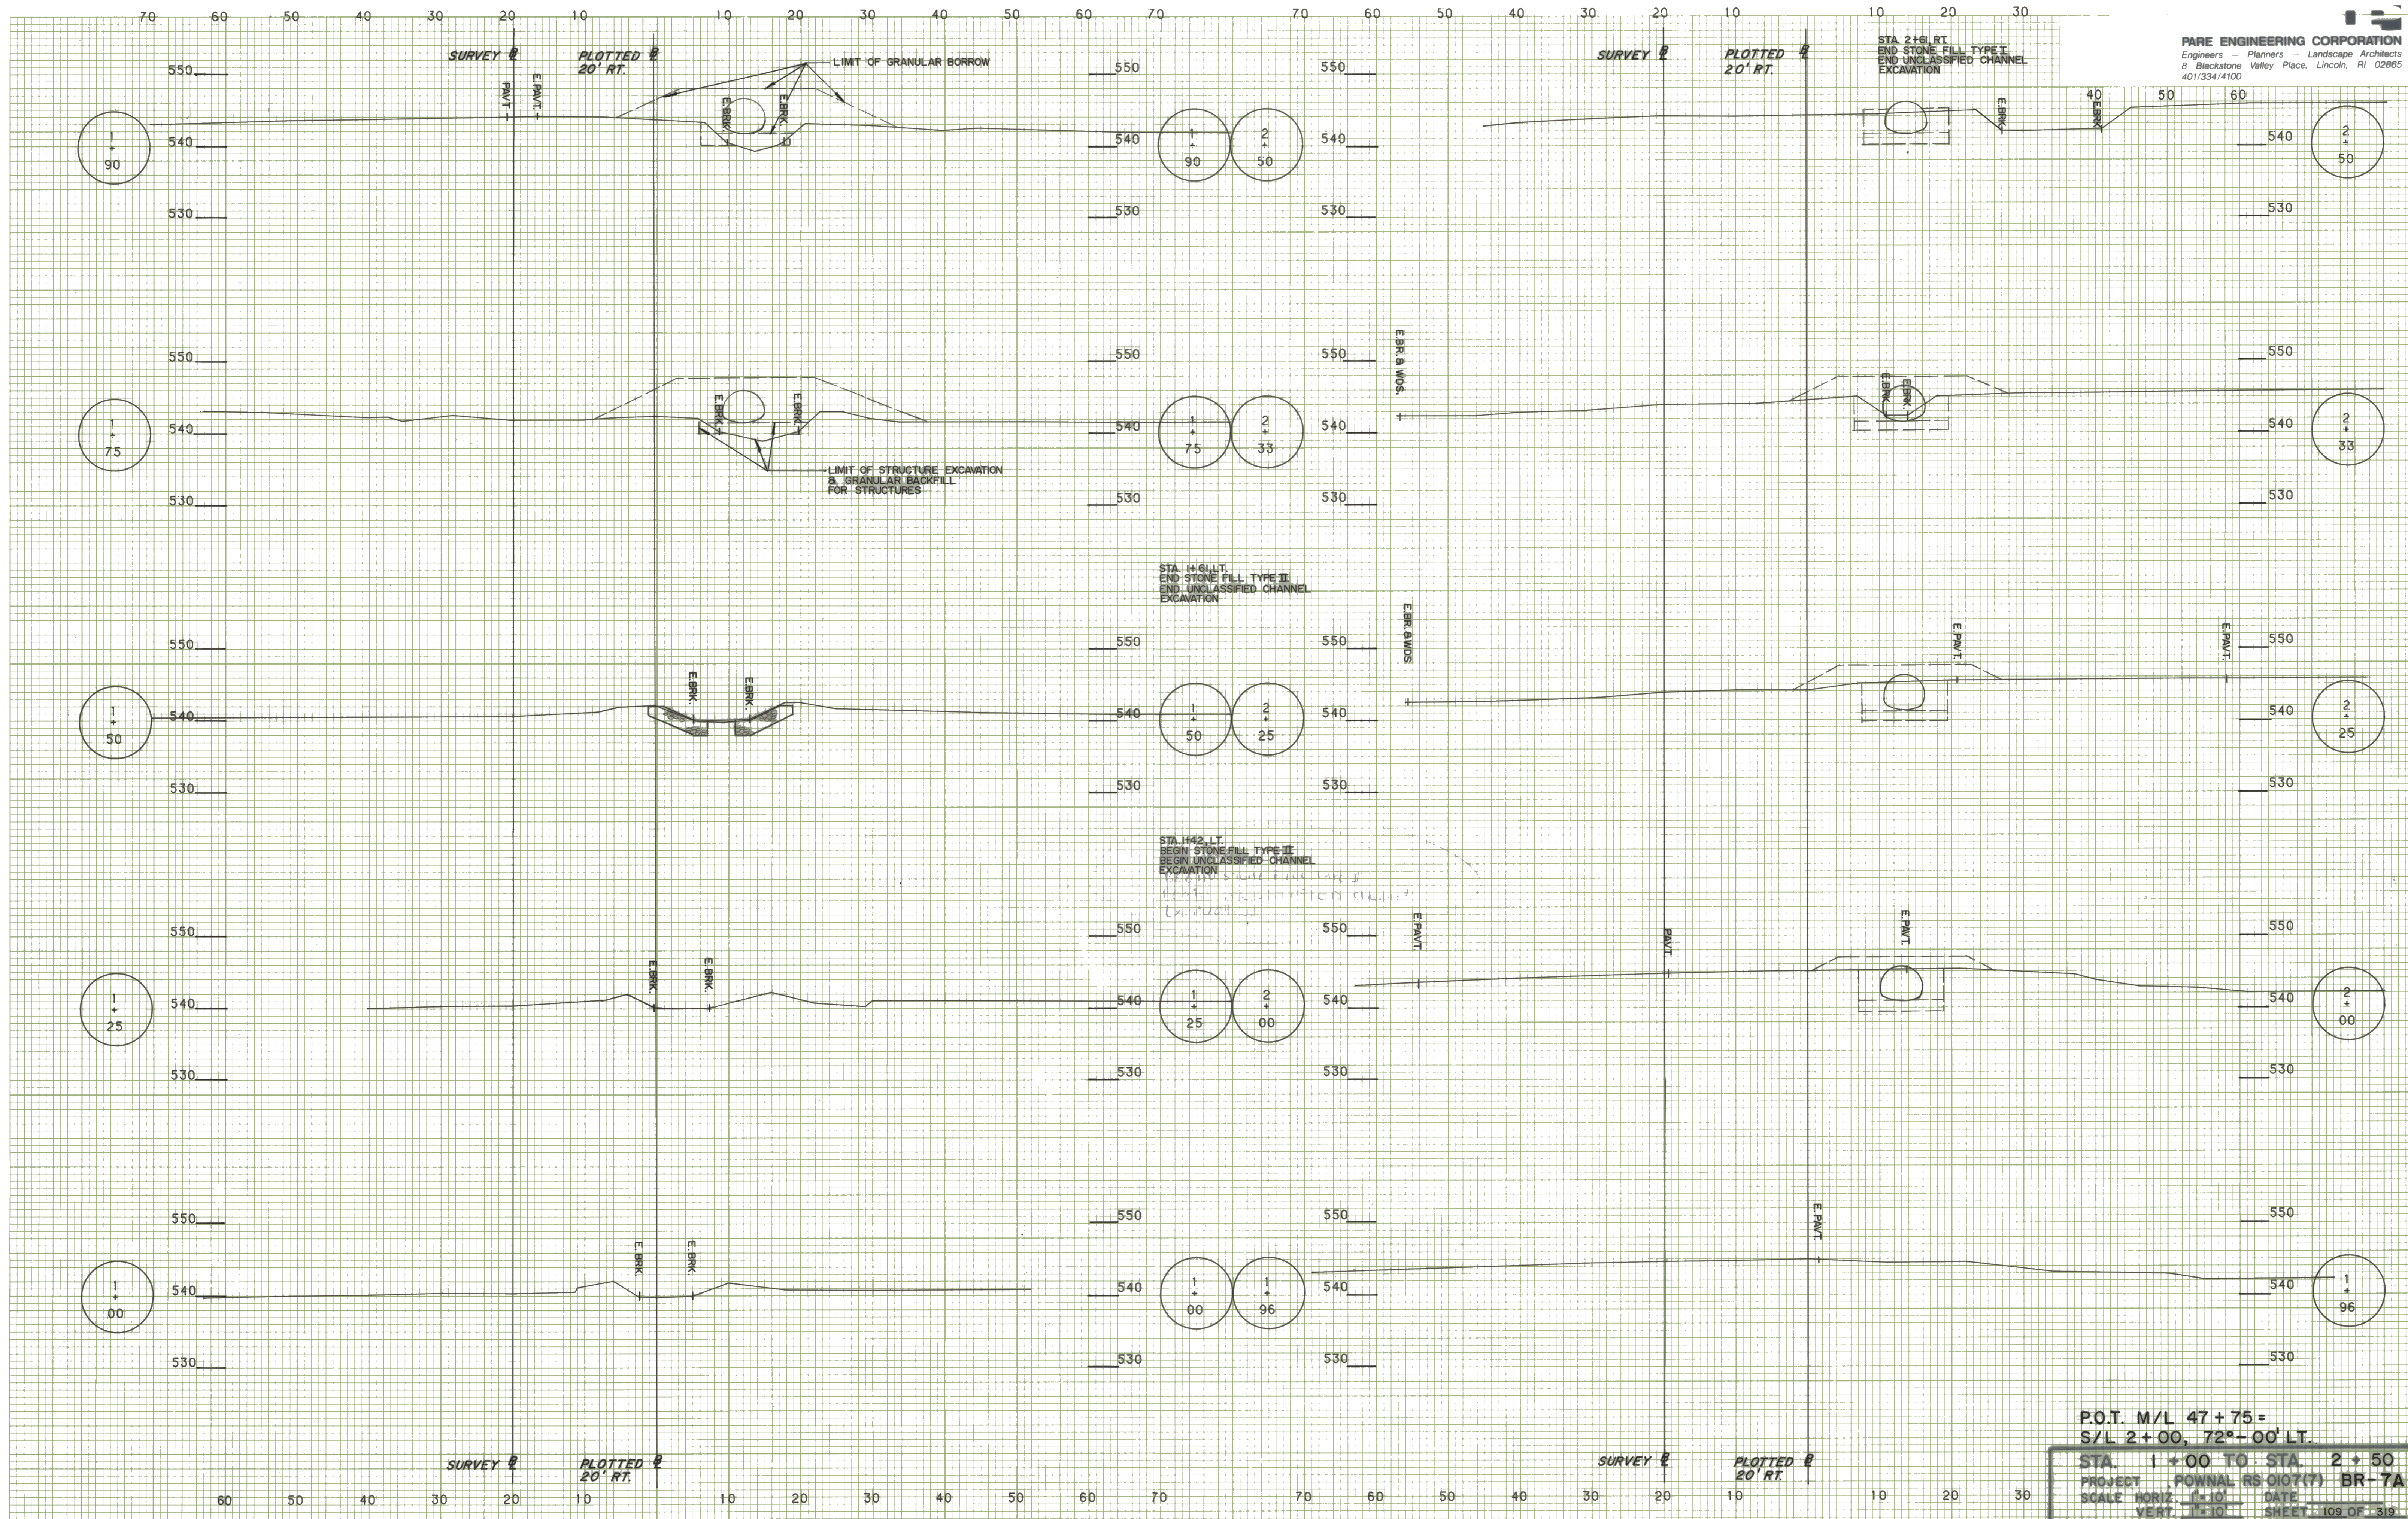

P.O.T. M/L 47+75 =  
 S/L 2+00, 72°-00' LT.  
 STA. 1+00 TO STA. 2+50  
 PROJECT: FOWNAL RS 010(7) BR-7A  
 SCALE: HORIZ. 1"=10' DATE: \_\_\_\_\_  
 VERT. 1"=10' SHEET: 109 OF 319