


DATE	
BY	
SURVEYED	
PLOTTED	
NOTE BOOK	
AREAS CHECKED	
NO.	

DATE	
BY	
SURVEYED	
PLOTTED	
NOTE BOOK	
AREAS CHECKED	
NO.	

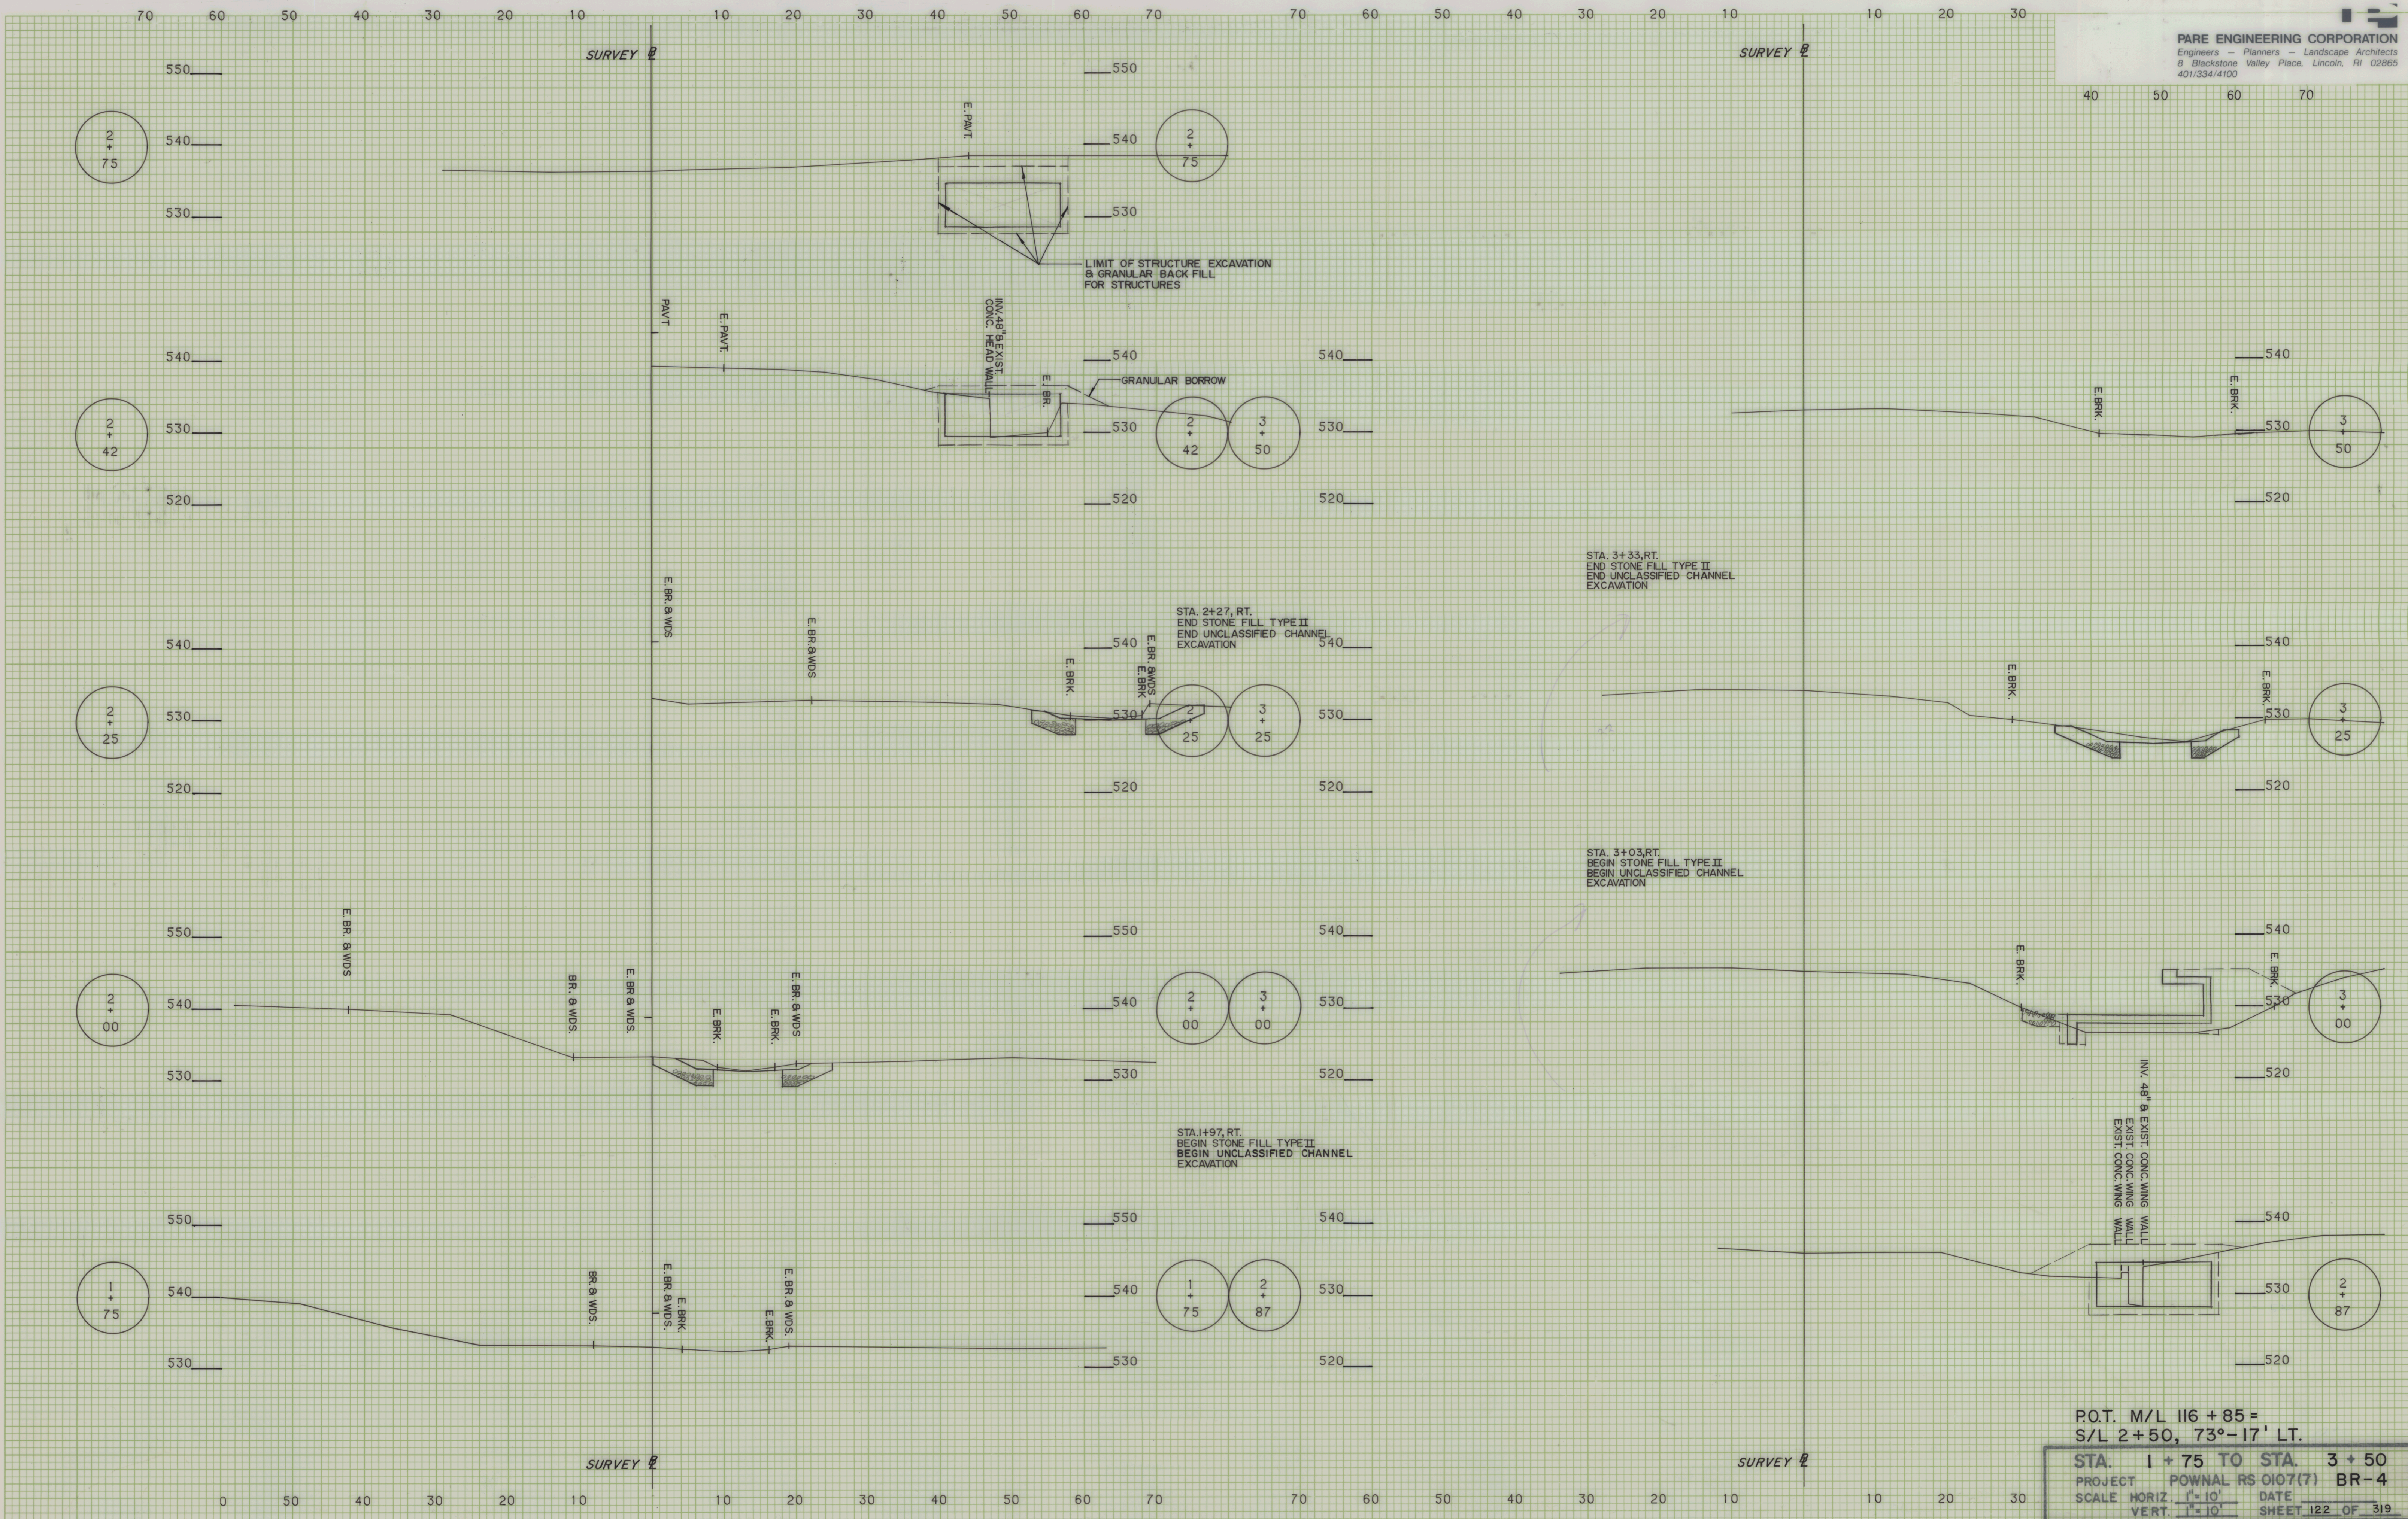

P.O.T. M/L 116 + 85 =  
 S/L 2 + 50, 73°-17' LT.  
**STA. 1 + 75 TO STA. 3 + 50**  
 PROJECT POWNAL RS 0107(7) BR-4  
 SCALE HORIZ. 1"=10' DATE \_\_\_\_\_  
 VERT. 1"=10' SHEET 122 OF 319