


DATE	BY	SURVEYED	PLOTTED	FINAL
		NO. BOOK	NO. BOOK	NO.
		AREAS CHECKED	AREAS CHECKED	

DATE	BY	SURVEYED	PLOTTED	ORIGINAL
		NO. BOOK	NO. BOOK	NO.
		AREAS CHECKED	AREAS CHECKED	

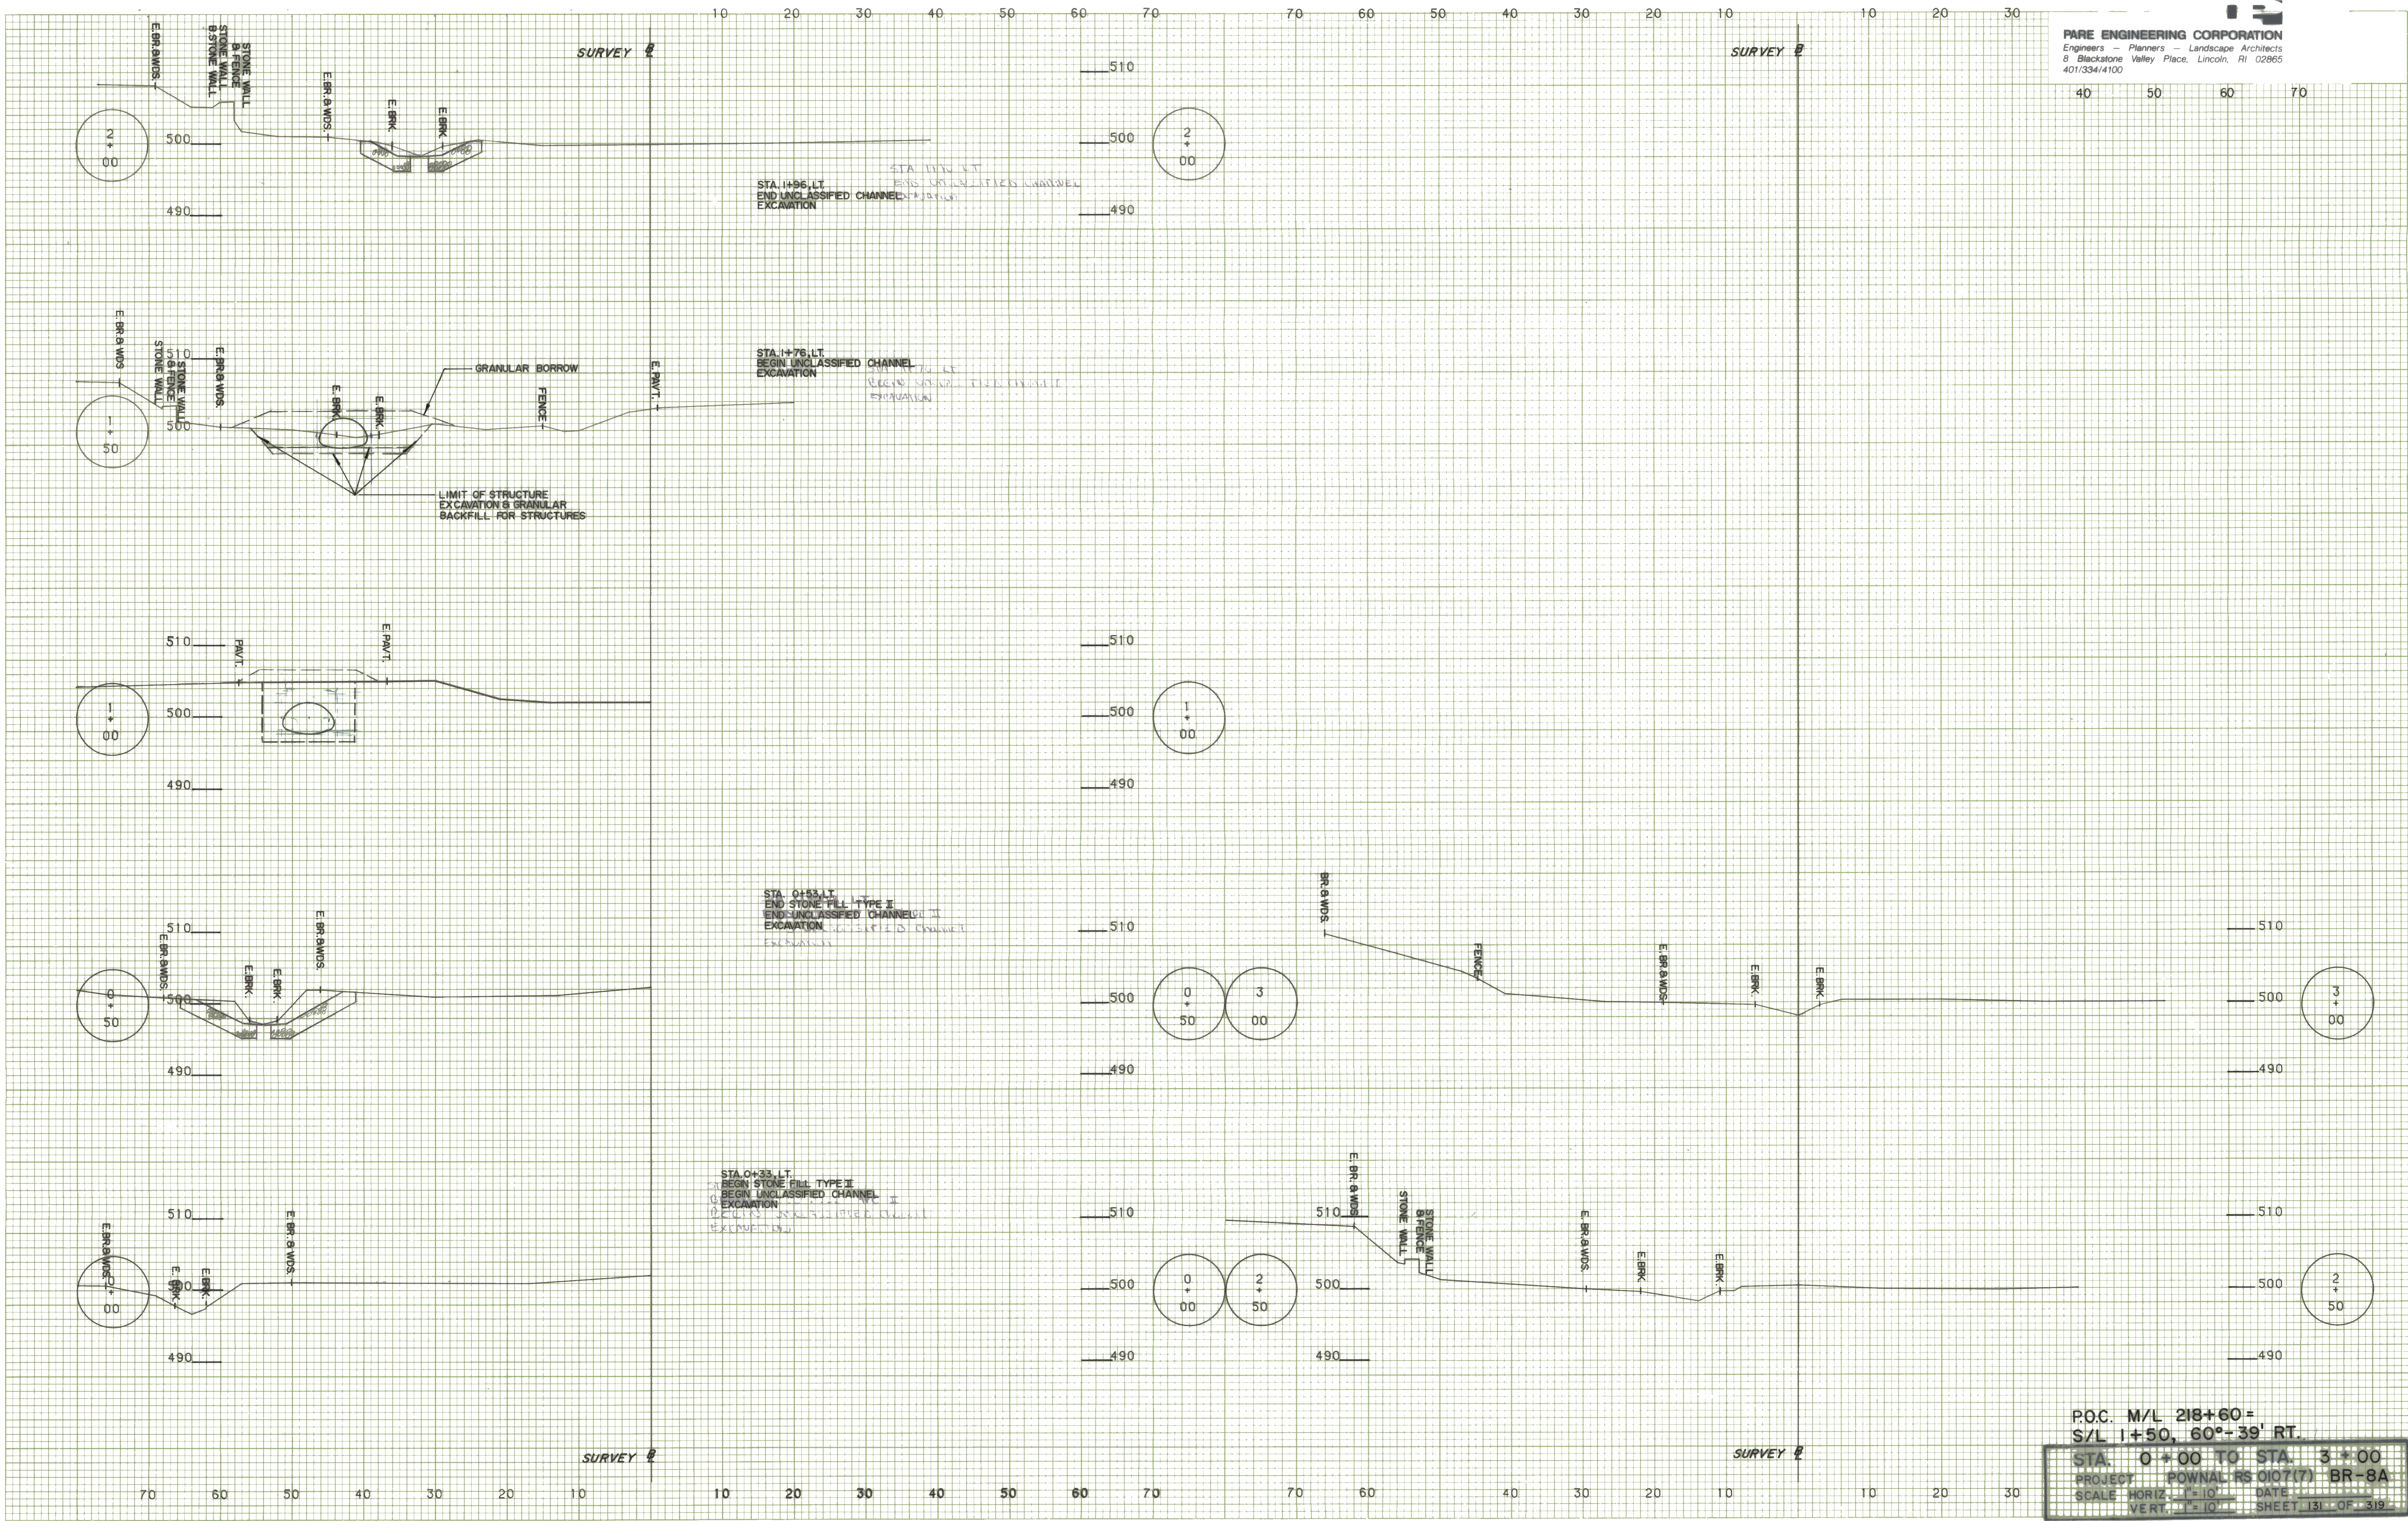

P.O.C. M/L 218+60 =
 S/L 1+50, 60°-39' RT.
 STA. 0+00 TO STA. 3+00
 PROJECT: POWNAL RS 0107(7) BR-8A
 SCALE: HORIZ. 1"=10' VERT. 1"=10'
 SHEET 131 OF 319