PARE ENGINEERING CORPORATION
Engineers — Planners — Landscape Architects
8 Blackstone Valley Place, Lincoln, RI 02865
401/334/4100

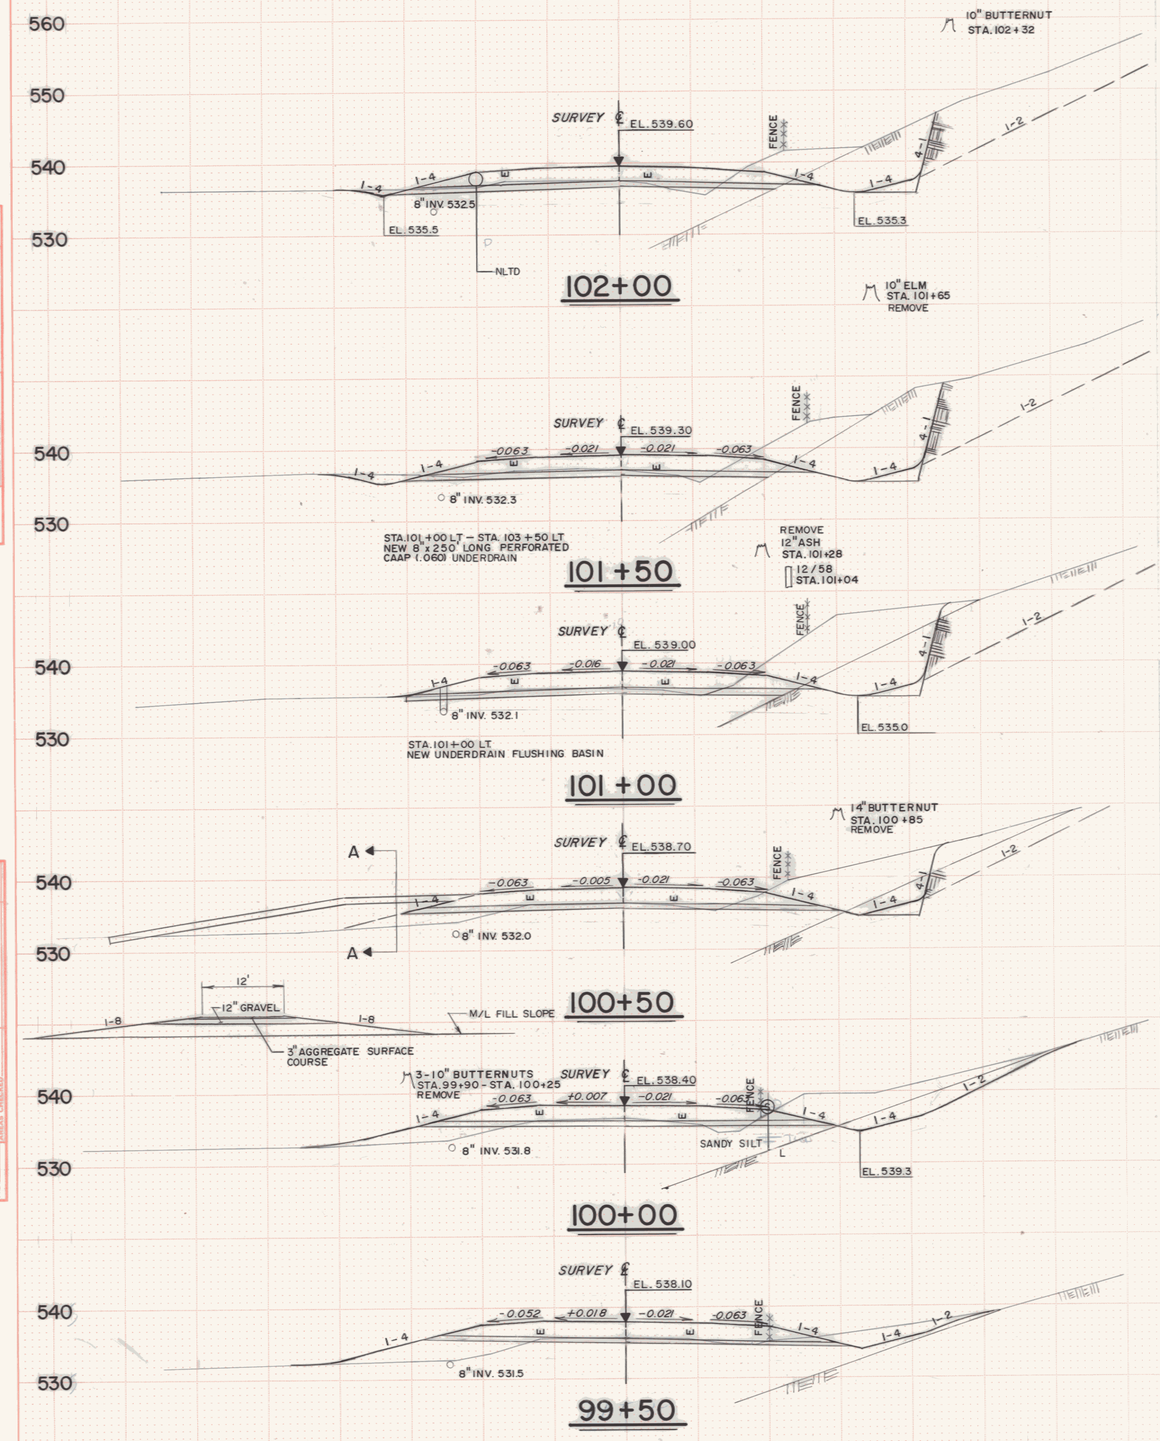

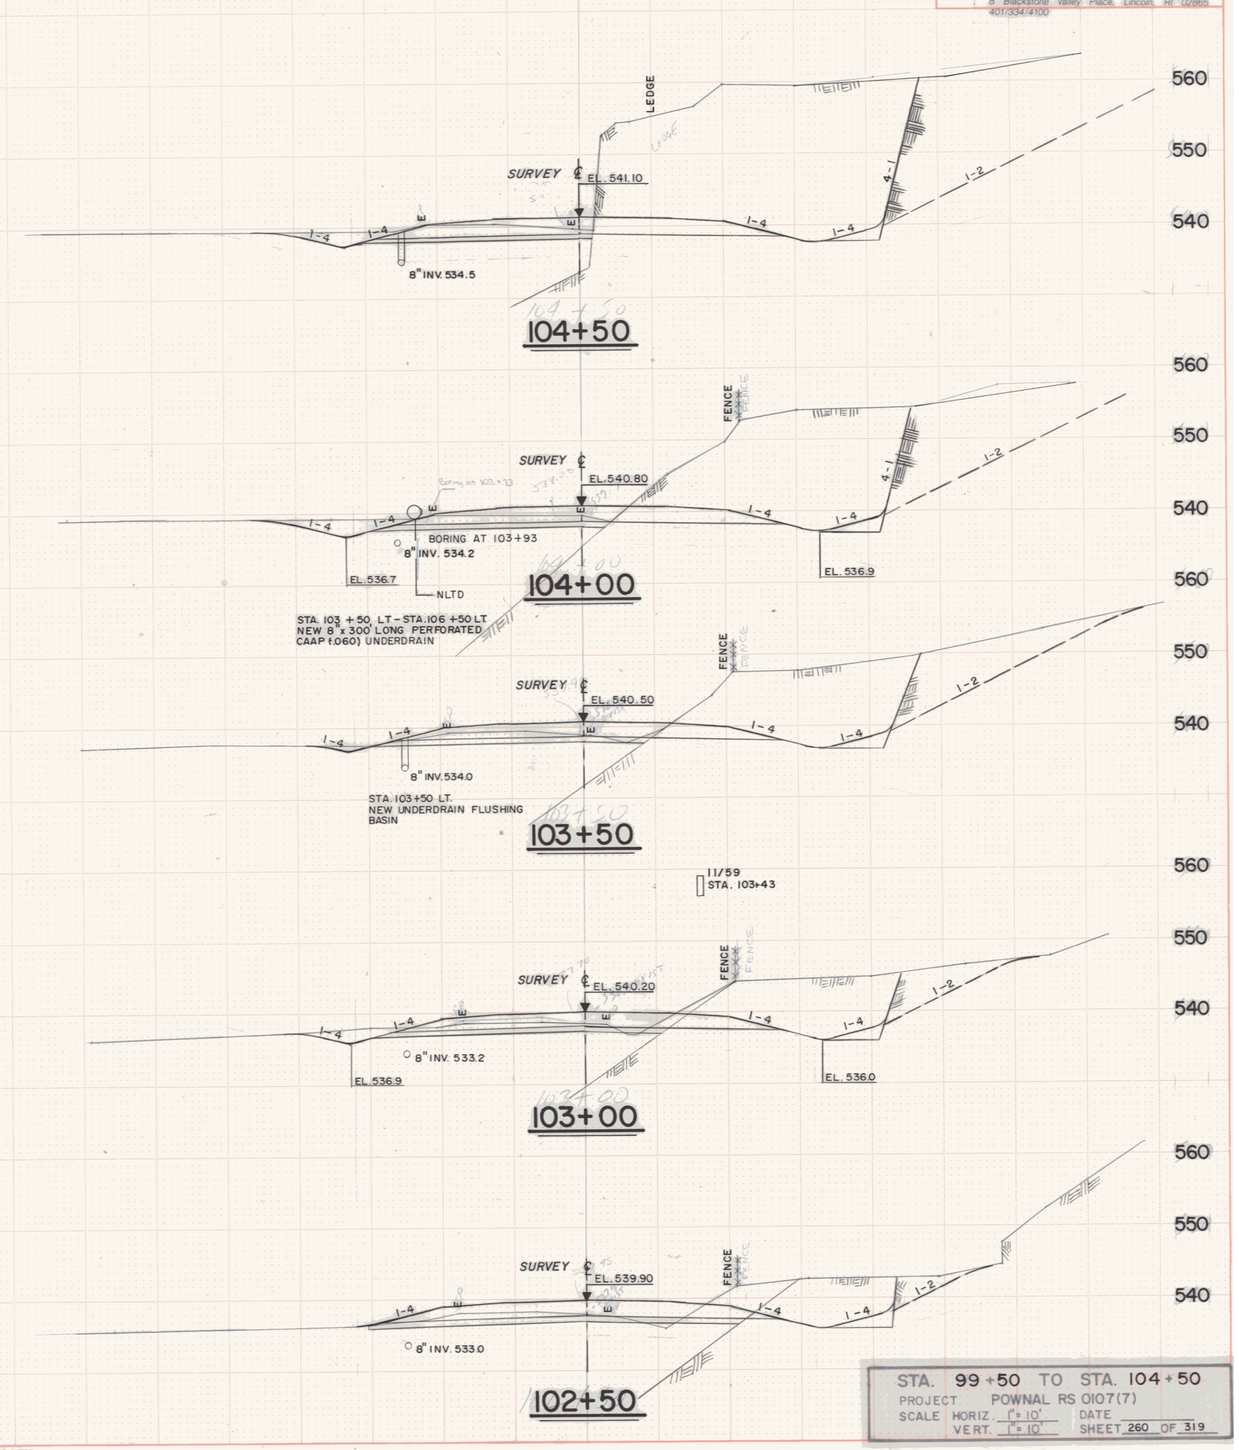

STA. 99+50 TO STA. 104+50	
PROJECT POWNAL RS 0107(7)	
SCALE HORIZ. 1"=10'	DATE
VERT. 1"=10'	SHEET 260 OF 319

FINAL SURVEY — SURVEYED, PLOTTED, TEMPLATE, AREAS, AREAS CHECKED, NOTE BOOK, NO., BY, DATE

ORIGINAL SURVEY — SURVEYED, PLOTTED, TEMPLATE, AREAS, AREAS CHECKED, NOTE BOOK, NO., BY, DATE

HIGHWAY FEDERAL AID SHEET
PLATE 3-FULL CROSS SECTION-FULL DOT
TELFORD
PRINTED IN U.S.A.