PARE ENGINEERING CORPORATION
Engineers — Planners — Landscape Architects
8 Blackstone Valley Place, Lincoln, RI 02865
401/334/4100

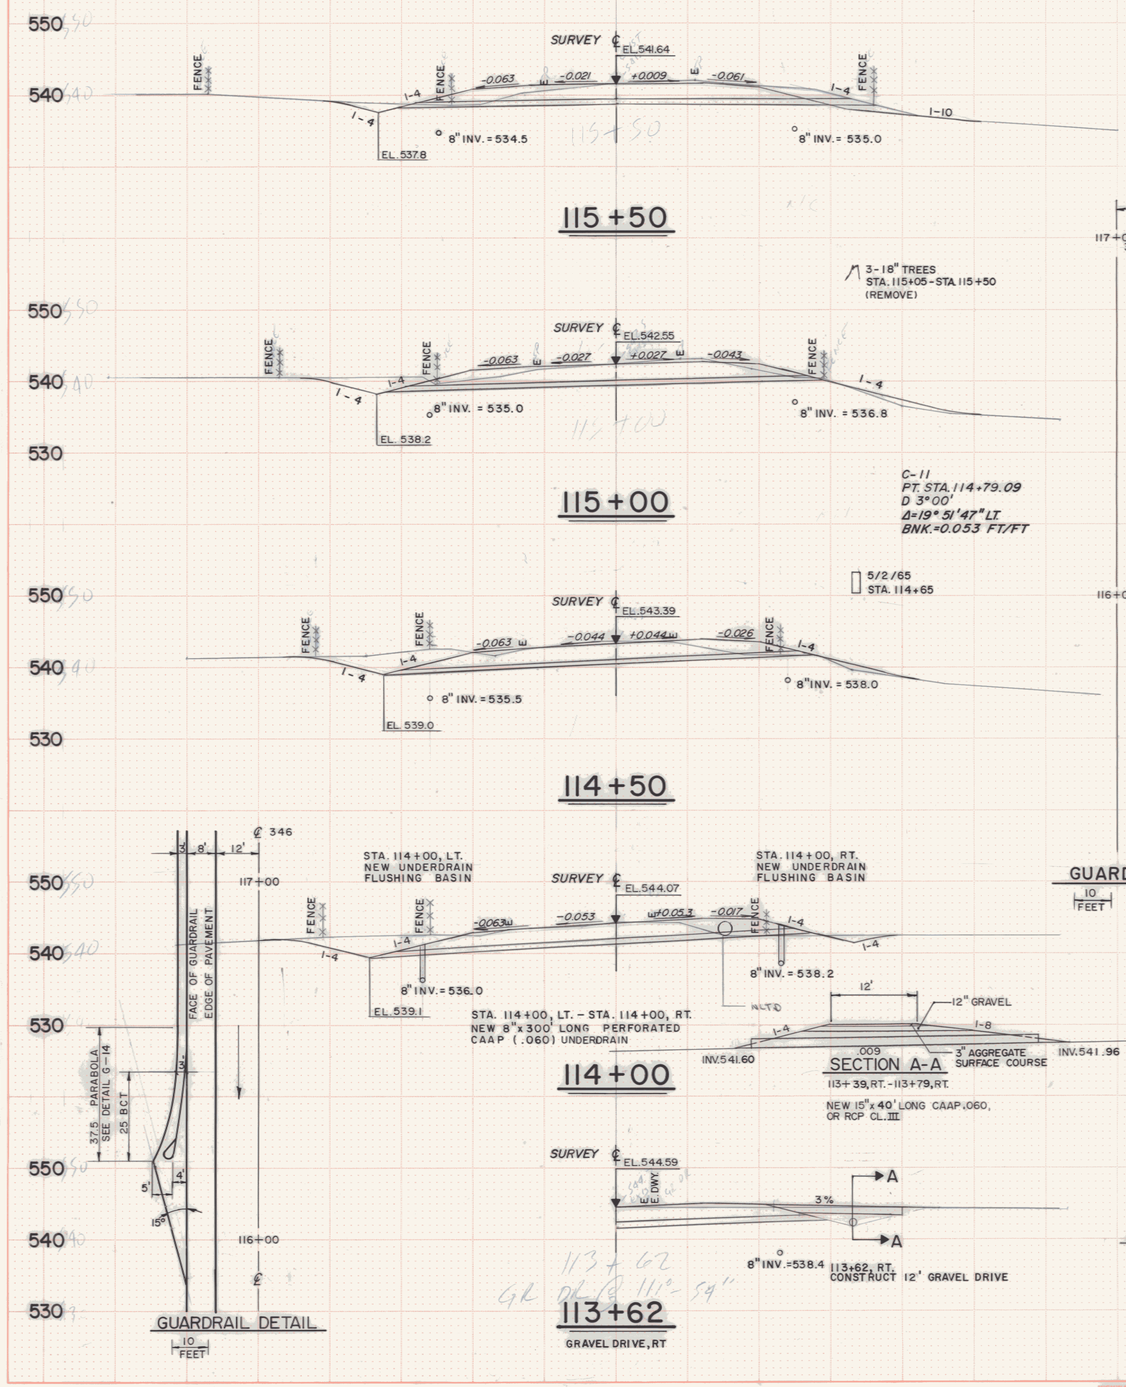

STA. 113+60 TO STA. 117+35
PROJECT POWNAL RS 0107(7)
SCALE HORIZ. 1" = 10' DATE
VERT. 1" = 10' SHEET 263 OF 319

PLATE 3-FULL CROSS SECTION-FULL DOT