PARE ENGINEERING CORPORATION
Engineers — Planners — Landscape Architects
8 Blackstone Valley Place, Lincoln, RI 02865
401/334/4100

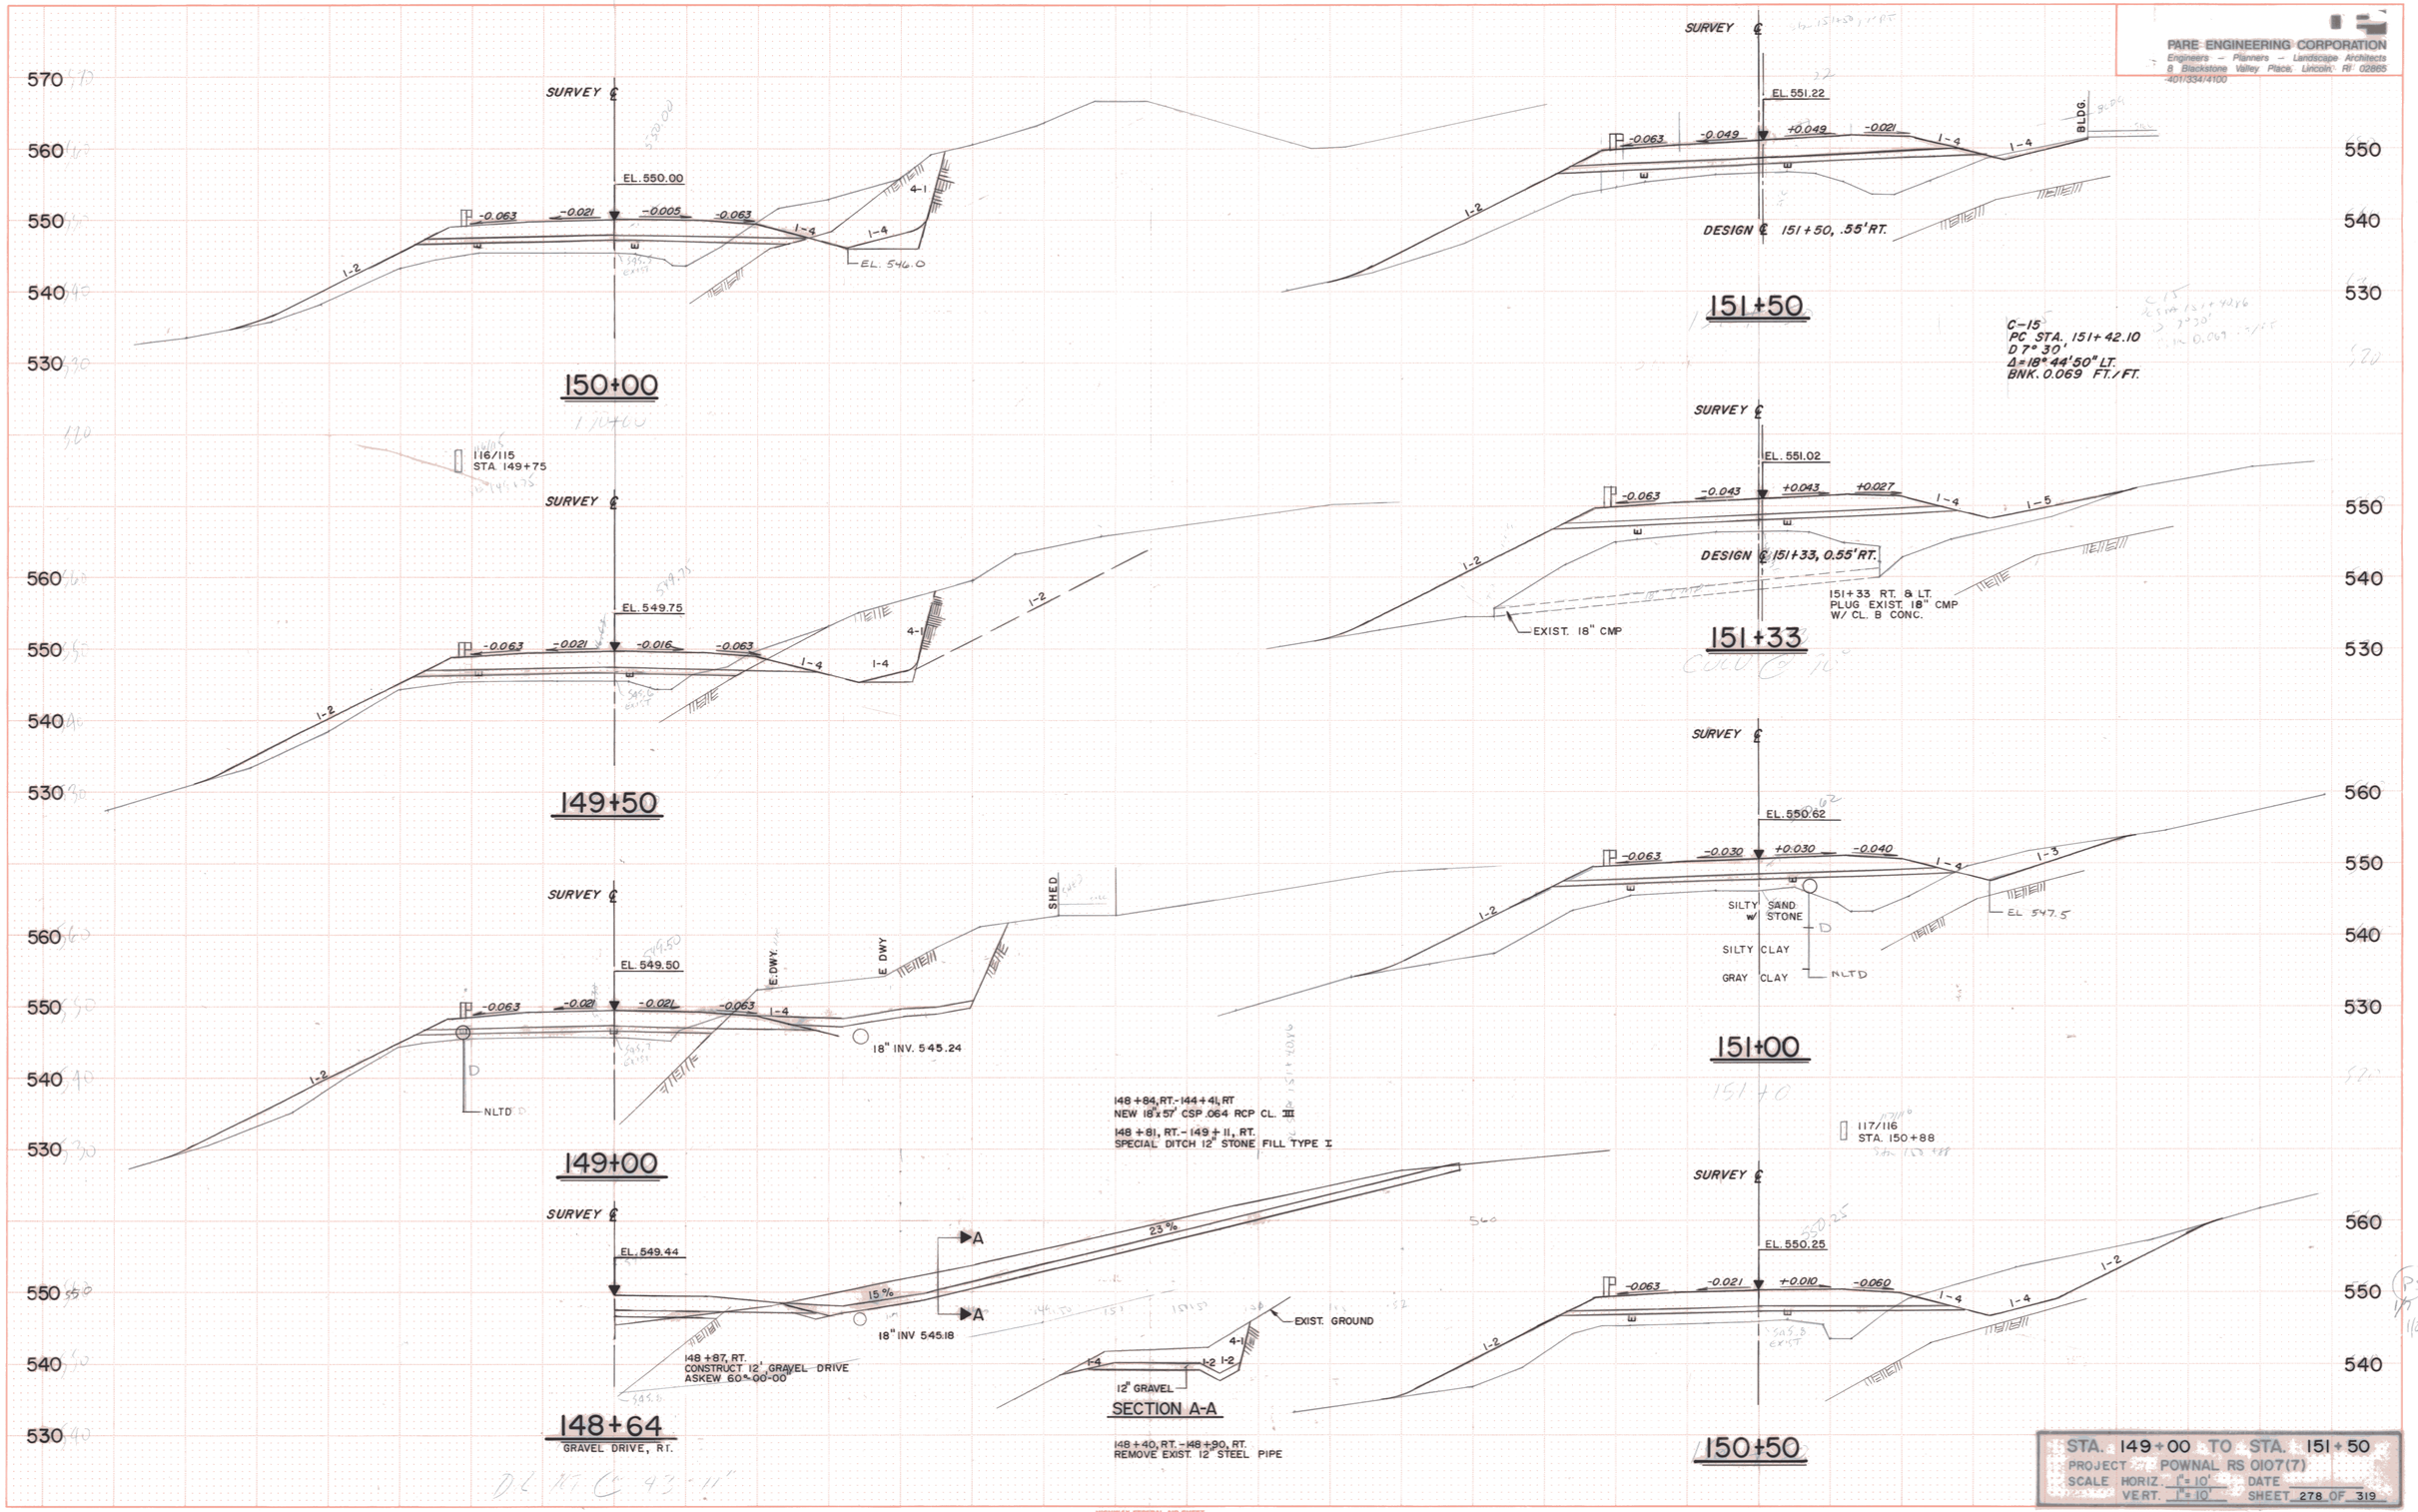

FINAL SURVEY	
SURVEYED	
PLOTTED	
TEMPLATE	
AREA	
AREAS CHECKED	
NOTE BOOK	
NO.	
BY	DATE

ORIGINAL SURVEY	
SURVEYED	
PLOTTED	
TEMPLATE	
AREA	
AREAS CHECKED	
NOTE BOOK	
NO.	
BY	DATE

STA. 149+00 TO STA. 151+50
PROJECT POWNAL RS 0107(7)
SCALE HORIZ. 1" = 10' DATE
VERT. 1" = 10' SHEET 278 OF 319

HIGHWAY FEDERAL AID SHEET
PLATE 3-FULL CROSS SECTION-FULL DOT
WITLEDGE