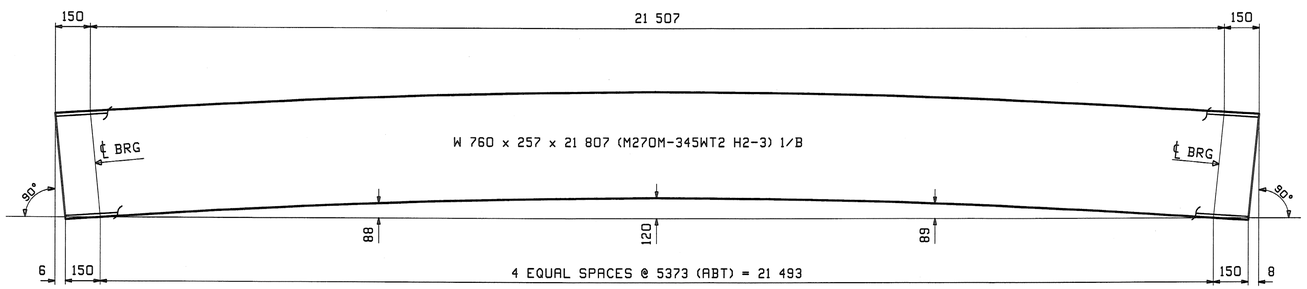

CAMBER DIAGRAM FOR 1S1 THRU 2S4

NOTES:

1. FOR GENERAL NOTES SEE DRAWING GN1.
2. H2-3 DENOTES MATERIAL SUBJECT TO CHARPY V-NOTCH TEST AT H FREQ. FOR ZONE 2

REV.	DATE	REMARKS	DWN	CHK	APVL	SHOP
0					11-10-08	

MATERIAL:	SURFACE PREP. & PAINT:	HOLES:	SHOP BOLTS:
M270M-345W (UN)	AS NOTED ON GN1		

DESCRIPTION: CAMBER DIAGRAM

CASCO BAY STEEL STRUCTURES, INC.
75 SPRING HILL ROAD SACO, MAINE 04072
PHONE (207) 282-7360 FAX. (207) 282-1179
TENSOR 2830

STRUCTURE:	ROUTE NO: TH 50, CL 3 BRIDGE NO: BR 34 COUNTY OF ORANGE	DRAWN: JTB	DATE: 10/14
		CHKD: DBH	DATE: 10/28
LOCATION:	TOWN OF CORINTH	JOB NO.	DWG NO.
PROJ NO.	STP BRO 1447(22) (RE-ADVERTISED)	380	C1
CUSTOMER:	VERMONT AOT		REV. △

RECEIVED
CK'D BY LJS CK'D BY RST
NOV 14 2008
RESUBMIT ____ APPROVED ✓
OPW DATE 11/25/08

046 SS

JTB Tue Oct 28 15:41:08 EST 2008 /users/jobs/2830/C1.Rev0