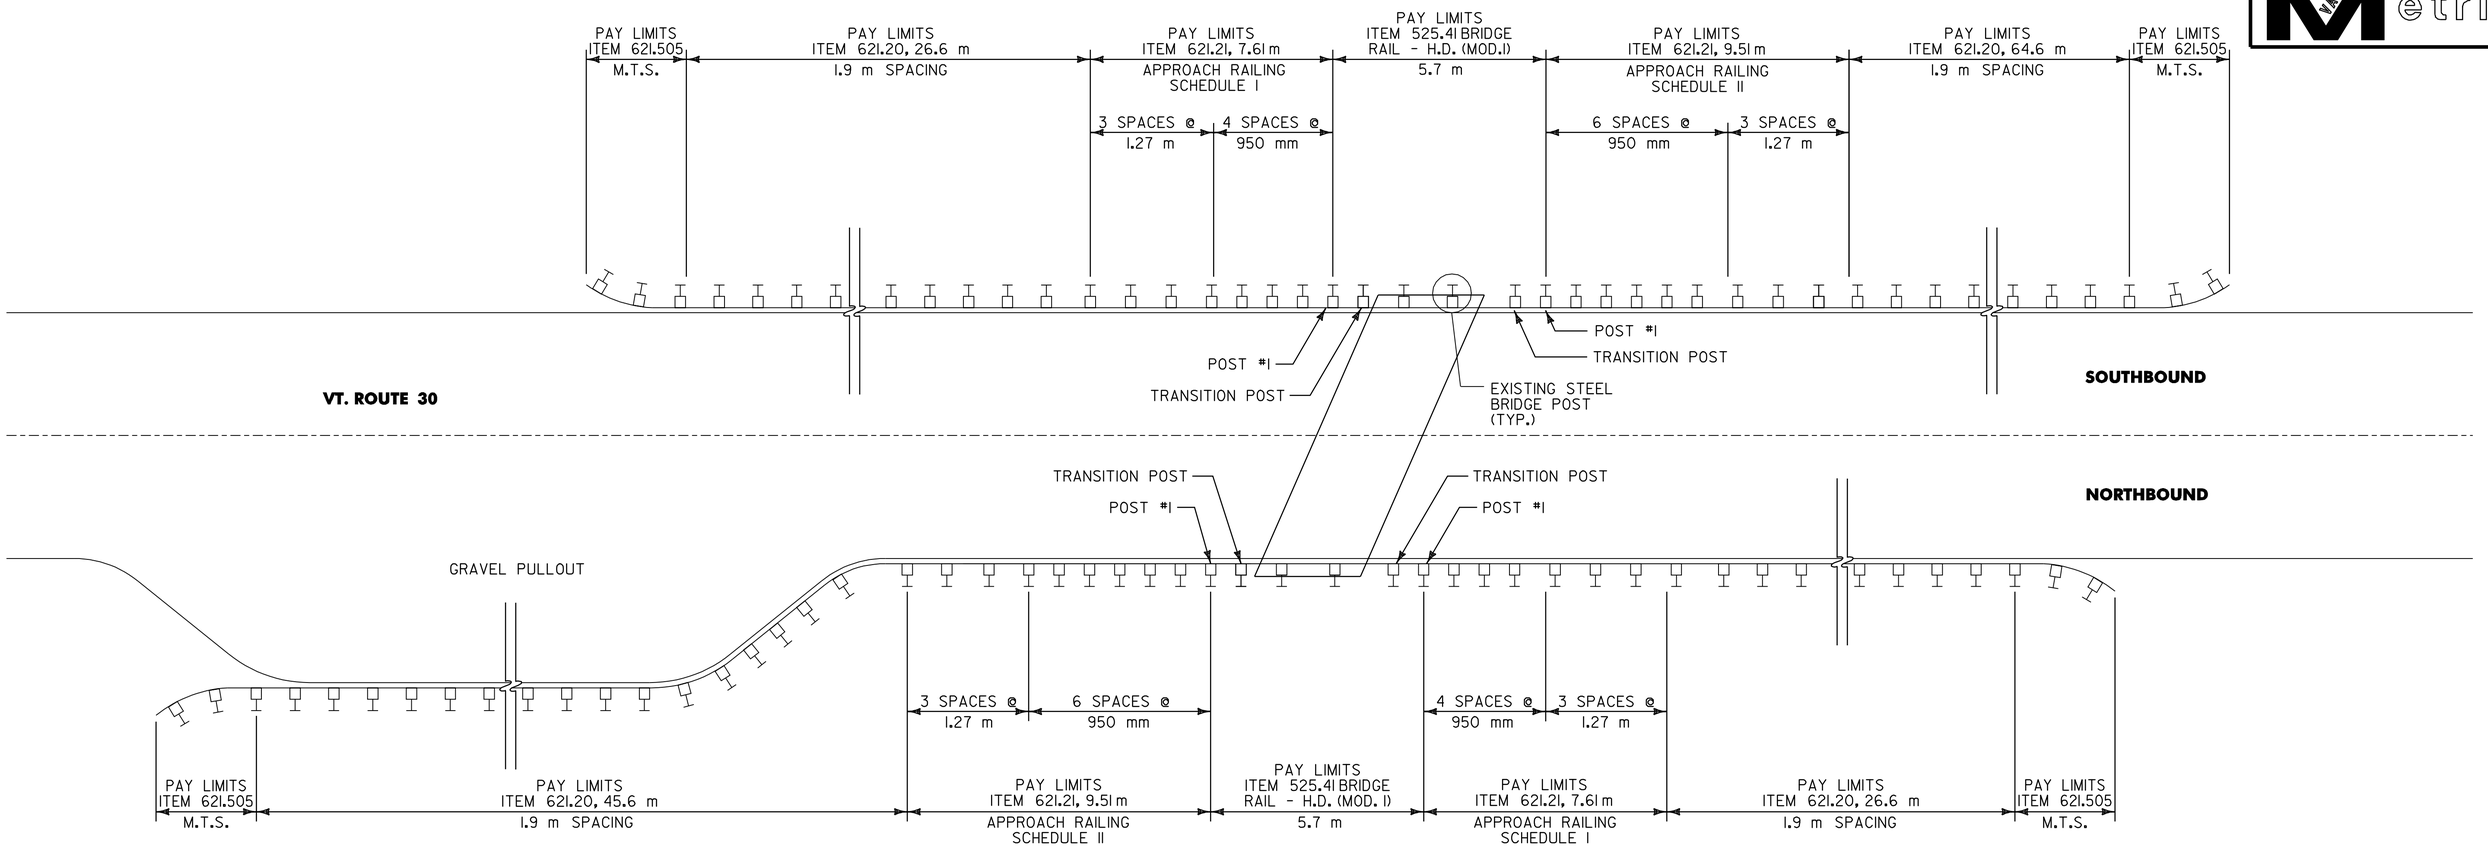

BR 63 RUPERT MM 0.740 = STA. 1+190.915

NOT TO SCALE

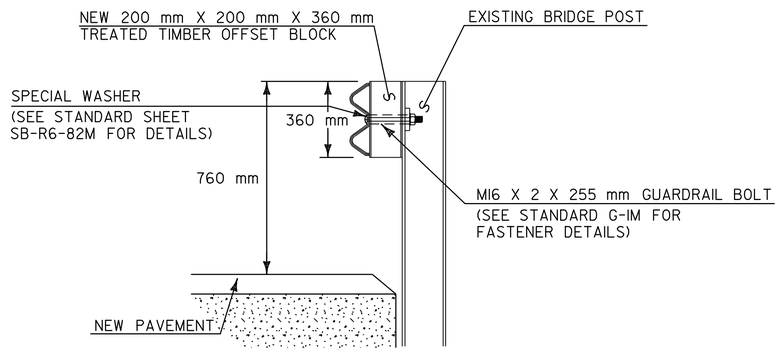

BR 63 BRIDGE POST DETAIL

NOT TO SCALE

DATUM
VERTICAL N/A
HORIZONTAL N/A

BRIDGE DETAIL SHEET 3

SURVEYED BY N/A DATE N/A
DRAWN BY C.A.K. DATE 4/01
SQUAD LEADER T.P.K.
DESIGN FILE NO. /pave/00b048/pb048.dgn
IPARM FILE pb048bd3.i DATE PLOTTED $DATE$
PROJ. NAME RUPERT - PAWLET
PROJ. NO. STP 2133(I)S
SHEET 31 OF 40 SHEETS