STATE OF VERMONT
AGENCY OF TRANSPORTATION

TRAFFIC SIGN SUMMARY SHEET 1

VAOT Metric

KILOMETER MARKER, STATION, OR SIGN NUMBER	SIGN LEGEND	SIGN DIMENSIONS EA	WIDTH (mm)	HEIGHT (mm)	NEW & SALVAGED SIGNS "A"	"A" MOD.	SALV SIGN	SALV TIS	EXIST POST RETAIN	EXIST POST SALVAGE	NEW SIGN POSTS NO. OF POSTS	FLANGED CHANNEL kg/m 1.7	3.0	4.5	~~SQUARE STEEL (mm) kg/m 44 3.4~~	~~50 3.9~~	~~63 5.0~~	ANCHOR	SLEEVE	TUBULAR ALUMINUM Ø (mm) kg/m 75 1.9	100 2.5	100 MOD 2.5	FOUND-ATION	TUBULAR STEEL Ø (mm) kg/m 75 11.3	89 13.4	100 16.1	125 21.7	W-SHAPE STEEL FTG. SIZE 600 mm	750 mm	WEIGHT	POST SIZE	SIGN FRAME REQUIRED	REMARKS	SIGN DETAIL DETAIL ON SHEET NUMBER	STD. SHEET NUMBER
WAITSFIELD: 7+293 RT		1	300	900	0.27						+			~~X~~		X																		BACK-TO-BACK		E-107
7+299 RT		1	300	900	0.27						1			X 3.66m		X																				E-107
~~7+300 LT~~	~~ 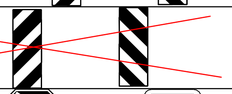 ~~	~~1~~	~~300~~	~~900~~	~~0.27~~						~~+~~			~~X~~		X																		ELIMINATED, NEW GUARD RAIL SECTION		E-107
~~7+306 LT~~		~~1~~	~~300~~	~~900~~	~~0.27~~						~~+~~			~~X~~		X																				E-107
7+549 LT		1	750	750	0.56		1				1			4.27m X		X																		BACK-TO-BACK		E-143 E-138
7+557 LT		1	600	750	0.45						1			4.27m X		X																				E-141
7+937 LT		1	750	750	0.56						1			4.27m X		X																				E-143
7+951 LT		1	600	750	0.45						1			4.27m X		X																				E-141
7+948 RT		1	600	750	0.45						1			4.27m X		X																				E-141
7+962 RT		1	750	750	0.56		1				1			4.27m X		X																		BACK-TO-BACK		E-143 E-138
8+446 LT		1	750	750	0.56		1				1			4.27m X		X																		BACK-TO-BACK		E-143 E-138
8+457 LT		1	600	750	0.45						1			4.27m X		X																				E-141
9+216 LT		1	750	750	0.56		1				1			4.27m X		X																		BACK-TO-BACK		E-143 E-138
9+229 LT		1	600	750	0.45						1			4.27m X		X																				E-141
10+327 RT		1	600	750	0.45						1			4.27m X		X																				E-141
10+332 RT		1	750	750	0.56						1			4.27m X		X																				E-143
											13	m	m	m ~~73.6~~	m	m ~~73.6~~	m		EA	kg	kg	kg		kg	kg	kg	kg								
TOTALS					m² ~~7.14~~ 6.6	m²	EA 4	m²						m ~~73.6~~ 54.9m		m ~~73.6~~				kg			EA	kg				EA	EA	kg					

FINAL POST LENGTHS ARE TO BE DETERMINED IN THE FIELD. POST SIZES ARE COMPUTED BASED ON INFORMATION FURNISHED ON THE STANDARD SHEETS AND THE TRAFFIC & SAFETY DIVISION'S "SIGN POST DESIGN GUIDELINE."

PROJECT: WAITSFIELD - MORETOWN	PROJECT NO.: STP 2227(1)S
DESIGN FILE NAME: pave/00b058/00b058.dgn	
IPARM FILE NAME: 00b058tsl.i	PLOT DATE: 23-MAY-2008 12:5
SURVEYED BY: LFW	SURVEY DATE: 7/05
SQUAD LEADER: LFW	DRAWN BY: LFW
	SHEET: 43 OF 54