STATE OF VERMONT
AGENCY OF TRANSPORTATION

TRAFFIC SIGN SUMMARY SHEET

MILEMARKER, STATION, OR SIGN NUMBER	SIGN LEGEND	SIGN DIMENSIONS EA	SIGN DIMENSIONS WIDTH (in)	SIGN DIMENSIONS HEIGHT (in)	NEW & SALVAGED SIGNS "A"	NEW & SALVAGED SIGNS "B"	NEW & SALVAGED SIGNS SALV SIGN	NEW & SALVAGED SIGNS SALV TIS	EXIST POST RETAIN	EXIST POST SALVAGE	NEW SIGN POSTS NO. OF POSTS	FLANGED CHANNEL lb/ft 1.12	FLANGED CHANNEL lb/ft 2.0	FLANGED CHANNEL lb/ft 3.0	SQUARE STEEL (in) lb/ft 1.75	SQUARE STEEL (in) lb/ft 2.0	SQUARE STEEL (in) lb/ft 2.5	ANCHOR	SLEEVE	TUBULAR ALUMINUM Ø (in) lb/ft 3.0	TUBULAR ALUMINUM Ø (in) lb/ft 4.0	TUBULAR ALUMINUM Ø (in) lb/ft 4.0 MOD	TUBULAR STEEL Ø (in) FOUND-ATION	TUBULAR STEEL Ø (in) lb/ft 3.0	TUBULAR STEEL Ø (in) lb/ft 3.5	TUBULAR STEEL Ø (in) lb/ft 4.0	TUBULAR STEEL Ø (in) lb/ft 5.0	W-SHAPE STEEL FTG. SIZE 24"	W-SHAPE STEEL FTG. SIZE 30"	W-SHAPE STEEL WEIGHT	W-SHAPE STEEL POST SIZE	SIGN FRAME REQUIRED	REMARKS	SIGN DETAIL DETAIL IN SHS	SIGN DETAIL DETAIL ON SHEET NUMBER	SIGN DETAIL STD. SHEET NUMBER
												OPTION ITEMS																								
259+91.6 RT	STOCKBRIDGE PITTSFIELD						X				~~1~~ 2					X 28		X																		
	WINDSOR CO RUTLAND CO						X																													
	1000 1419 0000						X																													
	1000 1115 0487						X																													
260+30.7 LT	Guernsey Hollow Rd TH 41	2	66	12	11.00						2					X 24		X															D3-1 GUERNSEY HOLLOW RD TH 41 INSTALL BACK TO BACK		SEE BELOW	
260+35.1 LT	STOP	1	30	30	6.25		~~X~~				1					X 13		X															ORIGINAL SIGN WASHED AWAY BY IRENE			
	1000 1419 0001	1	6	10	0.42																												VD-700 1000 / 1419 / 0001			E-138
260+65.30 LT		1	24	30	5.0						1					X 13		X															SIGN THAT WAS TO BE RETAINED WAS WASHED AWAY BY IRENE			

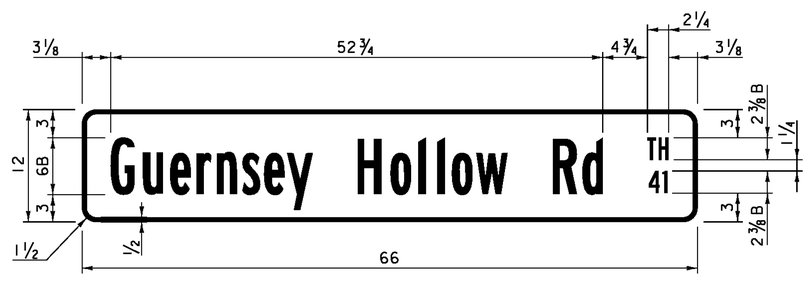

COLORS: LEGEND & BORDER - WHITE (RETROREFLECTIVE)
BACKGROUND - GREEN (RETROREFLECTIVE)

FINAL POST LENGTHS ARE TO BE DETERMINED IN THE FIELD. POST SIZES ARE COMPUTED BASED ON INFORMATION FURNISHED ON THE STANDARD SHEETS AND VTRANS "SIGN POST DESIGN GUIDELINE."
SHS = STANDARD HIGHWAY SIGNS

							FT	FT	FT	FT	FT ~~56.0~~ 78.0	FT		EA	LB	LB	LB		LB	LB	LB	LB			
TOTALS	SF ~~11.42~~ 22.67	SF	EA.	SF			FT			FT ~~56.0~~ 78.0					LB			EA.	LB				EA.	EA.	LB

PROJECT NAME: PITTSFIELD-STOCKBRIDGE
PROJECT NUMBER: STP 022-1(22)S

FILE NAME: s00b122tss.dgn
PROJECT LEADER: C.P.WILLIAMS
DESIGNED BY: G. ROY
TRAFFIC SIGN SUMMARY SHEET

PLOT DATE: 02-SEP-2011
DRAWN BY: G. ROY
CHECKED BY: R. YOUNG
SHEET 24 OF 41