


MATCHLINE A-A TO R.O.W. SHEET 14 OF 15 STA. 14+00

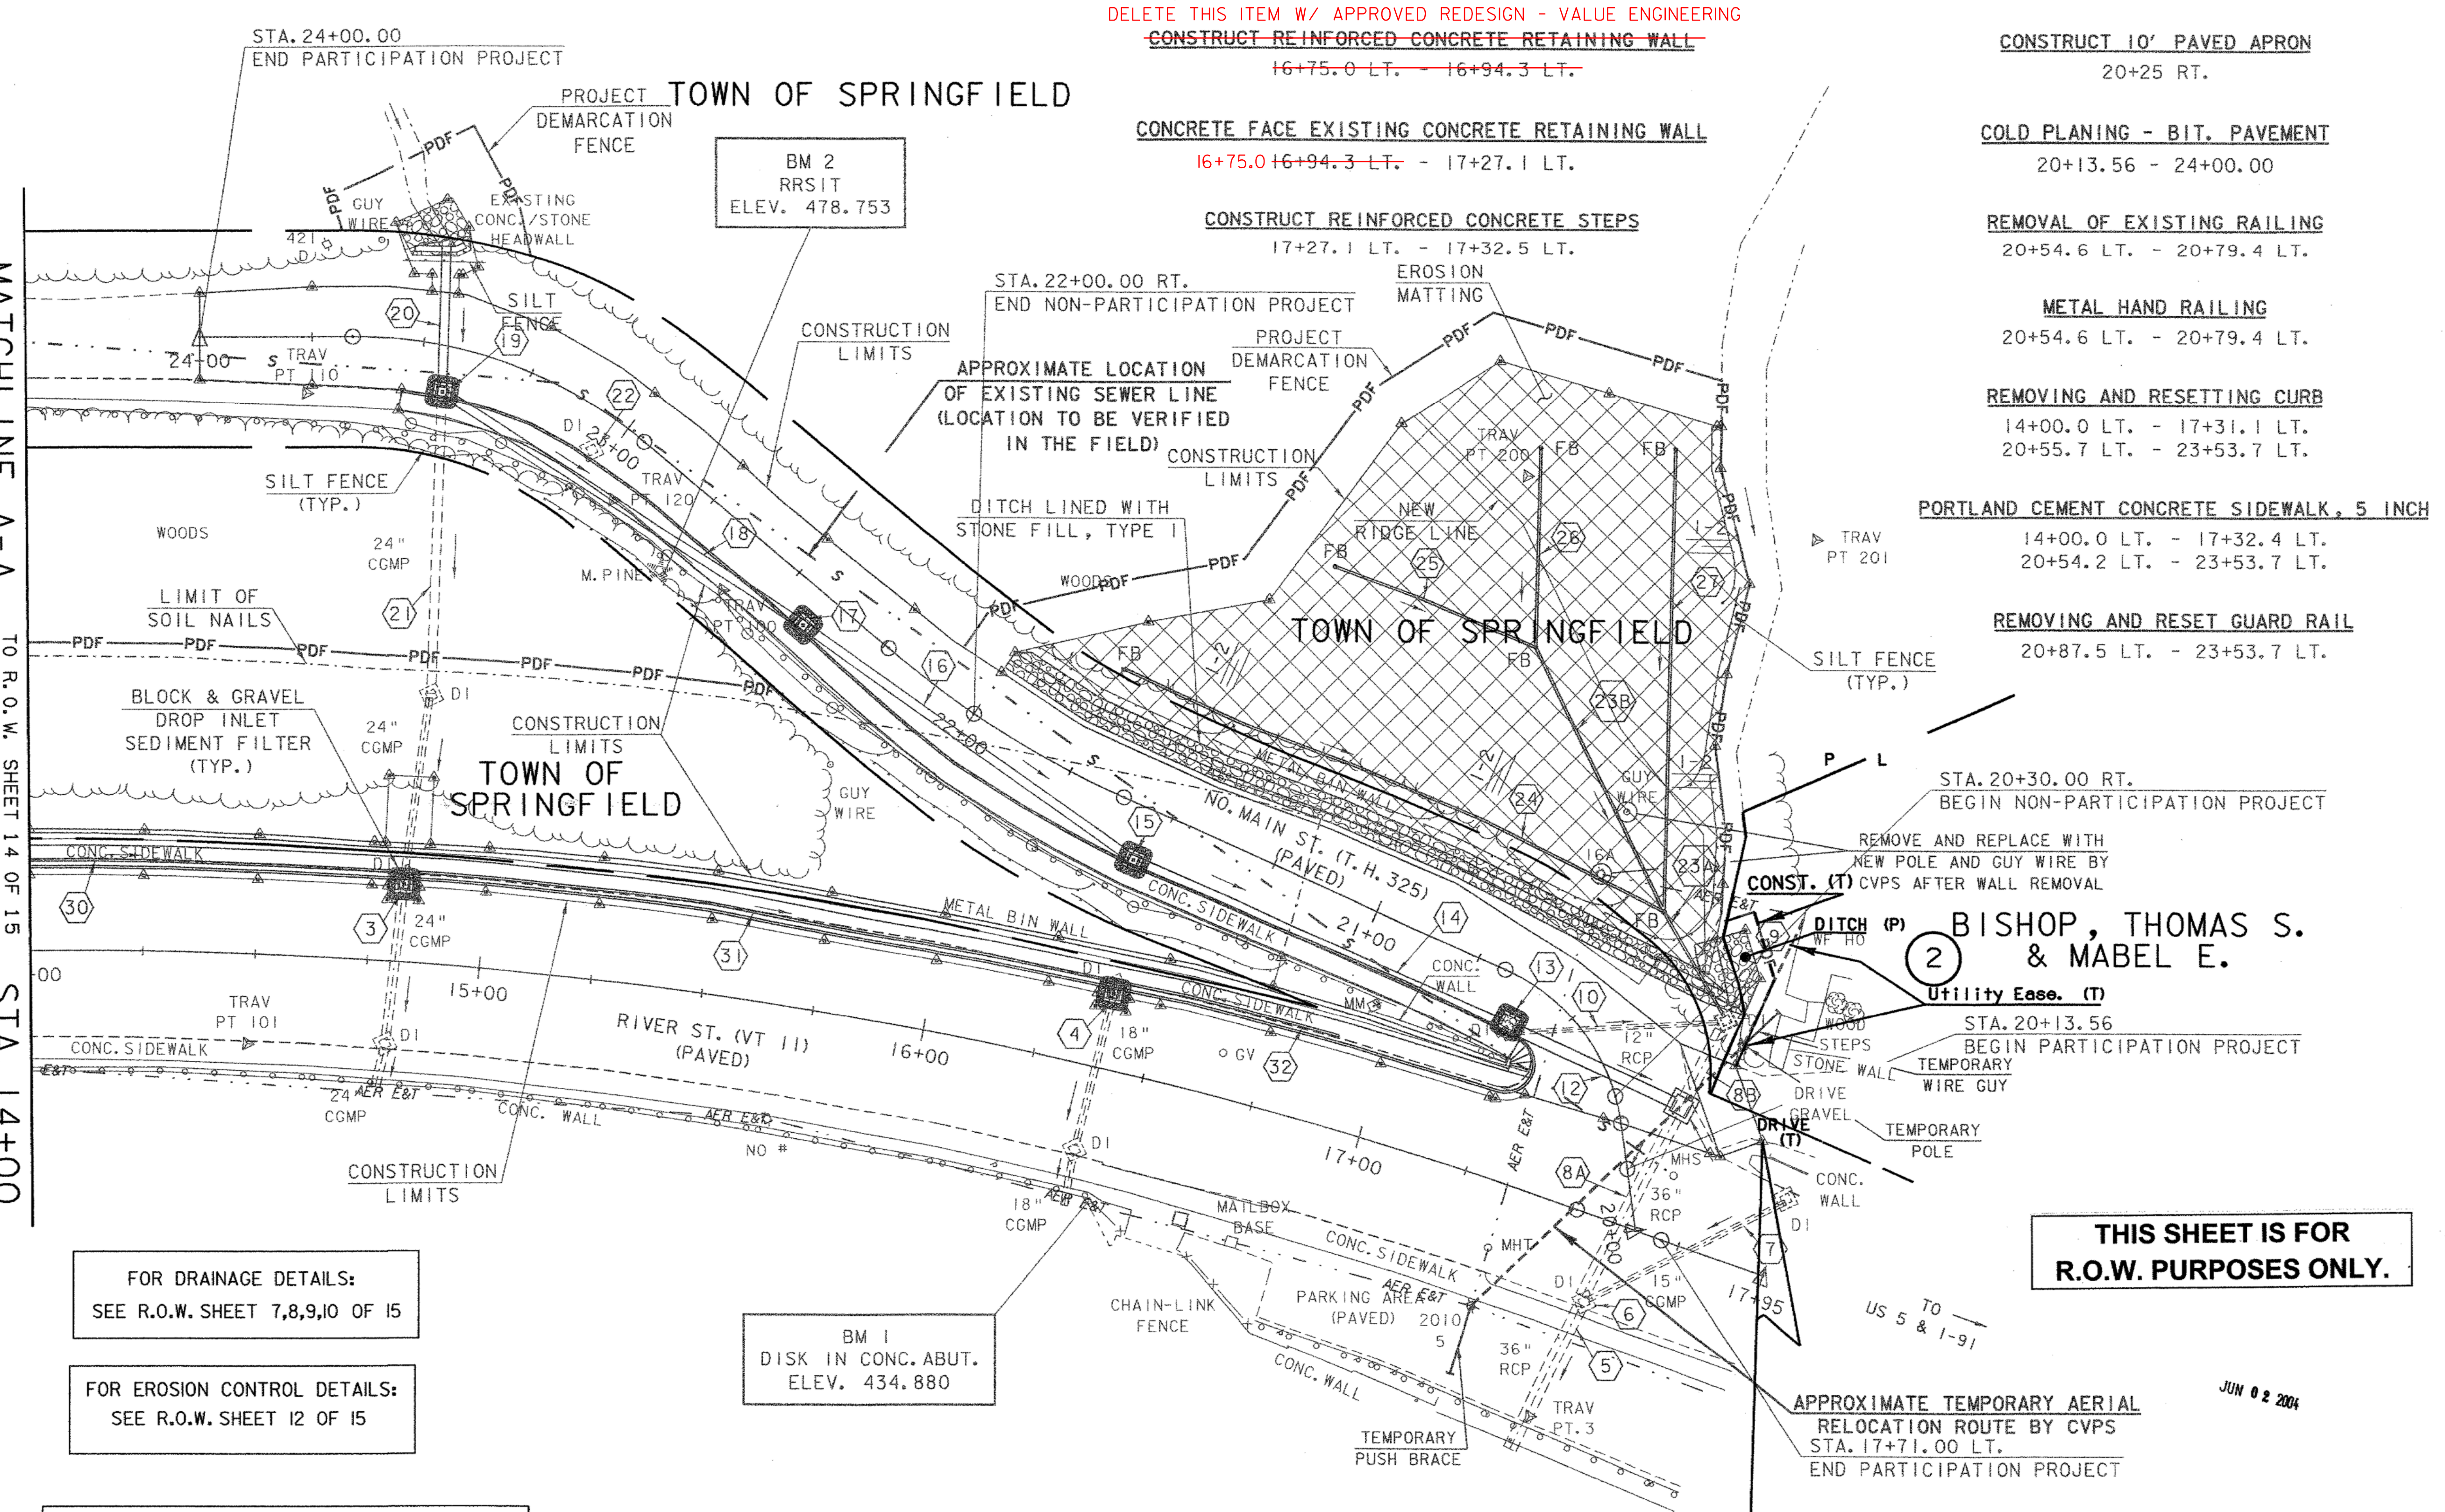

FOR DRAINAGE DETAILS:
SEE R.O.W. SHEET 7,8,9,10 OF 15

FOR EROSION CONTROL DETAILS:
SEE R.O.W. SHEET 12 OF 15

LINES SHOWN ON THIS PLAN AS EXISTING PROPERTY LINES P/L ARE BELIEVED TO BE ACCURATE BUT SHOULD NOT BE RELIED UPON FOR PURPOSES UNRELATED TO THE TOWN OF SPRINGFIELD'S ACQUISITION OF LAND AND RIGHTS FOR THIS PROJECT.

SEE DRAINAGE DETAIL SHEET FOR DRAINAGE PIPE INFORMATION
NOTE: UNDERGROUND UTILITIES ARE NOT SHOWN.

BM 1
DISK IN CONC. ABUT.
ELEV. 434.880

END R. O. W. PROJECT
STP 016-2(10) S STA. 17+85.079
29.9' LT.

SCALE: 1" = 20'-0"
20 0 20

THIS SHEET IS FOR R.O.W. PURPOSES ONLY.

LAYOUT SHEET (2)

PROJECT NAME:	SPRINGFIELD	FILE NAME:	00b124\Structures\sb124102.j	PLOT DATE:	01-JUN-2004
PROJECT NUMBER:	STP 016-2 (10)S	PROJECT MANAGER:	R. WHITCOMB	DRAWN BY:	G. ROY
DESIGNED BY:	G. ROY	CHECKED BY:		SHEET 8 OF 72 SHEETS	

JUN 02 2004