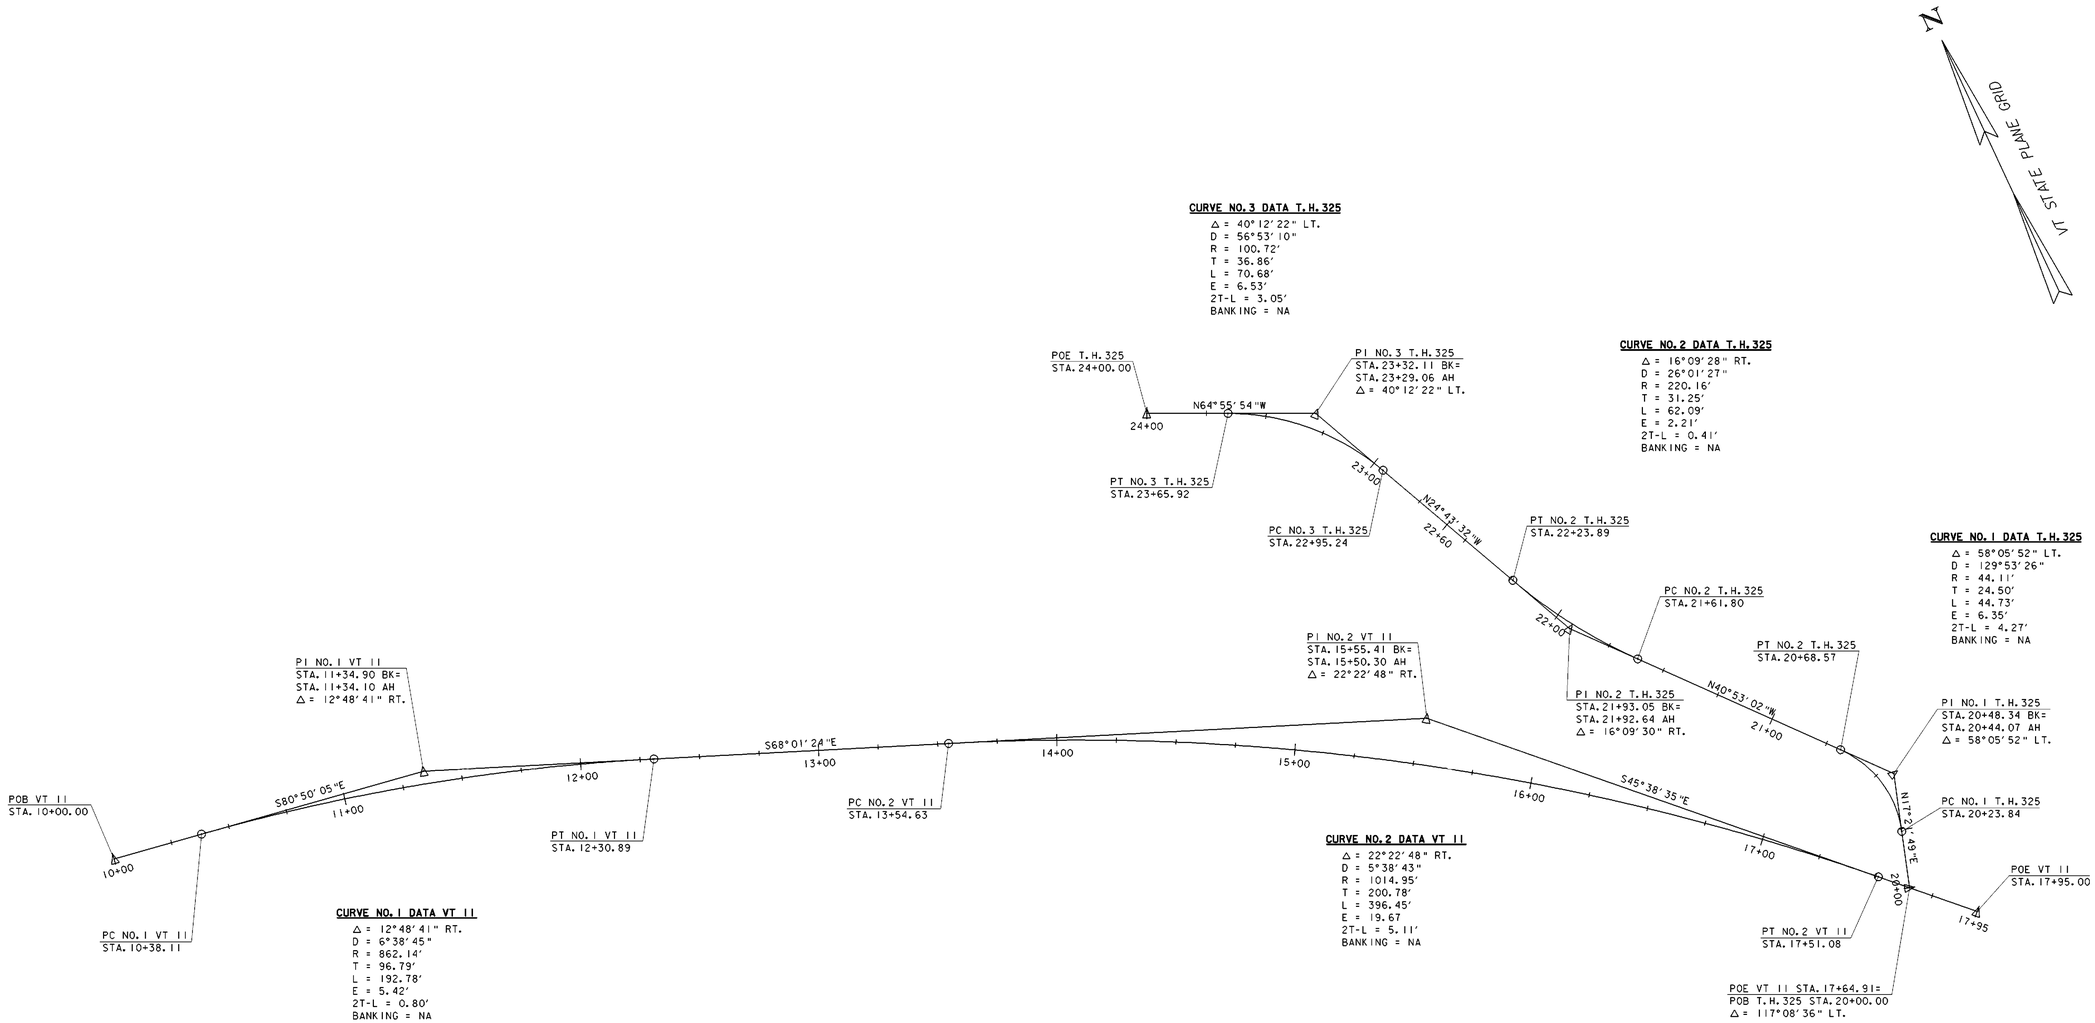

ALIGNMENT SHEET

SCALE: 1" = 30′-0"
30 0 30

PROJECT NAME: SPRINGFIELD	
PROJECT NUMBER: STP 016-2 (10)S	
FILE NAME: 00b124\Structures\sb124a11.i	PLOT DATE: 17-AUG-2004
PROJECT MANAGER: R. WHITCOMB	DRAWN BY: G. ROY
DESIGNED BY: G. ROY	CHECKED BY: R. WHITCOMB
	SHEET 10 OF 72