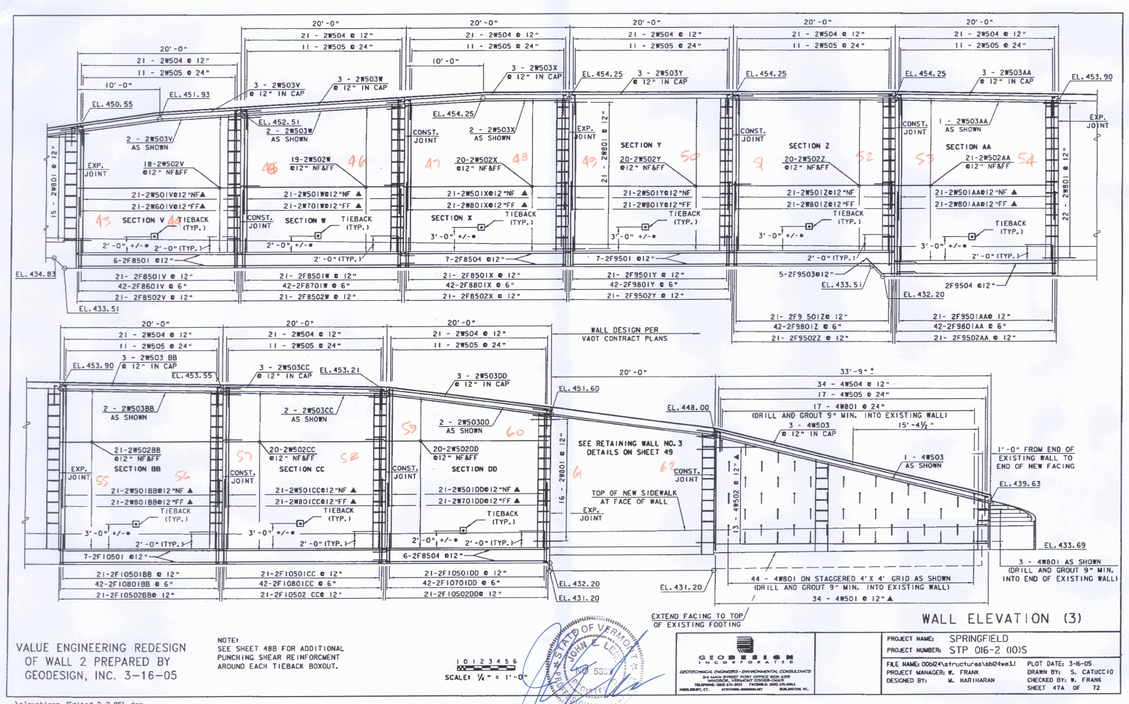

WALL ELEVATION (3)

VALUE ENGINEERING REDESIGN OF WALL 2 PREPARED BY GEODESIGN, INC. 3-16-05

NOTE:
SEE SHEET 48B FOR ADDITIONAL PUNCHING SHEAR REINFORCMENT AROUND EACH TIEBACK BOXOUT.

GEODESIGN INCORPORATED
GEOTECHNICAL ENGINEERS · ENVIRONMENTAL CONSULTANTS
IN ASSOCIATION WITH HARRY DODGE, P.E., P.G.
MANCHESTER CENTER, VERMONT 05255-0975
TELEPHONE: (802) 375-2011 FACSIMILE: (802) 375-6963
HANOVER, NH · STOWE, VERMONT · BURLINGTON, VT.

PROJECT NAME: SPRINGFIELD
PROJECT NUMBER: STP 016-2 (10)S

FILE NAME: 000d24\structures\ab024ve3.I
PROJECT MANAGER: W. FRANK
DESIGNED BY: M. HARIHARAN
PLOT DATE: 3-16-05
DRAWN BY: S. CATUCCIO
CHECKED BY: W. FRANK
SHEET 47A OF 72

...\elevations-(Edited 3-3-05).dgn