TEMPORARY AND DURABLE 100mm YELLOW LINE
STA 2+000 TO 2+400 SOLID LT&RT
(WITH CENTERLINE BREAKS FOR TOWN HIGHWAYS)

TEMPORARY AND DURABLE 100mm WHITE LINE
STA 2+000 TO 2+400 SOLID LT&RT
(WITH EDGELINE BREAKS FOR TOWN HIGHWAYS)

REMOVING SIGNS
1

BITUMINOUS CONCRETE GUTTER
STA 2+130 TO 2+216 LT

CHANGING ELEVATION OF SEWER MANHOLE
STA 2+099 RT
~~STA 2+232 RT~~
STA 2+332 RT

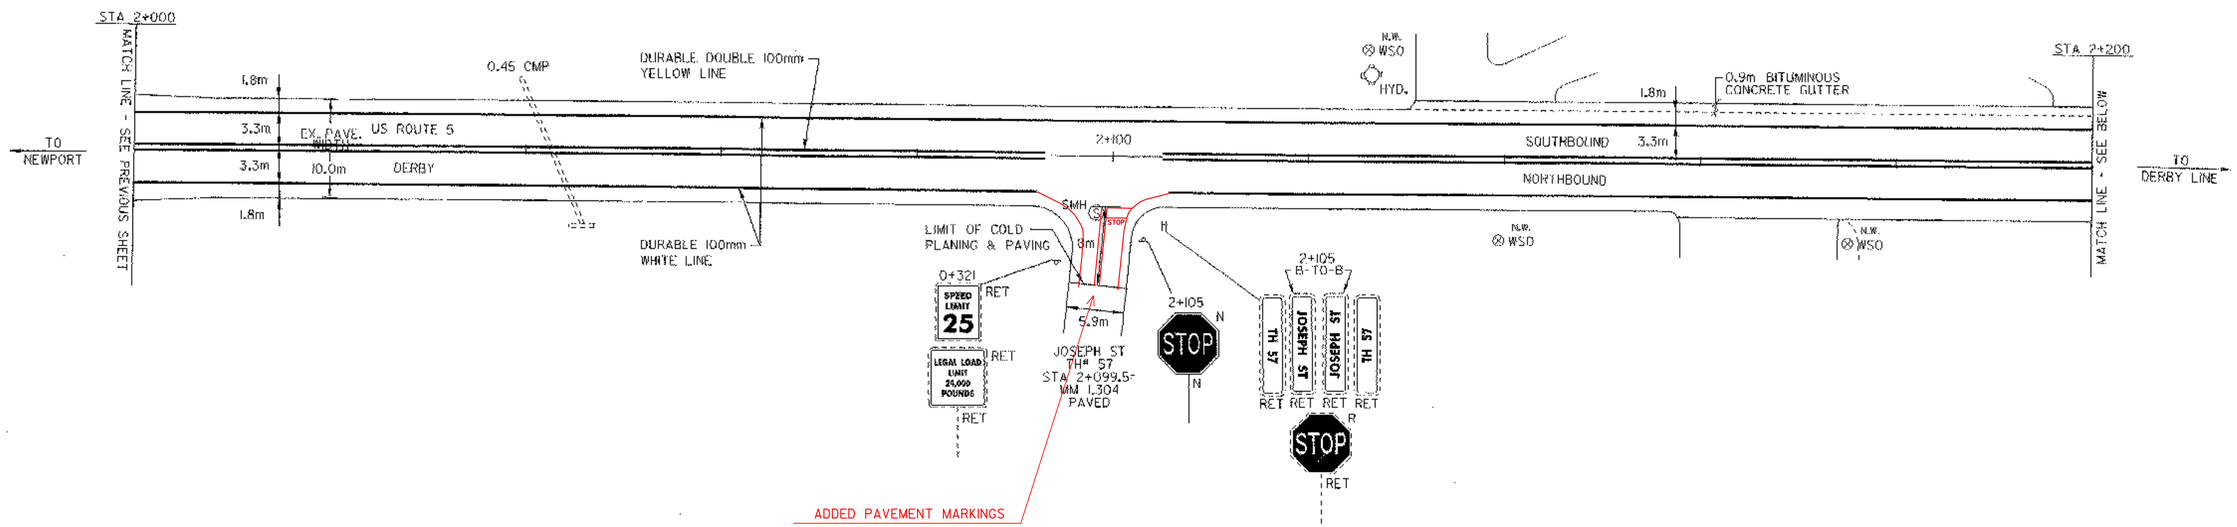

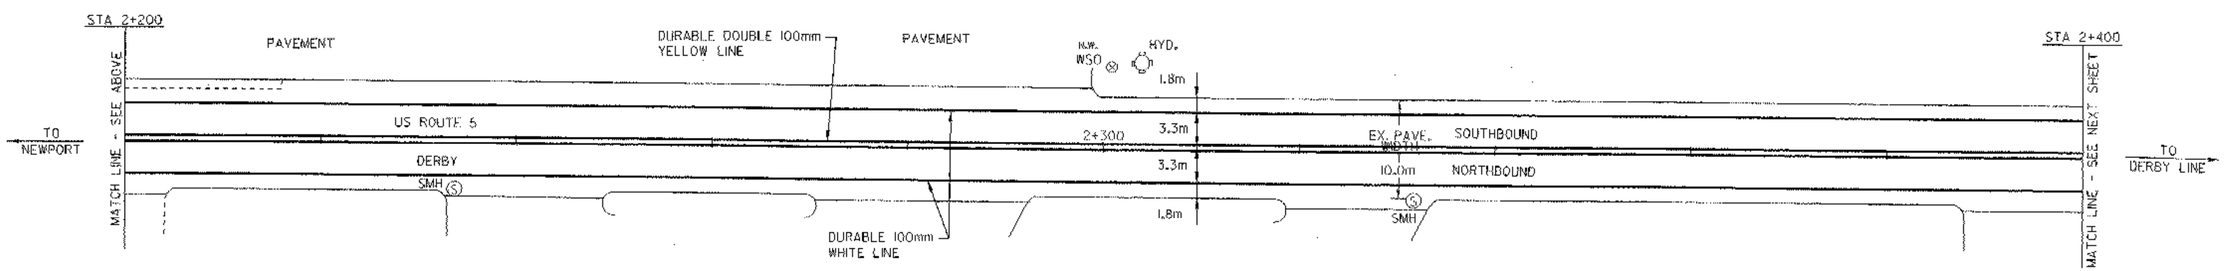

LEGEND

N	=	NEW
R	=	REMOVE
R&S	=	REMOVE & SALVAGE
RET	=	RETAIN
S	=	SALVAGE
B-TO-B	=	BACK TO BACK
		CATCH BASIN/DI/MANHOLE
N.W.		EXISTING CB/DI (NO WORK REQUIRED)
		SEWER MANHOLE
		MARKER POST
		UTILITY POLE
UE/T		UTIL. POLE W/UNDERGROUND UTIL.
		VALVE/CURB STOP
		DRIVE

ARCHIVED ON CADD

Metric

PAVING PROJECT LAYOUT #6

DESIGNED BY BCE/PJM DATE 12-00
DRAWN BY C.E.A., INC. DATE 12-00
DESIGN FILE NO. /pave/00c052/pc052a.dgn
PRF FILE pc052ap06.1 DATE PLOTTED 05-JUN-2003
PROJ. NAME **DERBY**
PROJ. NO. **STP 2224(1)S**
SHEET **12** OF **27** SHEETS