TEMPORARY AND DURABLE 100mm YELLOW LINE

STA 3+600 TO 4+000	SOLID LT&RT
STA 3+932	DOUBLE SOLID RT
STA 3+977	DOUBLE SOLID LT

(WITH CENTERLINE BREAKS FOR TOWN HIGHWAYS)

TEMPORARY AND DURABLE LETTER OR SYMBOL

STA 3+932 RT	"STOP"
STA 3+977 LT	"STOP"

TEMPORARY AND DURABLE 100mm WHITE LINE

STA 3+600 TO 4+000	SOLID LT&RT

(WITH EDGELINE BREAKS FOR TOWN HIGHWAYS)

TEMPORARY AND DURABLE 600mm STOP BAR

STA 3+932 RT	NELSON HILL RD
STA 3+977 LT	WALLACE RD

REMOVING SIGNS

3

REHABILITATION OF D.I.'S, C.B.'S OR M.H.'S

~~STA 3+965 LT~~ 3 + 981LT
~~STA 3+990 LT~~ 3 + 994 LT

~~CHANGING ELEVATION OF SEWER MANHOLES~~
~~STA 3+932 RT~~

CHANGING ELEVATION OF DI,CB OR MH

3 + 985 LT

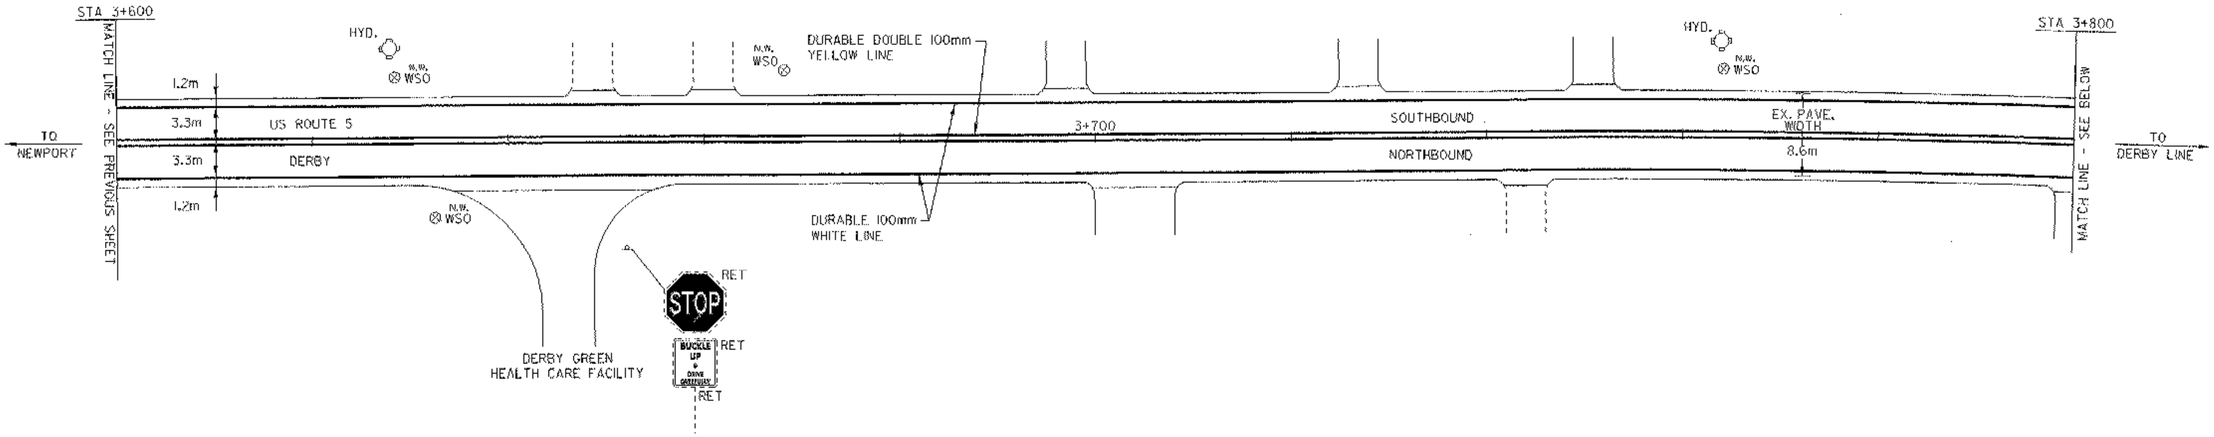

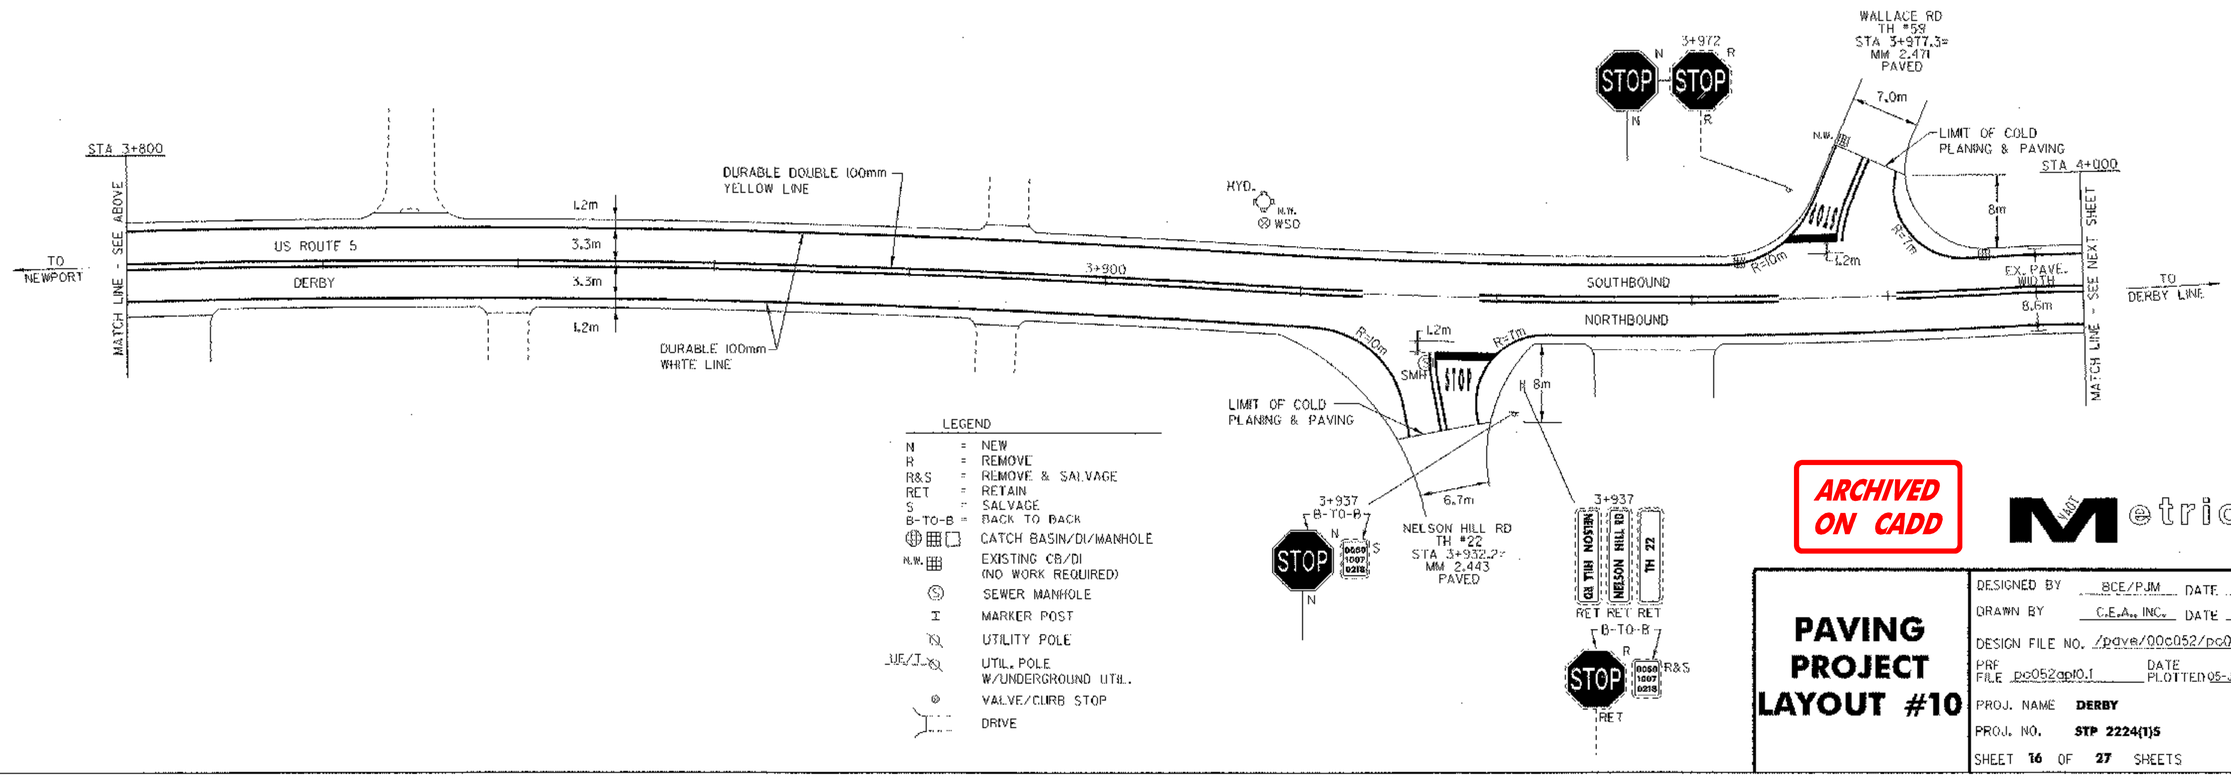

LEGEND

N	=	NEW
R	=	REMOVE
R&S	=	REMOVE & SALVAGE
RET	=	RETAIN
S	=	SALVAGE
B-TO-B	=	BACK TO BACK
		CATCH BASIN/DI/MANHOLE
N.W.		EXISTING CB/DI (NO WORK REQUIRED)
		SEWER MANHOLE
		MARKER POST
		UTILITY POLE
UE/T		UTIL. POLE W/UNDERGROUND UTIL.
		VALVE/CURB STOP
		DRIVE

ARCHIVED ON CADD

Metric

PAVING PROJECT LAYOUT #10

DESIGNED BY	BCE/PJM	DATE	12-00
DRAWN BY	C.E.A., INC.	DATE	12-00
DESIGN FILE NO.	/pave/00c052/pc052o.dgn		
PRF FILE	pc052ap10.1	DATE PLOTTED	05-JUN-2003
PROJ. NAME	DERBY		
PROJ. NO.	STP 2224(1)5		
SHEET 16 OF 27 SHEETS			