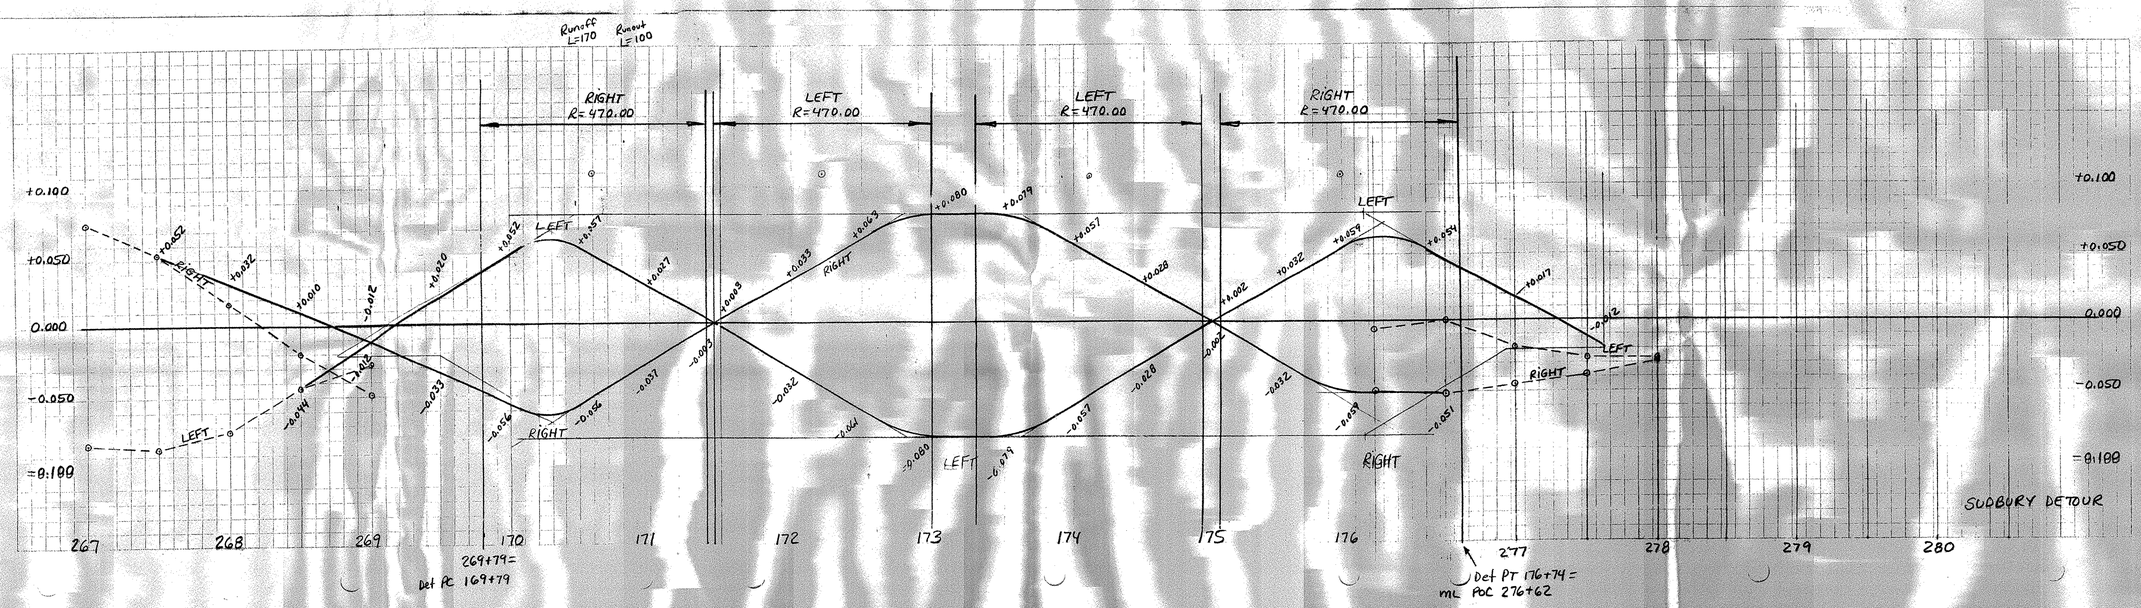
Runoff L=170
Runout L=100
RIGHT R=470.00
LEFT R=470.00
LEFT R=470.00
RIGHT R=470.00
+0.100
+0.050
0.000
-0.050
-0.100
SUDBURY DETOUR
267
268
269
170
171
172
173
174
175
176
277
278
279
280
269+79= Det PC 169+79
Det PT 176+74 = mC POC 276+62