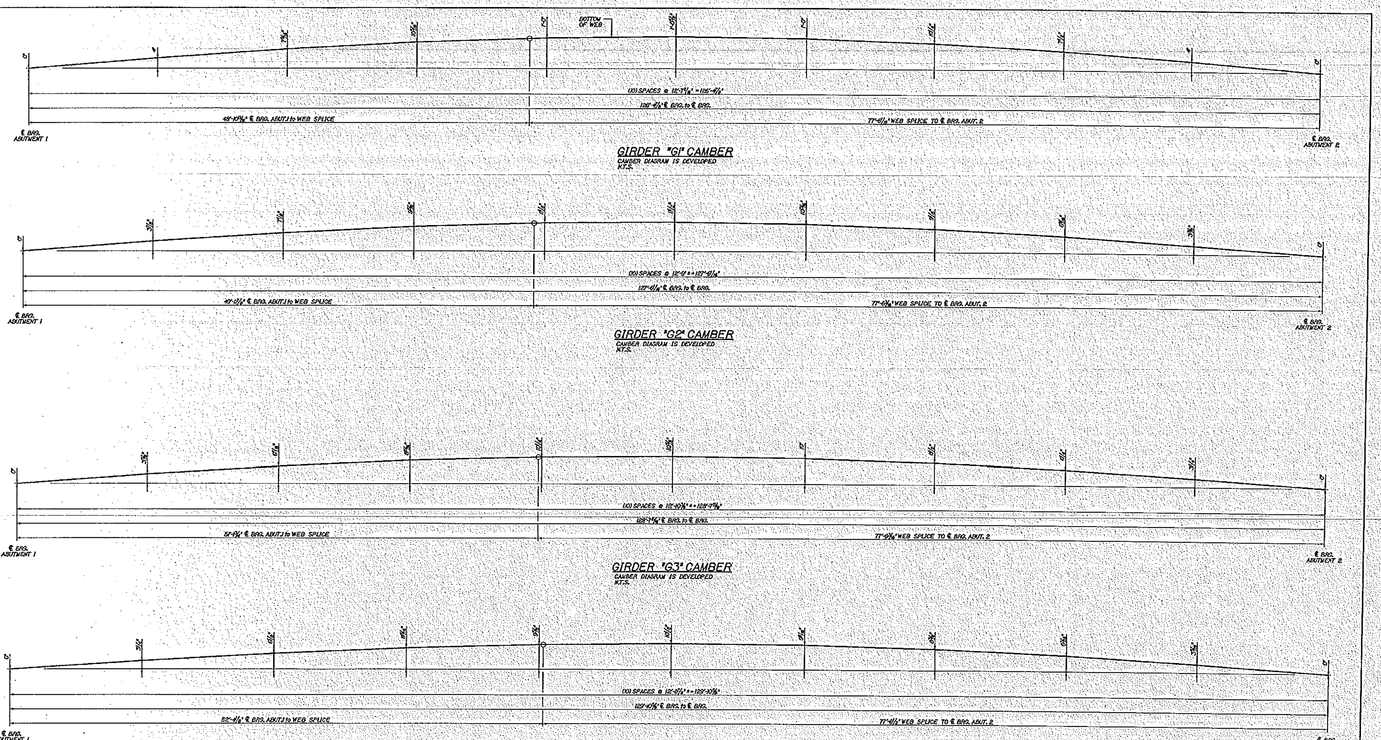

Vermont Agency of Transportation
RECEIVED
CK'D BY GML OK'D BY JEL
11:20 am, Mar 19, 2012
RESUBMIT _____ APPROVED X
BY KMH DATE 3/19/2012

FINISH	SSPC SP5 EVERYWHERE - OUTSIDE PAINT LIMITS ONLY				
MATERIAL	AASHTO M270 / ASTM A709 GRADE 50W				
HOLES	1/16" Ø OVERSIZE				
ELEC PROCS					
WELDS	PER WELD PROCEDURE				
SURFACE PREP	SSPC SP10 w/ ZN-RICH PRIMER				
	SSPC SP6 ELSEWHERE	NO	DATE	DESCRIPTION	BY

REVISIONS

ARC
ADVANCED RESOURCES INC.

ADVANCED RESOURCES & CONST. ENTERPRISES, INCORPORATED
P.O. BOX 1013 KINGSFIELD, ME 04047
PHONE: (207) 265-2145 - FAX: (207) 265-4264

DRAFTER	JEB	CAMBER DIAGRAMS	PROJECT NO.
DATE	DEC 2010	BRIDGE # 57, TOWN HIGHWAY 5	BRO 1010(29)
DESIGNER	JEB	BROOKFIELD, VERMONT	DWG NO.
DATE	JAN 2012	T BUCK CONSTRUCTION	A13