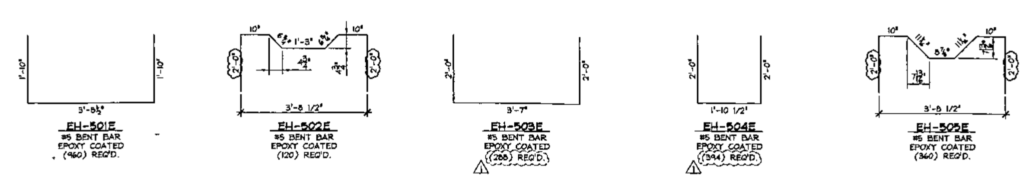

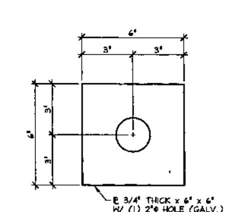

EM - EH1
3" = 1'-0"

MISCELLANEOUS MATERIALS				
ITEM	MARK	QTY.	DESCRIPTION	REMARKS
1	EM-EH1	30	℘ 3/4" x 6" x 6" W/ (1) 2"φ HOLE (GALV.)	FOR ERECTION; SEE DETAIL THIS SHEET
2		30	SINGLE USE STRESSING CHUCK (0.60"φ)	FOR ERECTION
3		5	0.60"φ x 22'-9" POLY-STRAND	FOR ERECTION, PHASE 1
4		10	0.60"φ x 34'-9" POLY-STRAND	FOR ERECTION, PHASE 2
5		90	COMPRESSIBLE SEALER SELF ADHESIVE	FOR ERECTION
6				
7				
8				
9		64	3/4"φ x 5 1/2" NON-FERROUS VOID DRAIN	
10		32	3'-1 1/2" x 1'-4" x 14'-7" BOX VOID	
11		32	SET OF DOUBLE 0.60"φ STRAND LIFTING LOOPS	
12				
13		16	EMBEDDED GUARD RAIL ANCHOR PLATE (GALV.)	SUPPLIED BY OTHERS
14	MX-P3	34	DAYTON C-24 TYPE 4-APR DECK FORM HANGER	GALVANIZE
15				
16				
17				
18				
19				
20				

Vermont Agency of Transportation
RECEIVED
CK'D BY JAG OK'D BY JTS
10:19 am, Mar 05, 2012
RESUBMIT ____ APPROVED X
BY KMH ATE 3-16-12

NO.	DATE	REVISION	
1	3-1-12	REVISED PER ENGINEER COMMENTS	B.L.

STATE OF VERMONT
AGENCY OF TRANSPORTATION

DRAWN: B. LOPEZ
DESIGNED:
CHECKED:
APPROVED:

J.P. CARRARA & SONS INC.
Precast & Prestress Manufacturer
2464 CASE STR., MIDDLEBURY, VERMONT 05753
Phone:(802)388-6361
Fax:(802)388-9010
Double-Tees Hollow-Core Plank Flat Panels

AUSTIN CONSTRUCTION
CONCORD, VT

Project Name:
TOWN OF EAST HAVEN, VT
STATE ROUTE 114 - MAJOR COLLECTOR
BRIDGE NO. 18 PROJECT NO. BRF 0269(11)

MATERIALS LIST

SCALE: NOTED
JOB #: 23363-011
DATE: 1-20-11
SHEET #: M1

F:\VT-Bridges\23363-11 East Haven\23363-M1.dwg, 3/1/2012 10:21:24 AM