646.40 DURABLE 100 mm WHITE LINE
(ALL LINES WILL INCLUDE EDGE LINE BREAKS AND RADIUS FOR TOWN HIGHWAYS)
SALISBURY:
STA. 6+140.0 - STA. 6+680.0 LT & RT

646.60 TEMPORARY 100 mm WHITE LINE
(ALL LINES WILL INCLUDE EDGE LINE BREAKS AND RADIUS FOR TOWN HIGHWAYS)
SALISBURY:
STA. 6+140.0 - STA. 6+680.0 LT & RT

646.41 DURABLE 100 mm YELLOW LINE
(ALL LINES WILL INCLUDE C/L BREAKS FOR TOWN HIGHWAYS) S=SOLID, D=DASHED

SALISBURY:	LT	℄	RT
STA. 6+140.0 - STA. 6+248.0	D	-	S
STA. 6+248.0 - STA. 6+528.0	S	-	D
STA. 6+528.0 - STA. 6+680.0	-	D	-

646.61 TEMPORARY 100 mm YELLOW LINE
(ALL LINES WILL INCLUDE C/L BREAKS FOR TOWN HIGHWAYS) S=SOLID, D=DASHED

SALISBURY:	LT	℄	RT
STA. 6+140.0 - STA. 6+248.0	D	-	S
STA. 6+248.0 - STA. 6+528.0	S	-	D
STA. 6+528.0 - STA. 6+680.0	-	D	-

675.50 REMOVING SIGNS
AS SHOWN - 1

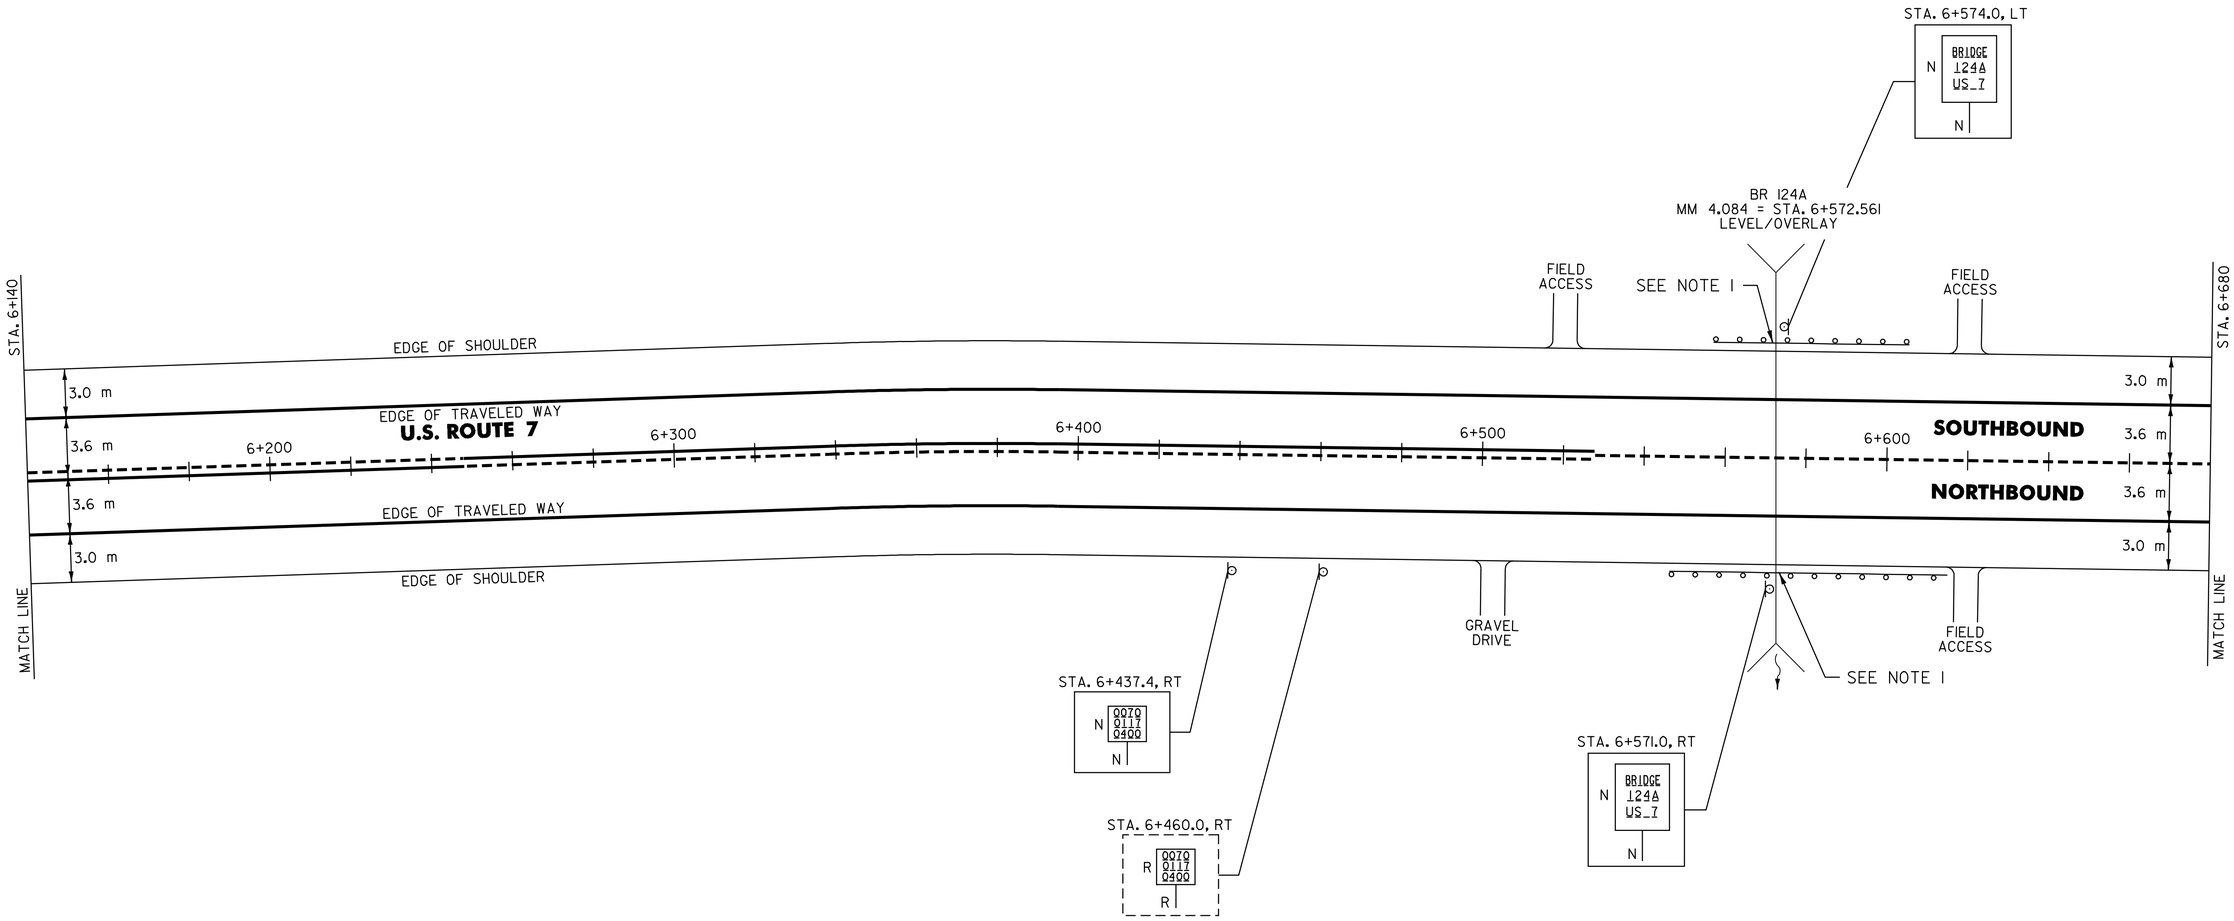

621.20 STEEL BEAM GUARDRAIL

SALISBURY:
STA. 6+556.4 - STA. 6+594.4 RT (38.0 m)
STA. 6+569.4 - STA. 6+592.2 LT (22.8 m)

621.505 MANUFACTURED TERMINAL SECTION (FLARED)

SALISBURY:
STA. 6+545.0 - STA. 6+556.4 RT
STA. 6+558.0 - STA. 6+569.4 LT
STA. 6+592.2 - STA. 6+603.6 LT
STA. 6+594.4 - STA 6+605.8 RT

621.80 REMOVAL AND DISPOSAL OF GUARDRAIL

SALISBURY:
STA. 6+545.0 - STA. 6+605.0 RT (60.0 m)
STA. 6+558.0 - STA. 6+604.0 LT (46.0 m)

SIGN LEGEND

R= REMOVE
S= SALVAGE
N= NEW
RET= RETAIN
B-B= BACK TO BACK
EXISTING= - - - - - - - -
NEW= ————————

NOTE:

1. SEE SHEET 66 OF 67 FOR STEEL BEAM GUARDRAIL AT SMALL CULVERTS DETAIL.

DATUM
VERTICAL N/A
HORIZONTAL N/A

PAVING PROJECT LAYOUT # 9

SURVEYED BY N/A DATE N/A
DRAWN BY C.A.K. DATE 2/02
SQUAD LEADER D.E.G.
DESIGN FILE NO. pave/01b018/pb018.dgn
IPARM FILE pb018p09.i DATE PLOTTED 10-JUL-2006 13:
PROJ. NAME SALISBURY - MIDDLEBURY
PROJ. NO. NH 23(11)S
SHEET 18 OF 67 SHEETS