TEMPORARY 4" WHITE LINE, PAINT
DURABLE 4" WHITE LINE, THERMOPLASTIC

STA	429+50	TO	440+50	SOLID	LT
STA	429+50	TO	440+50	SOLID	RT

TEMPORARY 4" YELLOW LINE, PAINT
DURABLE 4" YELLOW LINE, THERMOPLASTIC

STA	429+50	TO	440+50	SOLID	LT & RT

STEEL BEAM GUARDRAIL, GALVANIZED

STA	429+50	TO	~~430+79~~	LT 431+04
STA	432+96	TO	436+96	LT
STA	440+~~44~~ 56	TO	440+50	LT

MANUFACTURED TERMINAL SECTION, FLARED

STA	~~430+79~~	LT 431+04
STA	432+96	LT
STA	436+96	LT
STA	~~440+44~~ 440+56	LT

REMOVAL AND DISPOSAL OF GUARDRAIL

STA	429+50	TO	431+32	LT
STA	432+58	TO	437+32	LT
STA	440+06	TO	440+50	LT

REMOVING SIGNS
AS SHOWN - 7

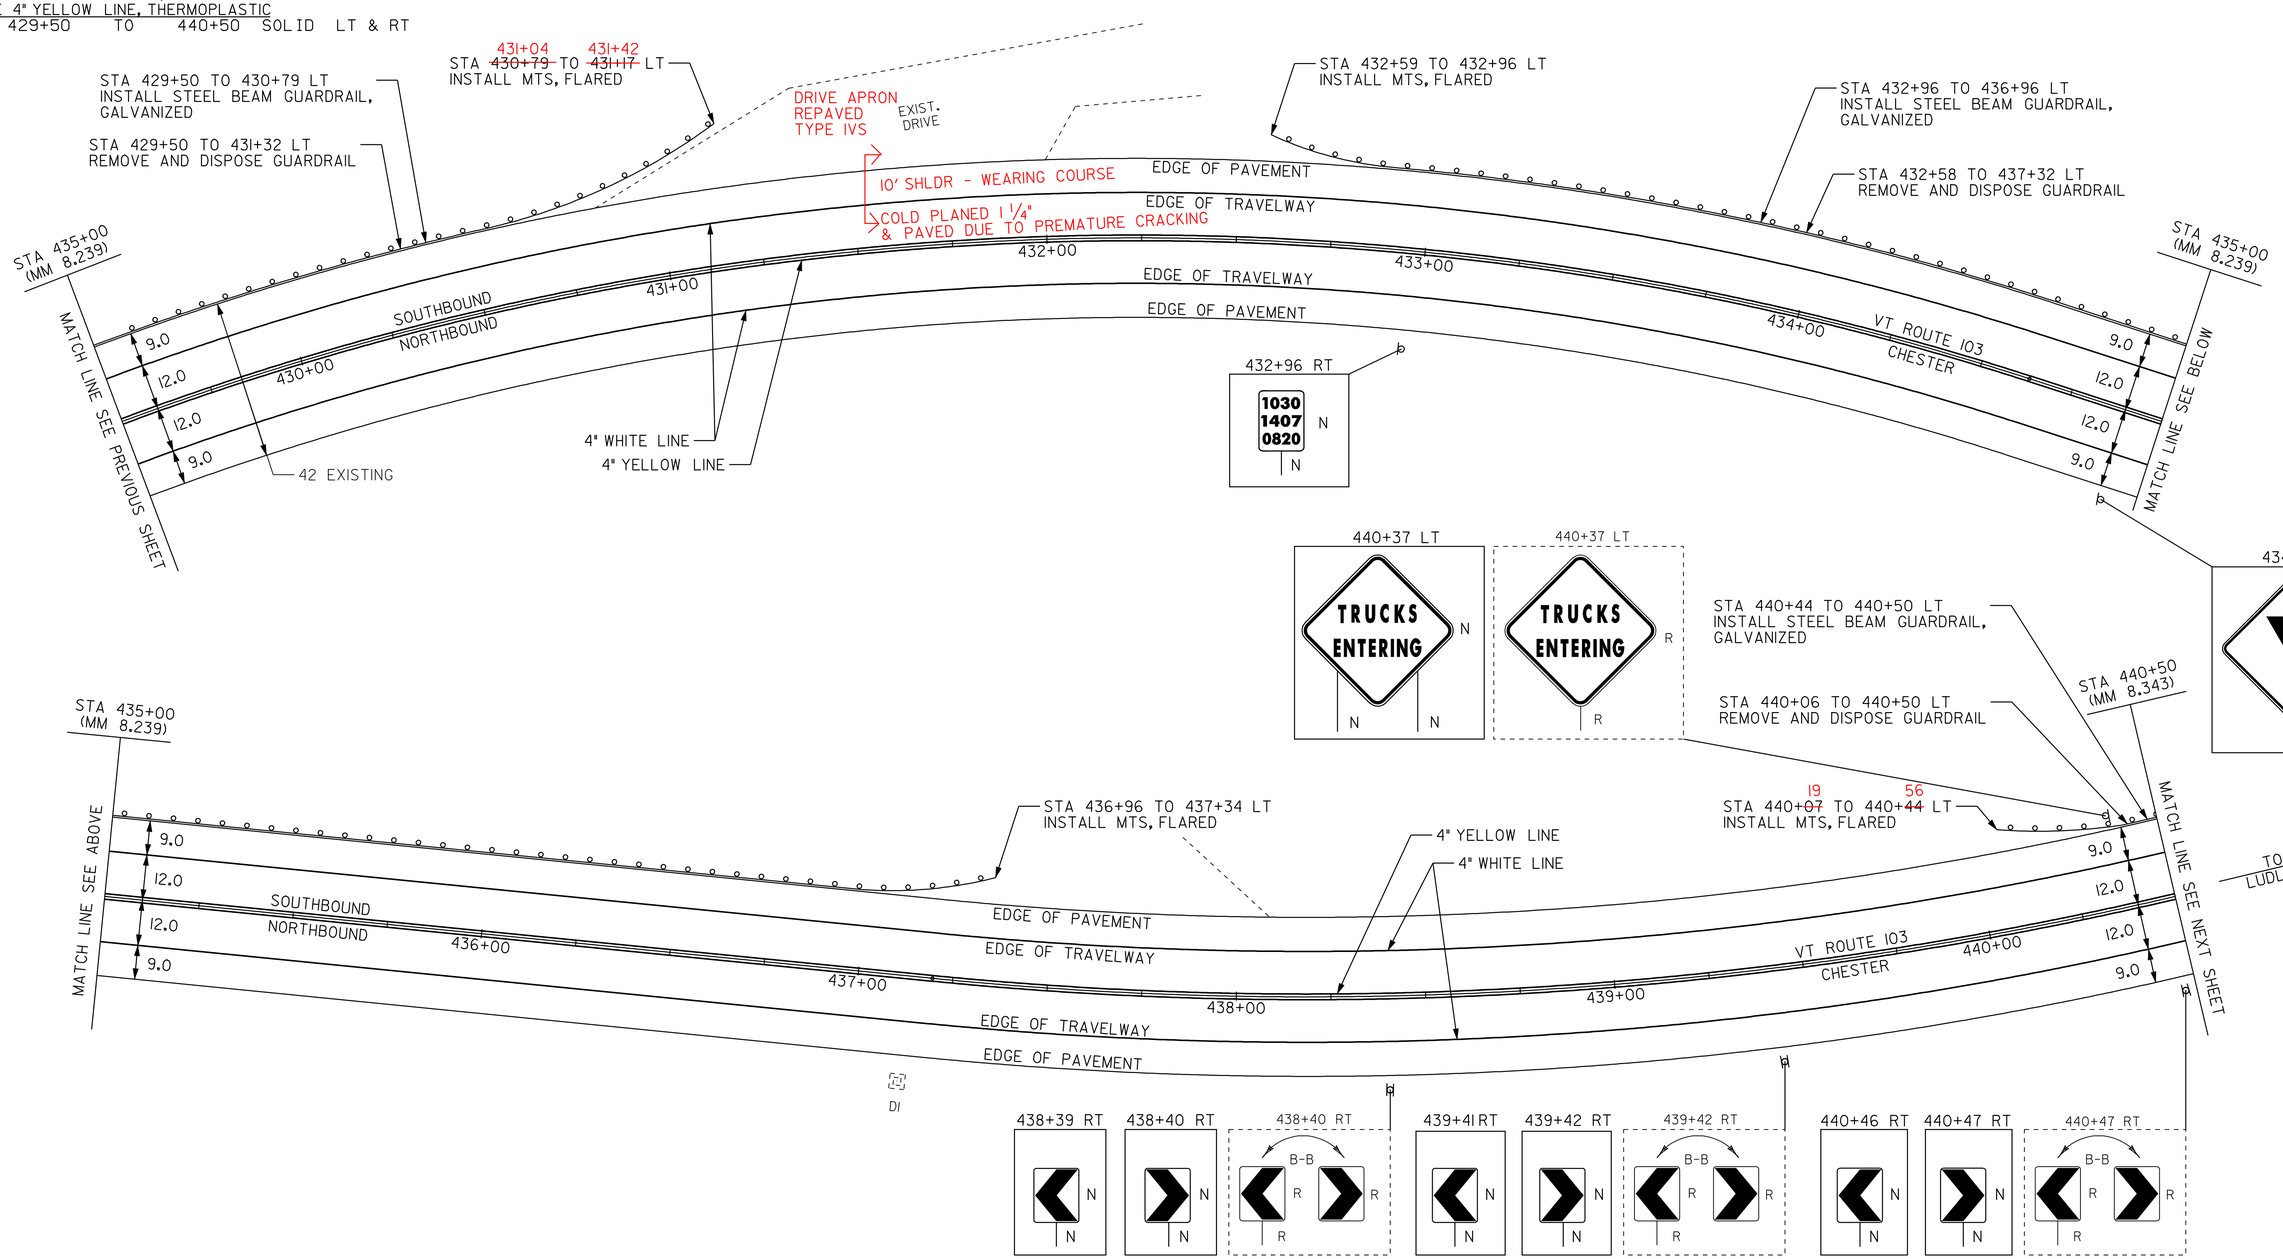

LEGEND

R	=	REMOVE EXISTING
S	=	SALVAGE
R&S	=	REMOVE AND SALVAGE
N	=	NEW
RET	=	RETAIN
B-B	=	BACK TO BACK
o o	=	NEW RAIL
- - -	=	EXISTING RAIL

PAVING PROJECT LAYOUT #22

PROJECT: CHESTER-LUDLOW
PROJECT NO.: NH 2326(I)S

DESIGN FILE NAME: /pave/01b038/pb038.dgn
IPARM FILE NAME: pb0381a22.i
SURVEYED BY: CLD ENGINEERS, INC
SQUAD LEADER: CRB
CLD 04-0396
PLOT DATE: 16-OCT-2009 16:
SURVEY DATE: 01/05
DRAWN BY: MRS
SHEET: 36 OF 110