TEMPORARY 4" WHITE LINE, PAINT
DURABLE 4" WHITE LINE, THERMOPLASTIC

STA	L 31+50	TO	L 42+50	SOLID	LT
STA	L 31+50	TO	L 42+50	SOLID	RT

TEMPORARY 4" YELLOW LINE, PAINT
DURABLE 4" YELLOW LINE, THERMOPLASTIC

STA	L 31+50	TO	L 42+50	SOLID	LT & RT

REMOVAL OF EXISTING DELINEATOR

STA	L 36+35	TO	L 42+50	RT

STEEL BEAM GUARDRAIL, GALVANIZED W/8 FEET POSTS

STA	L 31+50	TO	L 31+87	LT
STA	L 31+50	TO	L 32+36	RT
STA	L 34+09	TO	L 42+50	LT

ANCHOR FOR STEEL BEAM RAIL

STA	L 31+~~87~~ 74	LT
STA	L 32+~~36~~ 61	RT
STA	L ~~34+09~~ 33+99	LT

REMOVAL AND DISPOSAL OF GUARDRAIL

STA	L 31+50	TO	L 31+87	LT
STA	L 31+50	TO	L 32+36	RT
STA	L 34+12	TO	L 42+50	LT

REMOVING SIGNS
AS SHOWN - 4

ERECTING SALVAGED SIGNS
(NO FED. PART.)
AS SOWN (TIS) - 3

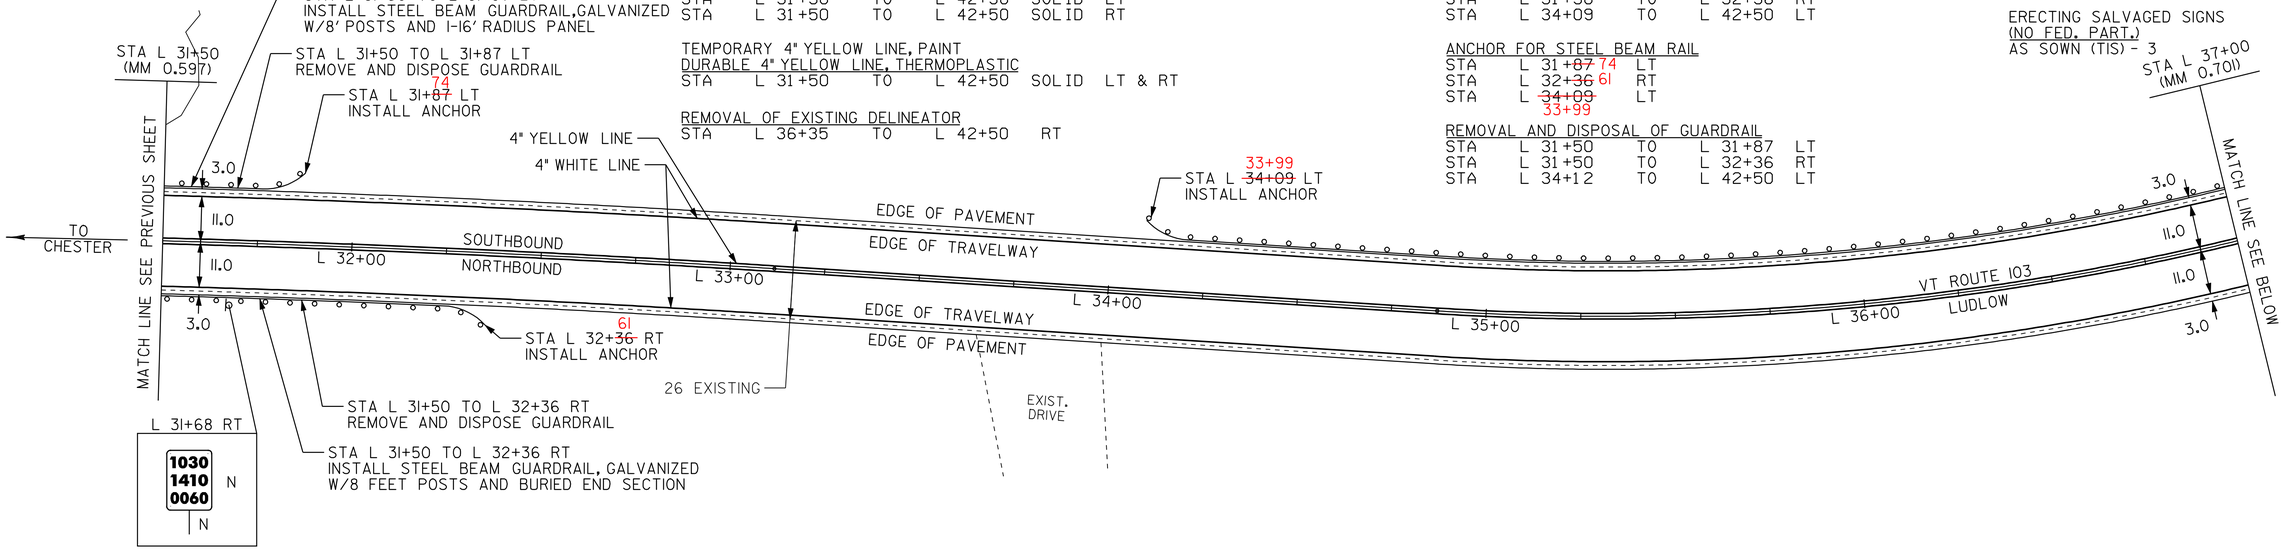

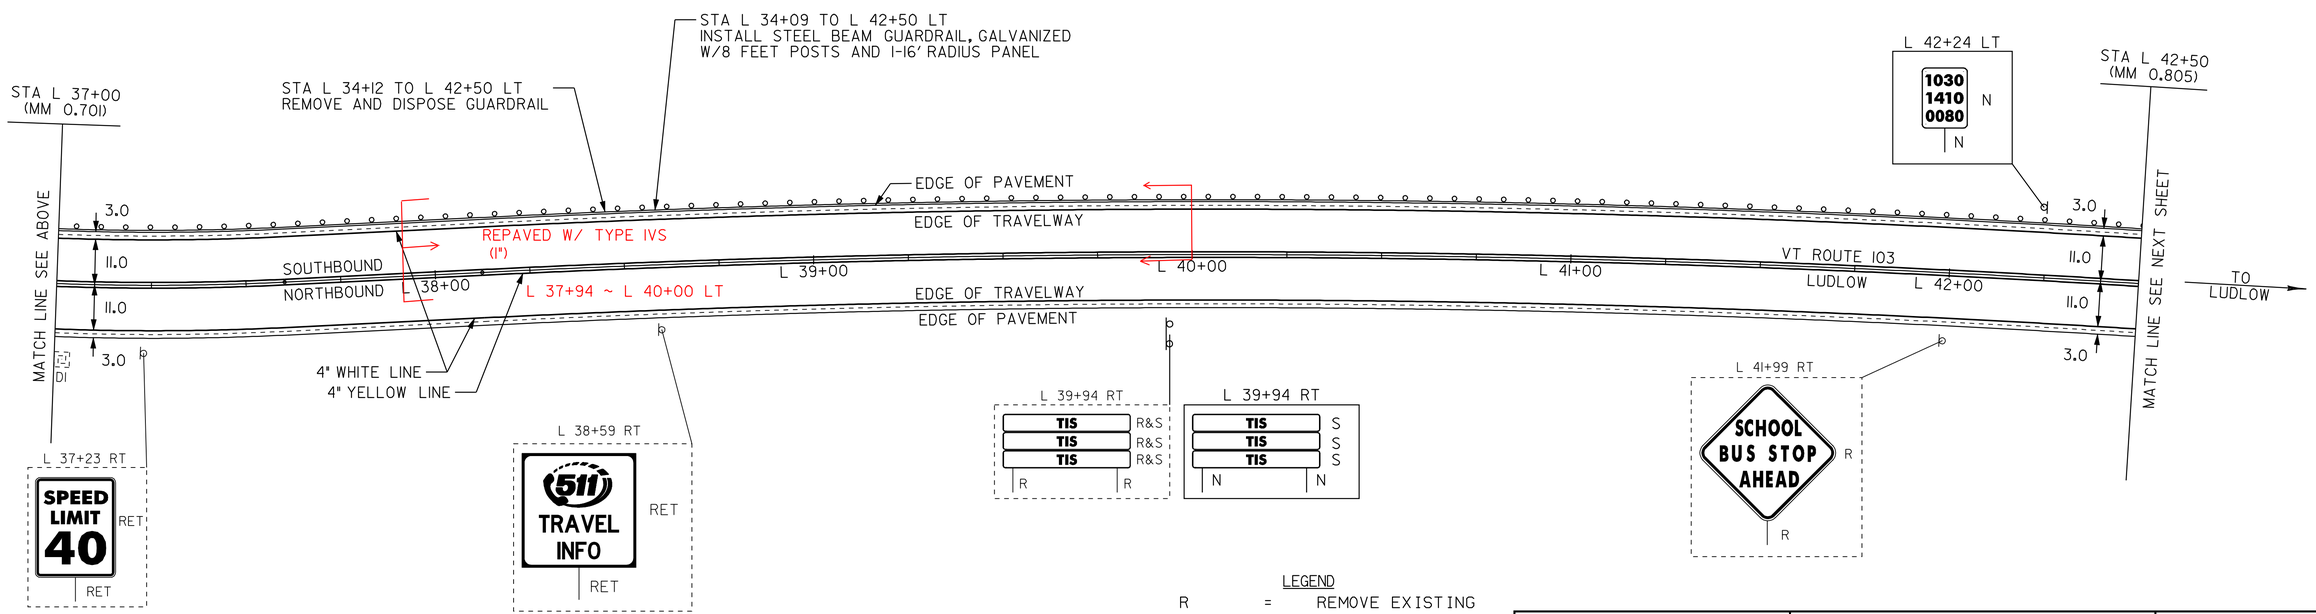

LEGEND

R	=	REMOVE EXISTING
S	=	SALVAGE
R&S	=	REMOVE AND SALVAGE
N	=	NEW
RET	=	RETAIN
B-B	=	BACK TO BACK
	=	NEW RAIL
	=	EXISTING RAIL

PAVING PROJECT LAYOUT #53

PROJECT: CHESTER-LUDLOW
PROJECT NO.: NH 2326(1)S

DESIGN FILE NAME: /pave/01b038/pb038.dgn
IPARM FILE NAME: pb0381a53.i
PLOT DATE: 16-OCT-2009 17:
SURVEYED BY: CLD ENGINEERS, INC
SURVEY DATE: 01/05
SQUAD LEADER: CRB
DRAWN BY: MRS
CLD 04-0396
SHEET: 67 OF 110