STATE OF VERMONT
AGENCY OF TRANSPORTATION

TRAFFIC SIGN SUMMARY SHEET #20

MILEMARKER, STATION, OR SIGN NUMBER	SIGN LEGEND	SIGN DIMENSIONS			NEW & SALVAGED SIGNS				EXIST POST		NEW SIGN POSTS																	REMARKS	SIGN DETAIL	
		EA	WIDTH (in)	HEIGHT (in)	"A"	"B"	SALV SIGN	SALV TIS	RETAIN	SALVAGE	NO. OF POSTS	FLANGED CHANNEL lb/ft			SQUARE STEEL (in) lb/ft			ANCHOR	SLEEVE	TUBULAR ALUMINUM Ø (in) lb/ft			FOUNDATION	TUBULAR STEEL Ø (in) lb/ft				W-SHAPE STEEL FTG. SIZE		WEIGHT	POST SIZE	SIGN FRAME REQUIRED		DETAIL ON SHEET NUMBER	STD. SHEET NUMBER
												1.12	2.0	3.0	1.75	2.0	2.5			3.0	4.0	4.0 MOD		3.0	3.5	4.0	5.0	24"	30"						
															1.88	2.16	3.35			1.3	1.7	1.7		7.6	9.0	10.8	14.6								
												OPTION ITEMS																							
STA C 144+51 RT		1	30	30	~~6.25~~ ~~6.00~~						1			X 16		X																	W10-12		
STA C 146+00 LT	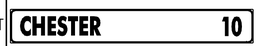	1	72	12	6.00						2			X 30		X																		E-123
		1	72	12	6.00																													E-123
STA C 146+15 RT		1	72	12	6.00						2			X 31		X																		E-123
		1	72	12	6.00																													E-123
		1	72	12	6.00																													E-123
		1	72	12	6.00																													E-123
STA C 147+72 RT		2	48	9	~~6.00~~																												RETAINED SIGN MOUNT ON RAILROAD CROSSING LIGHT POLE		E-190
STA C 147+84 LT		1	24	12	2.00						1			X 15		X																		E-136B
		1	30	24	5.00																													E-136B
		1	6	10	0.42																													E-138
TOTALS		SF ~~55.42~~ 49.67	SF	EA.	EA		FT ~~90~~ 92				FT ~~90~~							EA	LB			EA.	LB				EA.	EA.	LB					

FINAL POST LENGTHS ARE TO BE DETERMINED IN THE FIELD. POST SIZES ARE COMPUTED BASED ON INFORMATION FURNISHED ON THE STANDARD SHEETS AND THE TRAFFIC & SAFETY DIVISION'S "SIGN POST DESIGN GUIDELINE."

TRAFFIC SIGN SUMMARY SHEET 20

PROJECT NAME: CHESTER-LUDLOW
PROJECT NUMBER: NH 2326(I)S
FILE NAME: /pave/Olb038/pb038.dgn PLOT DATE: 16-OCT-2009 17:2
PROJECT LEADER: CRB DRAWN BY: MRS
IPARM FILE NAME: pb038ts20.i CHECKED BY: NLL
CLD 04-0396 SHEET 98 OF 110