INDEX OF SHEETS
SEE SHEET 2

STATE OF VERMONT
AGENCY OF TRANSPORTATION

PROPOSED IMPROVEMENT
TOWN OF ARLINGTON
COUNTY OF BENNINGTON
VT. ROUTE 313

BEGINNING IN THE TOWN OF ARLINGTON ON VT. ROUTE 313 AT MILE MARKER ~~0.000 = STA 0+00.00~~ -0+50.00
AND EXTENDING EASTERLY FOR A DISTANCE OF ~~33,943.0 FEET (6.429~~ MILES) TO A 33,956.0 FEET (6.441 MILES)
POINT IN THE TOWN OF ARLINGTON AT MILE MARKER ~~6.429 = STA 339+43.00.~~ RESUMING IN THE 6.441 = STA 339+56.00.
TOWN OF ARLINGTON ON VT. ROUTE 313 MILE MARKER ~~6.523 = STA 344+42.00~~ AND EXTENDING 6.521 = STA 344+30.00
EASTERLY FOR A DISTANCE OF ~~585.50 FEET (0.111 MILES)~~ TO A POINT IN THE TOWN OF ARLINGTON 597.52 FEET (0.113 MILES)
AT MILE MARKER 6.634 = STA 350+27.52. ✓

LENGTH OF ROADWAY	~~35,027.52 FT (6.634 MILES)~~	35,077.52 FT (6.643 MILES)
LENGTH OF PROJECT	~~34,528.52 FT (6.539 MILES)~~	34,603.52 FT (6.554 MILES)

WORK TO BE PERFORMED UNDER THIS PROJECT INCLUDES COLD PLANING SEGMENTS OF THE EXISTING HIGHWAY AND OVERLAYING WITH A LEVELING COURSE AND A WEARING COURSE, WITH PAVEMENT MARKINGS, GUARDRAIL IMPROVEMENTS, DRAINAGE IMPROVEMENTS AND INCIDENTAL ITEMS.

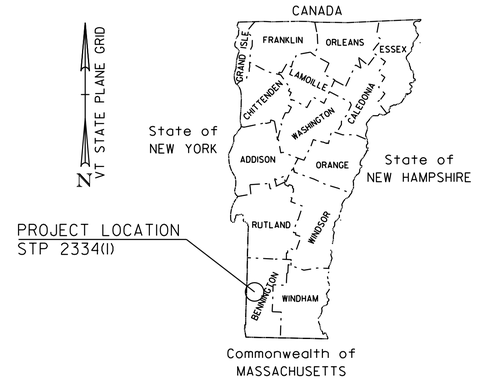

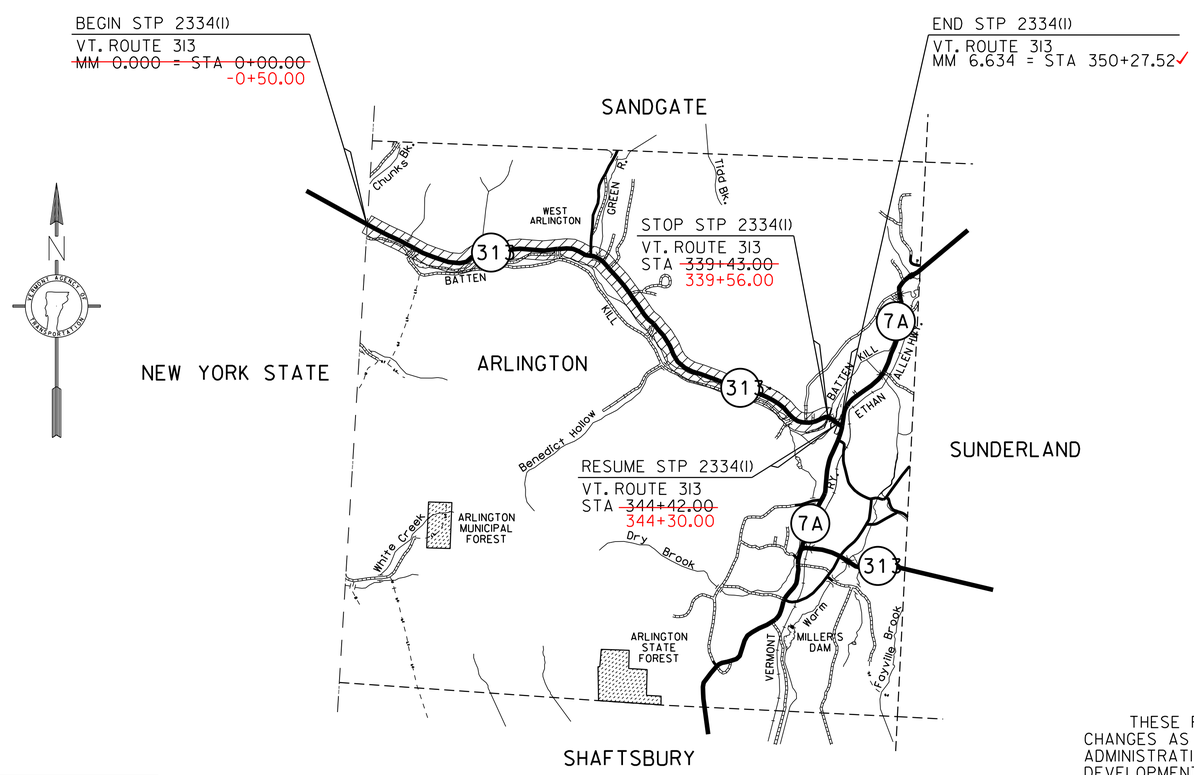

BITUMINOUS CONCRETE SUPERPAVE MIXTURE DESIGN CRITERIA	
DESIGN LANE/DESIGN LIFE ESAL	321,000
DESIGN NUMBER OF GYRATIONS	65
PERFORMANCE GRADE ASPHALT BINDER	SEE SECTION 490 GENERAL SPECIAL PROVISIONS

TRAFFIC DATA

SECTIONS	ADT		DHV		ESALS	ESALS
	2011	2021	2011	2021	2011~2021	2011~2031
BEGIN PROJECT TO SANDGATE ROAD	1300	1400	150	160	157,000	362,000
SANDGATE ROAD TO END PROJECT	2400	2600	270	290	275,000	643,000

QUALITY ASSURANCE PROGRAM: LEVEL 3

CONVENTIONAL SYMBOLS

COUNTY LINE
TOWN LINE
LIMITS OF ACCESS
POINT OF ACCESS
FENCE LINE
STONE WALL
TRAVELED WAY
GUARD RAIL
RAILROAD
SURVEY LINE
CULVERT
POWER POLE
TELEPHONE POLE
TREES
CONTROL OF ACCESS
PROPERTY LINE
R.O.W. TAKING LINE
SLOPE RIGHTS (SR SR SR)
TOP OF CUT
TOE OF SLOPE

SURVEYED BY : NA
SURVEYED DATE : NA

DATUM
VERTICAL NA
HORIZONTAL NA

THESE PLANS ARE SUBJECT TO SUCH ENGINEERING CHANGES AS MAY BE REQUIRED BY THE FEDERAL HIGHWAY ADMINISTRATION OR THE DIRECTOR OF PROGRAM DEVELOPMENT.
CONSTRUCTION IS TO BE CARRIED ON IN ACCORDANCE WITH THESE PLANS AND THE STANDARD SPECIFICATIONS FOR CONSTRUCTION DATED 2006, AS APPROVED BY THE FEDERAL HIGHWAY ADMINISTRATION ON JUNE 15, 2006 FOR USE ON THIS PROJECT, INCLUDING ALL SUBSEQUENT REVISIONS AND SUCH REVISED SPECIFICATIONS AND SPECIAL PROVISIONS AS ARE INCORPORATED IN THESE PLANS.

PROJECT MANAGER : MIKE FOWLER

PROJECT NAME : ARLINGTON
PROJECT NUMBER : STP 2334(I)

SHEET 9 OF 143 SHEETS