STATE OF VERMONT
AGENCY OF TRANSPORTATION

TRAFFIC SIGN SUMMARY SHEET 1

MILEMARKER, STATION, OR SIGN NUMBER	SIGN LEGEND	SIGN DIMENSIONS EA	WIDTH (in)	HEIGHT (in)	NEW & SALVAGED SIGNS "A"	"B"	SALV SIGN	SALV TIS	EXIST POST RETAIN	EXIST POST SALVAGE	NEW SIGN POSTS NO. OF POSTS	FLANGED CHANNEL lb/ft 1.12	2.0	3.0	SQUARE STEEL (in) lb/ft 1.75 1.88	2.0 2.42	2.5 3.35	ANCHOR	SLEEVE	TUBULAR ALUMINUM Ø (in) lb/ft 3.0 1.3	4.0 1.7	4.0 MOD 1.7	FOUNDATION	TUBULAR STEEL Ø (in) lb/ft 3.0 7.6	3.5 9.0	4.0 10.8	5.0 14.6	W-SHAPE STEEL FTG. 24"	SIZE 30"	WEIGHT	POST SIZE	SIGN FRAME REQUIRED	REMARKS SHS = FHWA STANDARD HIGHWAY SIGNS BOOK	SIGN DETAIL DETAIL ON DWG. NUMBER	STD. SHEET NUMBER
ARLINGTON: I47+84.0, RT		1	30	30	6.25						1					X		X															SIGN ID CODE W11-2 SIGN SHALL BE FLUORESCENT YELLOW-GREEN.		SHS
		1	18	24	3.00	ALL SIGNS SIZES WERE INSTALLED PER PLAN. SEE LAYOUT SHEETS FOR LOCATIONS																											SIGN ID CODE W3-7a SIGN SHALL BE FLUORESCENT YELLOW-GREEN.		SHS
		1	6	10	0.42																											SIGN ID CODE VD-700		E-138
I52+40.0, LT		1	24	30	5.00						1					X		X															SIGN ID CODE R2-1		SHS
I55+48.0, LT	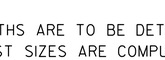	2	42	12	7.00						1					X		X															TOP MOUNTING BRACKET REQUIRED TO INSTALL SIGN ON POST. COSTS ASSOCIATED WITH THIS BRACKET ARE INCIDENTAL TO THE SIGN POST. SIGN ID CODE D3-1	131	
	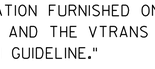	1	6	10	0.42		1																										BACK-TO-BACK SALVAGED SIGN SHALL BE MOUNTED ON NEW POST. SIGN ID CODE VD-700		E-138
I58+40.0, RT		2	42	12	7.00						1					X		X															TOP MOUNTING BRACKET REQUIRED TO INSTALL SIGN ON POST. COSTS ASSOCIATED WITH THIS BRACKET ARE INCIDENTAL TO THE SIGN POST. SIGN ID CODE D3-1	131	
	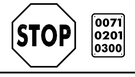	1	6	10	0.42		1																										BACK-TO-BACK SALVAGED SIGN SHALL BE MOUNTED ON NEW POST. SIGN ID CODE VD-700		E-138
I60+59.0, LT		1	30	30	6.25						1					X		X															SIGN ID CODE W11-2 SIGN SHALL BE FLUORESCENT YELLOW-GREEN.		SHS
		1	18	24	3.00																											SIGN ID CODE W3-7a SIGN SHALL BE FLUORESCENT YELLOW-GREEN.		SHS
I60+74.0, RT		2	42	12	7.00						1					X		X															SIGN ID CODE D3-1	131	
		1	6	10	0.42		1																										BACK-TO-BACK SALVAGED SIGN SHALL BE MOUNTED ON NEW POST. SIGN ID CODE VD-700		E-138
												LF	LF	LF	LF	LF 84	LF		EA.	LB	LB	LB		LB	LB	LB	LB								
FINAL POST LENGTHS ARE TO BE DETERMINED IN THE FIELD. POST SIZES ARE COMPUTED BASED ON INFORMATION FURNISHED ON THE STANDARD SHEETS AND THE VTRANS "SIGN POST DESIGN GUIDELINE."																																			
TOTALS					SF 46.18	SF	EA. 3	SF					LF			LF 84					LB			EA.		LB			EA.	EA.	LB					

TRAFFIC SIGN SUMMARY SHEET #1

PROJECT NAME: ARLINGTON-DORSET
PROJECT NUMBER: STP 2625(I)

FILE NAME: p06c218.dgn
PROJECT LEADER: D.E.G.
DESIGNED BY: D.W.E.
IPARM FILE: p06c218tss01.i

PLOT DATE: $DATE$
DRAWN BY: C.A.K.
CHECKED BY: M.J.L.
SHEET 100 OF 143