STATE OF VERMONT
AGENCY OF TRANSPORTATION

TRAFFIC SIGN SUMMARY SHEET 3

MILEMARKER, STATION, OR SIGN NUMBER	SIGN LEGEND	SIGN DIMENSIONS EA	WIDTH (in)	HEIGHT (in)	NEW & SALVAGED SIGNS "A"	"B"	SALV SIGN	SALV TIS	EXIST POST RETAIN	EXIST POST SALVAGE	NEW SIGN POSTS NO. OF POSTS	FLANGED CHANNEL lb/ft 1.12	2.0	3.0	SQUARE STEEL (in) 1.75 lb/ft 1.88	2.0 lb/ft 2.42	2.5 lb/ft 3.35	ANCHOR	SLEEVE	TUBULAR ALUMINUM Ø (in) 3.0 lb/ft 1.3	4.0 lb/ft 1.7	4.0 MOD lb/ft 1.7	TUBULAR STEEL Ø (in) FOUNDATION	3.0 lb/ft 7.6	3.5 lb/ft 9.0	4.0 lb/ft 10.8	5.0 lb/ft 14.6	W-SHAPE STEEL FTG. SIZE 24"	30"	WEIGHT	POST SIZE	SIGN FRAME REQUIRED	REMARKS SHS = FHWA STANDARD HIGHWAY SIGNS BOOK	SIGN DETAIL DETAIL ON DWG. NUMBER	STD. SHEET NUMBER
ARLINGTON: 194+90.0, RT		1	30	30	6.25						1					X		X															SIGN ID CODE W11-2 SIGN SHALL BE FLOURESCENT YELLOW GREEN.		SHS
		1	24	12	2.00																												SIGN ID CODE W16-9p SIGN SHALL BE FLOURESCENT YELLOW GREEN.		SHS
					ALL SIGNS SIZES WERE INSTALLED PER PLAN. SEE LAYOUT SHEETS FOR LOCATIONS																																
195+64.0, RT		2	48	12	8.00						1					X		X															TOP MOUNTING BRACKET REQUIRED TO INSTALL SIGN ON POST. COSTS ASSOCIATED WITH THIS BRACKET ARE INCIDENTAL TO THE SIGN POST. SIGN ID CODE D3-1	131	
195+88.0, RT		1	30	30	6.25						1					X		X															SIGN ID CODE R1-1		SHS
195+88.0, RT							1				1					X		X															SALVAGED SIGN SHALL BE MOUNTED ON NEW POST.		
195+90.0, LT		1	24	24	4.00						1					X		X															SIGN ID CODE R8-3		SHS
		1	24	12	2.00																												SIGN ID CODE M4-6		E-140
195+93.0, LT		2 2	36 30	12 12	6.00 5.00						1					X		X															TOP MOUNTING BRACKET REQUIRED TO INSTALL SIGN ON POST. COSTS ASSOCIATED WITH THIS BRACKET ARE INCIDENTAL TO THE SIGN POST. SIGN ID CODE D3-1 SIGN ID CODE D3-1	131 131	
	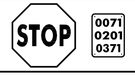	1 1	30 6	30 10	6.25 0.42																												BACK-TO-BACK SIGN ID CODE R1-1 SIGN ID CODE VD-700		SHS E-138
196+20.0, RT		1 1	30 6	30 10	6.25 0.42						1					X		X															BACK-TO-BACK SIGN ID CODE R1-1 SIGN ID CODE VD-700		SHS E-138
												LF	LF	LF	LF	LF 98	LF		EA.	LB	LB	LB		LB	LB	LB	LB								
TOTALS			SF 52.84	SF	EA. 1	SF						LF			LF 98					LB			EA.	LB				EA.	EA.	LB					

FINAL POST LENGTHS ARE TO BE DETERMINED IN THE FIELD. POST SIZES ARE COMPUTED BASED ON INFORMATION FURNISHED ON THE STANDARD SHEETS AND THE VTRANS "SIGN POST DESIGN GUIDELINE."

TRAFFIC SIGN SUMMARY SHEET #3

PROJECT NAME: ARLINGTON-DORSET

PROJECT NUMBER: STP 2625(I)

FILE NAME: p06c218.dgn
PROJECT LEADER: D.E.G.
DESIGNED BY: D.W.E.
IPARM FILE: p06c218tss03.i

PLOT DATE: $DATE$
DRAWN BY: C.A.K.
CHECKED BY: M.J.L.
SHEET 102 OF 143