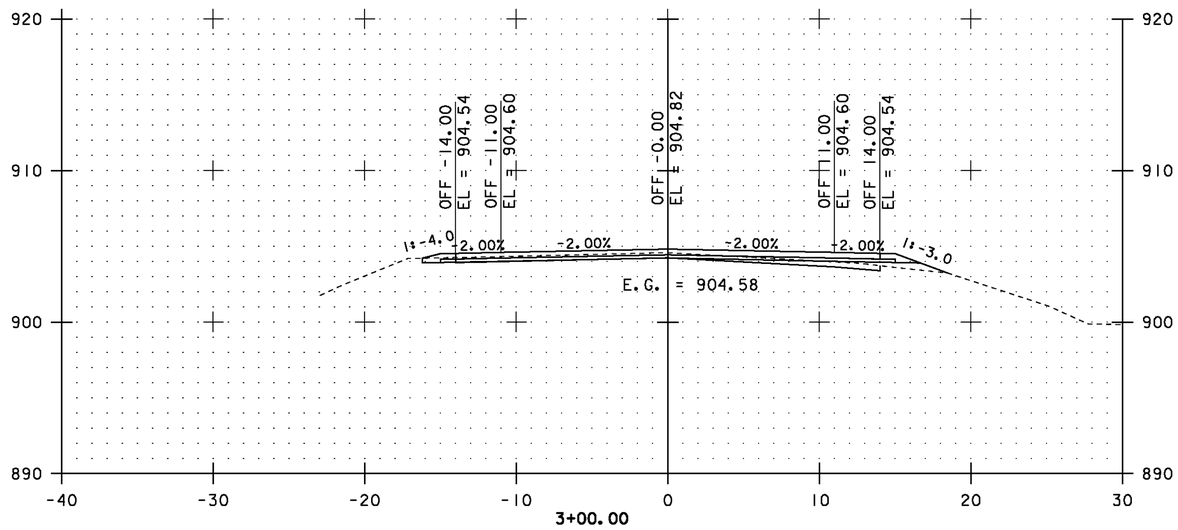

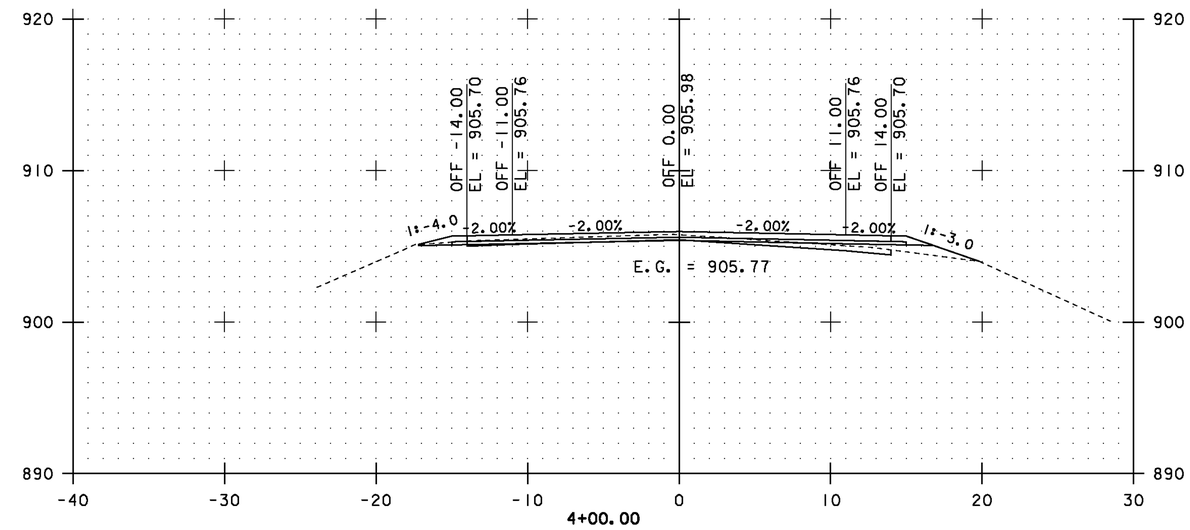

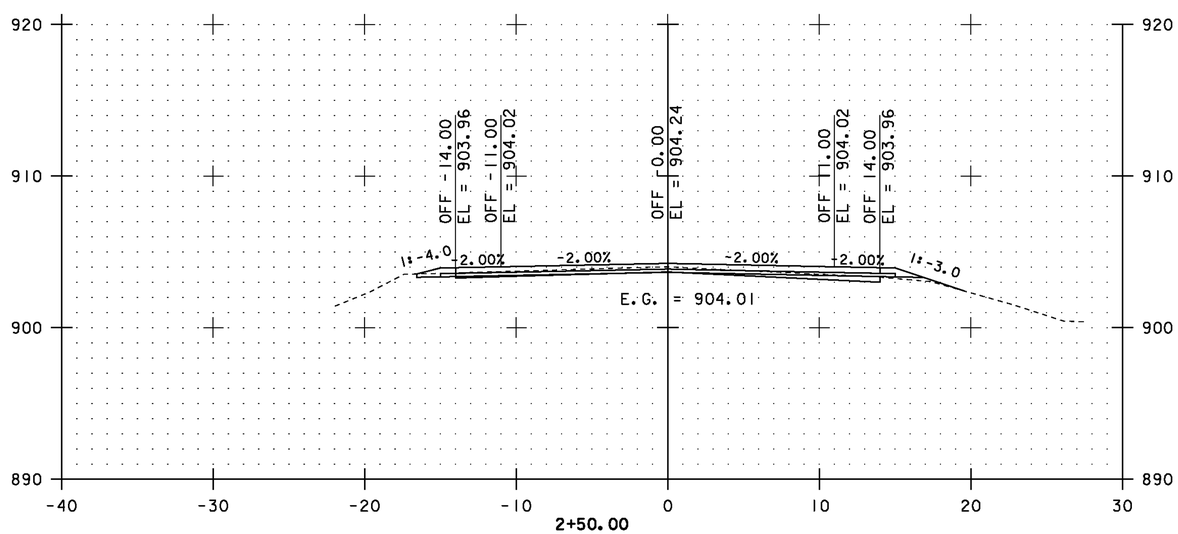

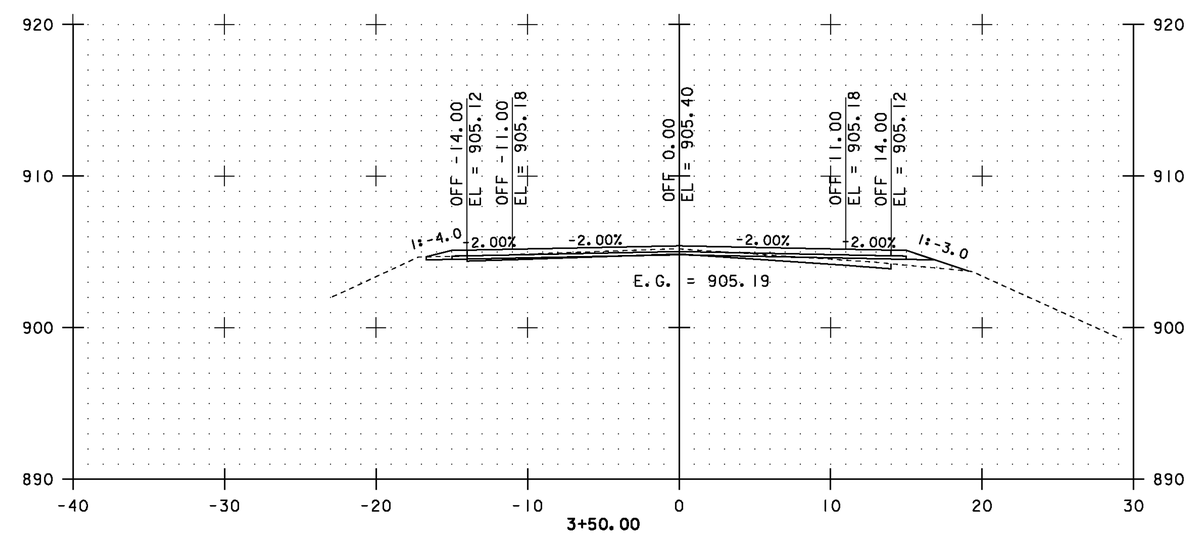

STA. 2+50.00 TO STA. 4+00.00

Stantec

CROSS SECTIONS SHEET #2

PROJECT NAME: COVENTRY-NEWPORT CITY
PROJECT NUMBER: STP 2308(1)

FILE NAME: p01c052.dgn
PROJECT LEADER: JLL
DESIGNED BY: STANTEC
IPARM FILE: p01c052xss02.i

PLOT DATE: 18-MAY-2012
DRAWN BY: STANTEC
CHECKED BY: STANTEC
SHEET 52 OF 107