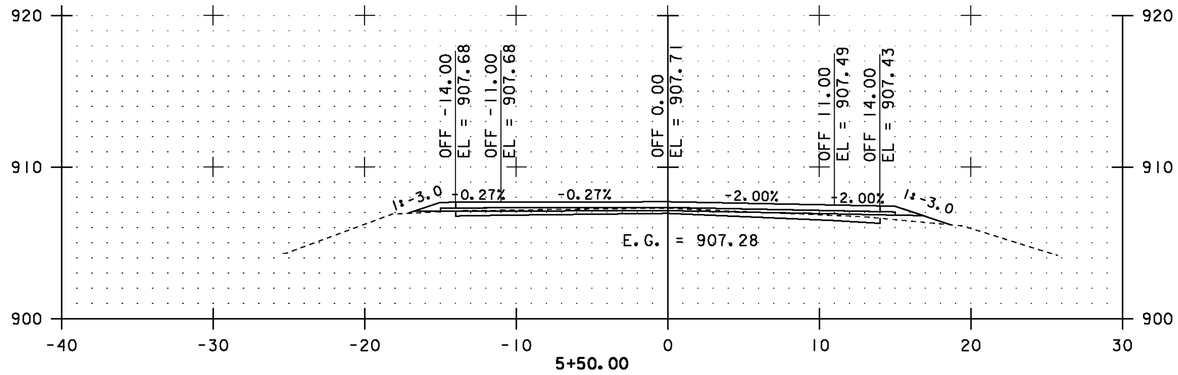


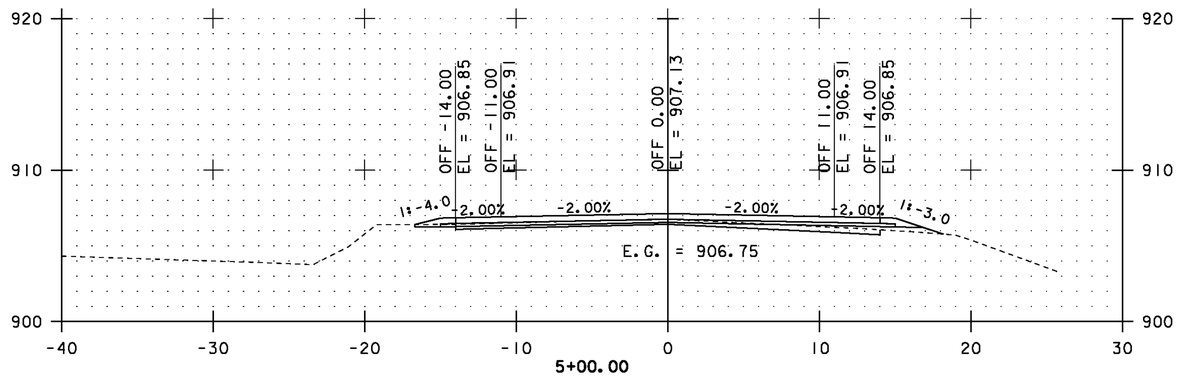


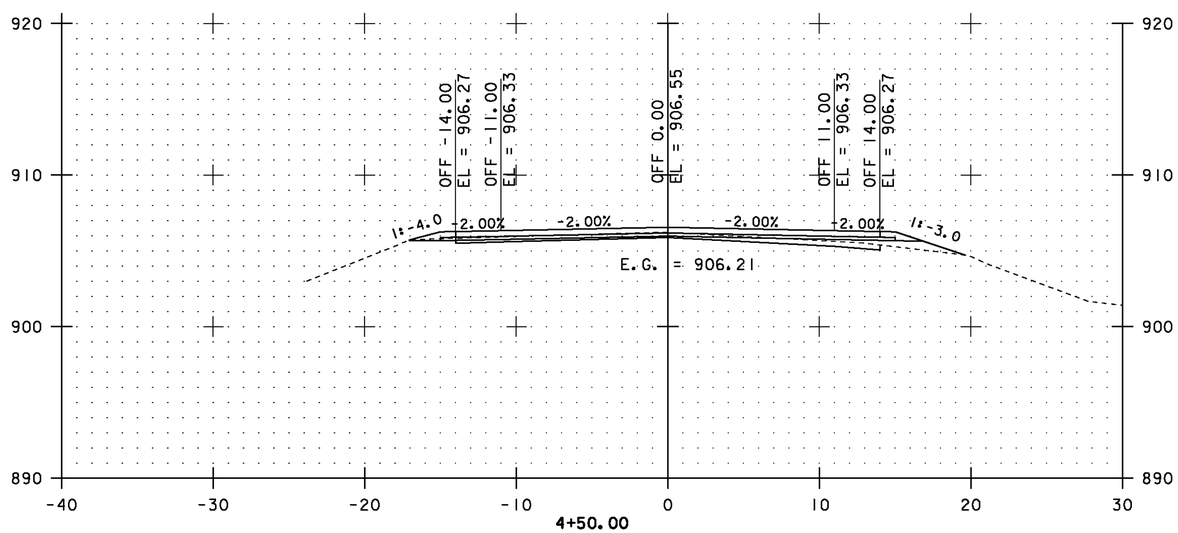


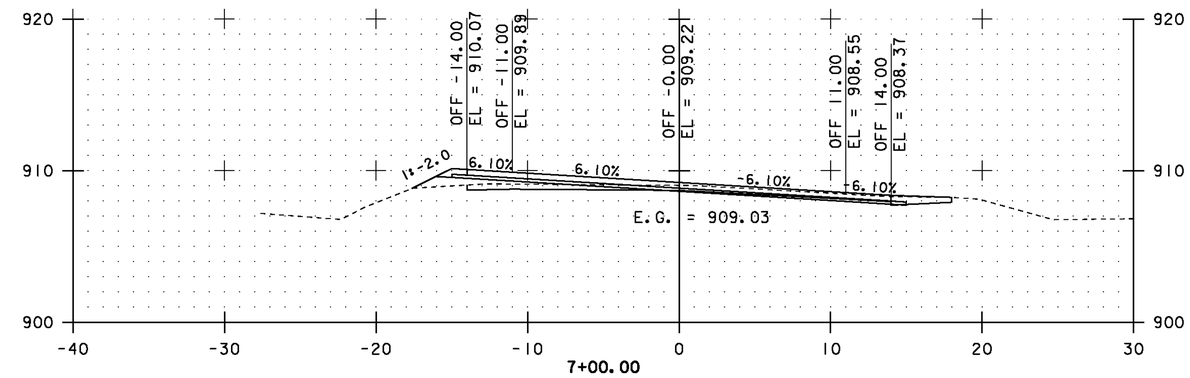


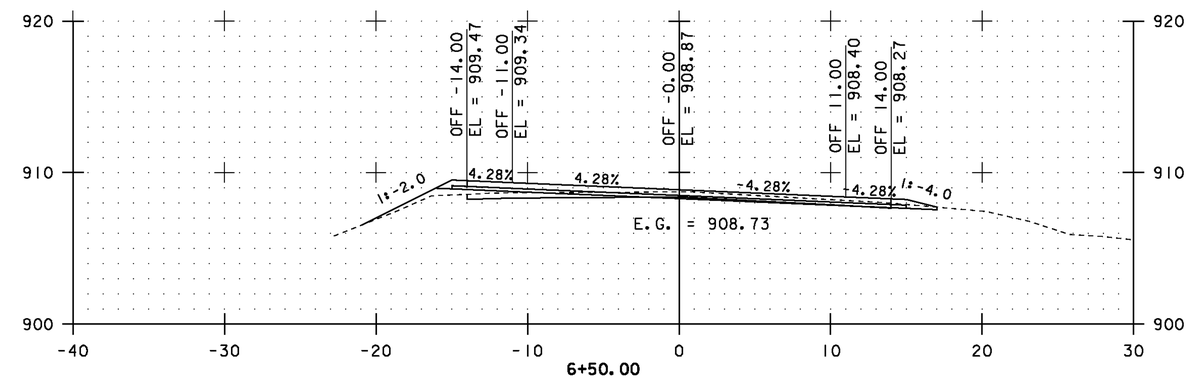


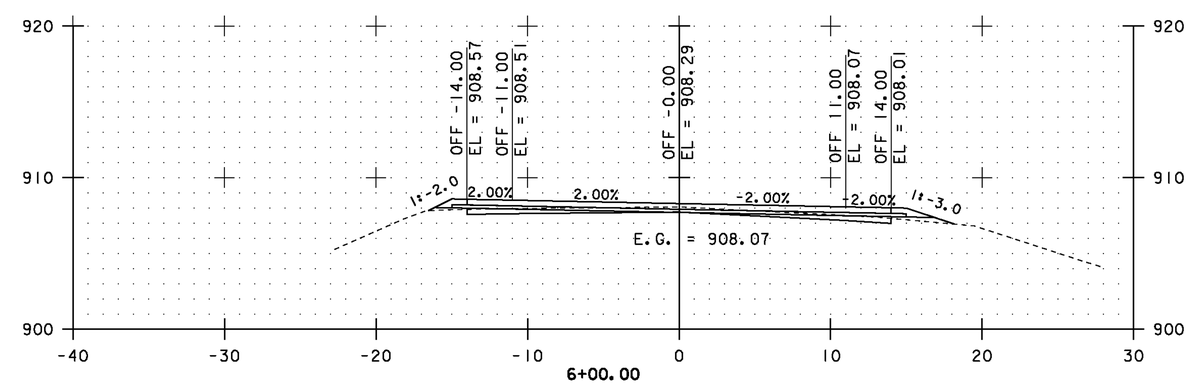


STA. 4+50.00 TO STA. 7+00.00

Stantec

**CROSS SECTIONS SHEET #3**

PROJECT NAME: COVENTRY-NEWPORT CITY
PROJECT NUMBER: STP 2308(1)

FILE NAME: p01c052.dgn
PROJECT LEADER: JLL
DESIGNED BY: STANTEC
**IPARM FILE: p01c052xss03.i**

PLOT DATE: 18-MAY-2012
DRAWN BY: STANTEC
CHECKED BY: STANTEC
SHEET 53 OF 107