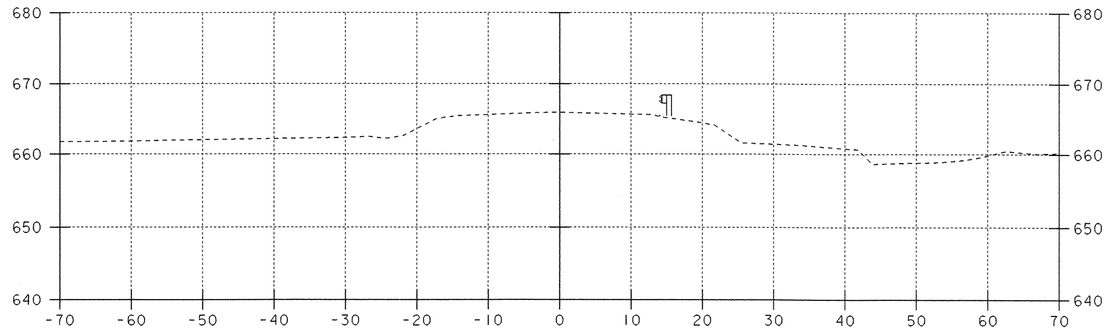

12+00

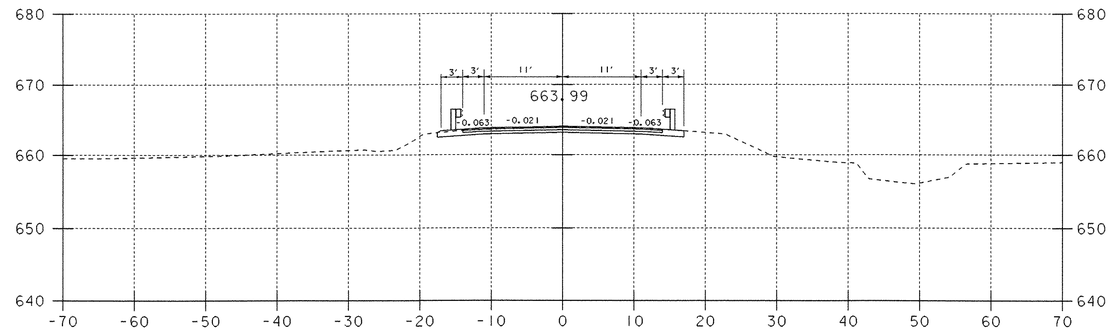

12+57

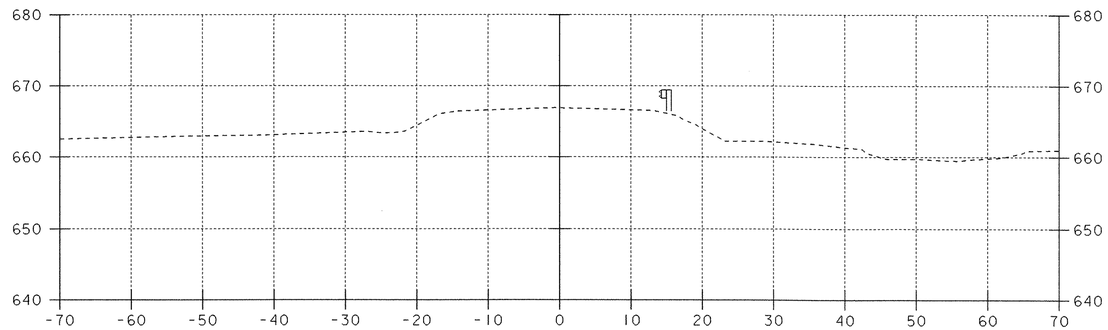

11+75

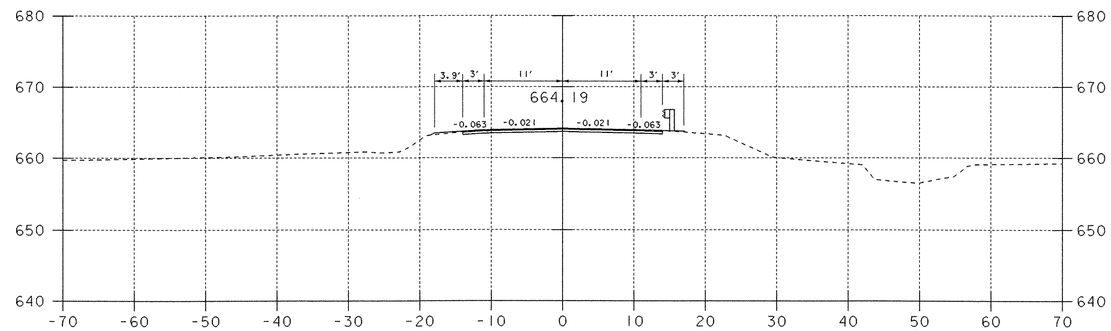

12+50

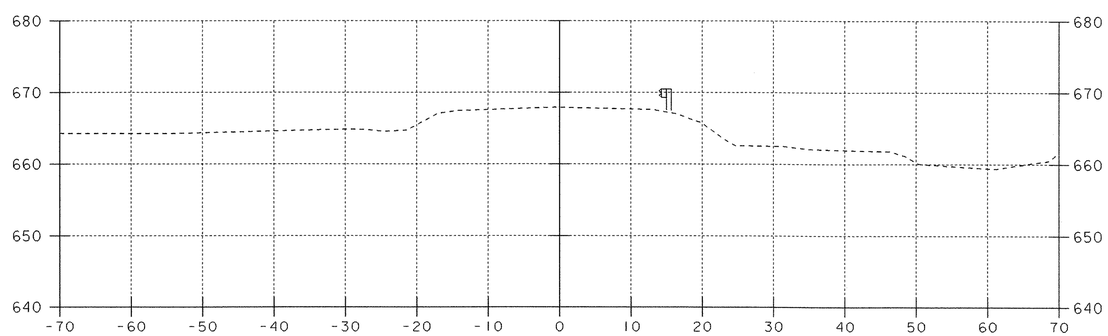

11+50

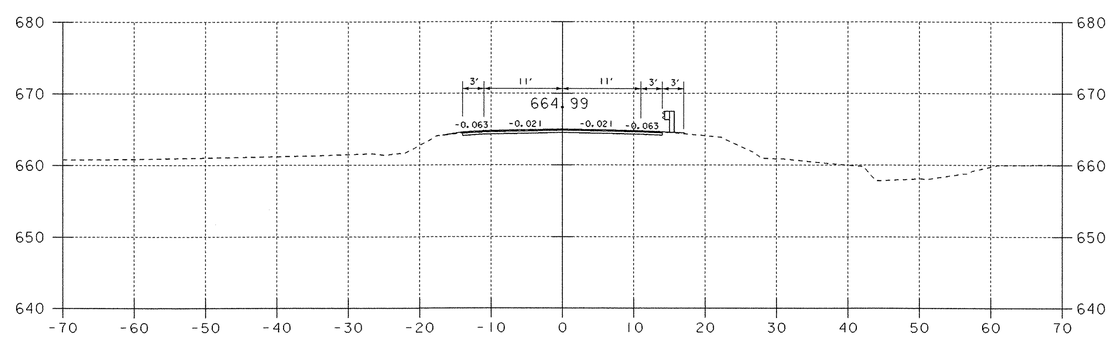

12+25
BEGIN APPROACH

ROADWAY CROSS SECTIONS

PROJECT NAME: FAIRFIELD
PROJECT NUMBER: AC STP ST 0298 (6)

FILE NAME: str5/01c182/sc182bdr.dgn
PROJECT LEADER: C. Keller
DESIGNED BY: J. Reed
sc182xs2.i

PLOT DATE: 28-APR-2005
DRAWN BY: J. Reed
CHECKED BY: W.B. Symonds
SHEET 31 OF 41