VAOT Metric

TEMPORARY AND DURABLE 100mm WHITE LINE
STA 9+700 TO 9+854 SOLID LT
STA 9+700 TO 9+763 SOLID RT
STA 9+739 TO 9+742 SOLID RT (NO PARKING)
STA 9+747 TO 9+763 SOLID RT (NO PARKING)
STA 9+763 TO 9+770 SOLID RT (TH 380)
STA 9+775 TO 9+783 SOLID RT (TH 380)
STA 9+783 TO 9+889 SOLID RT (NO PARKING)
STA 9+787 TO 9+791 SOLID LT (NO PARKING)
STA 9+783 TO 9+885 SOLID RT
STA 9+849 TO 9+854 SOLID LT (NO PARKING)
STA 9+954 TO 9+859 SOLID LT (TH 310)
STA 9+867 TO 9+872 SOLID LT (TH 310)
STA 9+872 TO 9+877 SOLID LT (NO PARKING)
STA 9+872 TO 9+885 SOLID LT

TEMPORARY AND DURABLE 100mm YELLOW LINE
STA 9+700 TO 9+767 SOLID LT & RT
STA 9+721 TO 9+727 SOLID LT & RT (ISLAND APPROACH)
STA 9+779 TO 9+857 SOLID LT & RT
STA 9+863 DOUBLE SOLID LT (TH 310)
STA 9+869 TO 9+885 SOLID LT & RT

DURABLE 600mm STOP BAR ~~(TYPE I TAPE)~~
STA 9+863 LT (TH 310)

TEMPORARY 600mm STOP BAR
STA 9+863 LT (TH 310)

DURABLE LETTER OR SYMBOL ~~(TYPE I TAPE)~~
STA 9+860 LT - "STOP" (TH 310)

TEMPORARY LETTERS OR SYMBOLS
STA 9+860 LT - "STOP" (TH 310)

DURABLE 200mm YELLOW LINE
STA 9+721 TO 9+727 SOLID LT & RT

CHANGING ELEV. OF DI, CB, OR MH
STA 9+836 RT (DMH)
STA 9+856 LT (TMH)

REHABILITATION OF DI, CB, OR MH, CLASS I
STA 9+702 LT (CB)
STA 9+702 RT (CB)
STA 9+764 LT (CB)
STA 9+764 RT (CB)
STA 9+781 RT (CB)
STA 9+823 LT (CB)
STA 9+836 RT (CB)
STA 9+859 LT (CB)-TH 310
STA 9+867 LT (CB)-TH 310
STA 9+872 RT (CB)
STA 9+875 LT (CB)

ADJUST ELEVATION OF VALVE BOX
STA 9+701 RT
STA 9+773 RT
STA 9+788 LT
STA 9+865 LT
STA 9+866 LT

CHANGING ELEVATION OF SEWER MANHOLE
STA 9+769 RT
STA 9+826 RT
STA 9+861 RT

PAINTED CURB
STA 9+700 TO 9+707 LT
STA 9+700 TO 9+721 RT
STA 9+712 TO 9+721 LT

REMOVING SIGNS
AS SHOWN - ~~13~~ 13
ERECTING SALVAGED SIGNS
AS SHOWN - 4
SALVAGED T.I.S.
AS SHOWN - 1

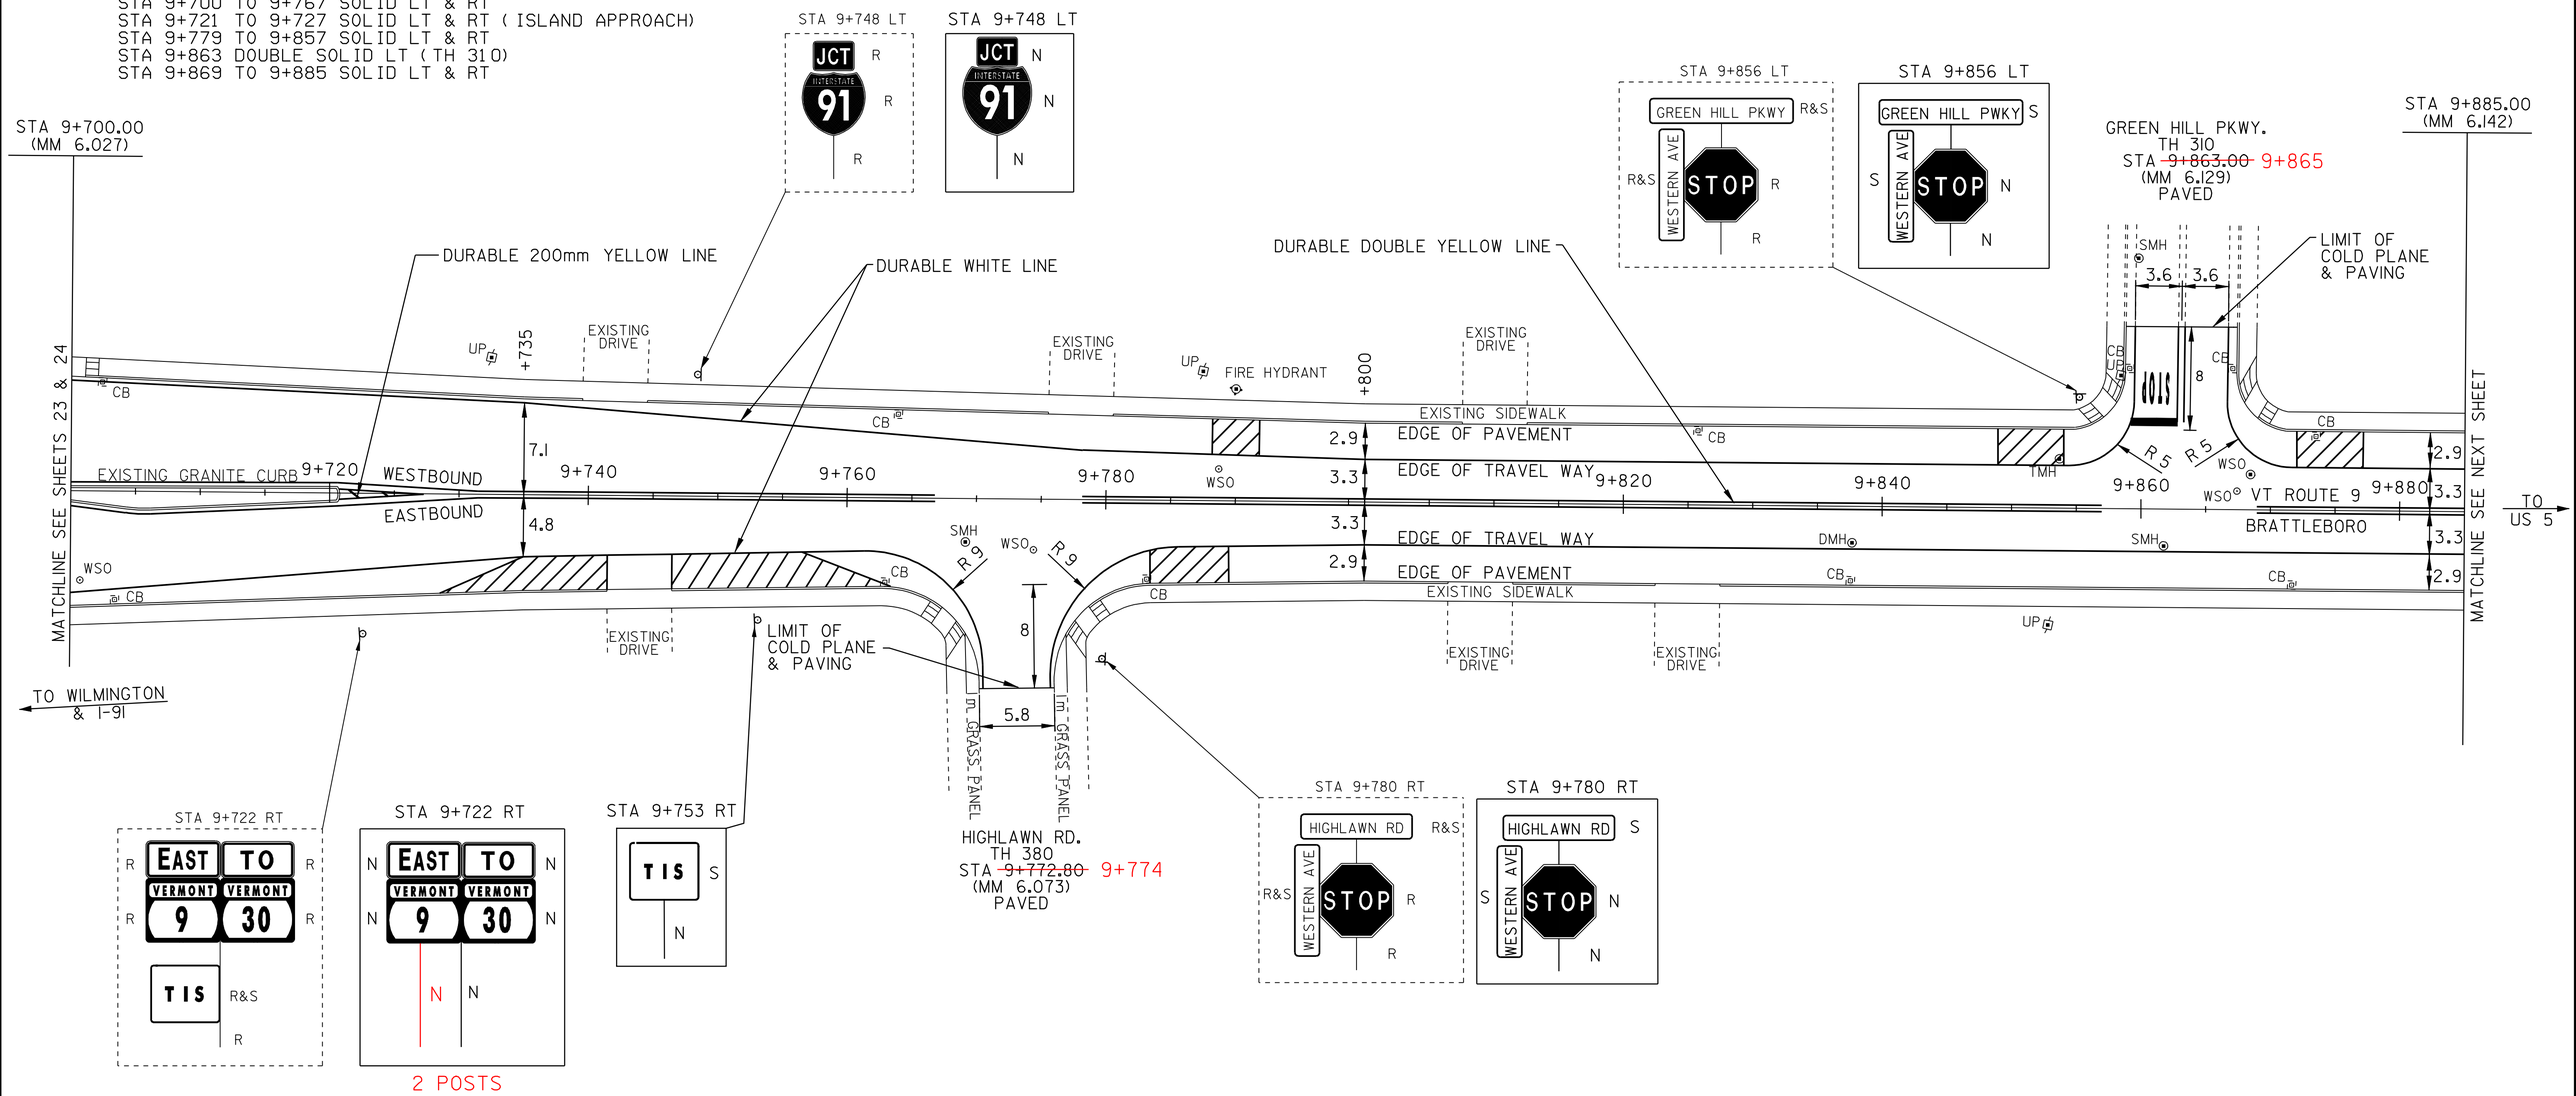

NOT TO SCALE

LEGEND

R	=	REMOVE EXISTING
S	=	SALVAGE
R&S	=	REMOVE AND SALVAGE
N	=	NEW
RET	=	RETAIN
B-B	=	BACK TO BACK

NOTE: ALL DIMENSIONS IN METERS EXCEPT AS INDICATED

PAVING PROJECT LAYOUT #17

PROJECT NAME: BRATTLEBORO
PROJECT NUMBER: ST-STP 2303(I)S

FILE NAME: /PAVE/OID026/PD026.dgn PLOT DATE: $DATE$
PROJECT LEADER: WRH DRAWN BY: JAC
DESIGNED BY: - CHECKED BY: NLL
CLD REF. NO.: pd026ll7.1 SHEET 25 OF 55