VAOT Metric

TEMPORARY AND DURABLE 100mm WHITE LINE
STA 10+580 TO 10+596 SOLID LT (NO PARKING)
STA 10+580 TO 10+660 SOLID RT
STA 10+580 TO 10+643 SOLID LT
STA 10+638 TO 10+643 SOLID LT (NO PARKING)
STA 10+656 TO 10+760 SOLID LT
STA 10+656 TO 10+695 SOLID LT (NO PARKING)
STA 10+660 TO 10+690 SOLID RT (TH 462)
STA 10+685 TO 10+690 SOLID RT (TH 462)
STA 10+690 TO 10+760 SOLID RT

DURABLE 100mm WHITE LINE ~~(TYPE I TAPE)~~
STA 10+580 TO 10+590 DOTTED LT (LANE LINE)

TEMPORARY AND DURABLE 100mm YELLOW LINE
STA 10+580 TO 10+644 SOLID LT & RT
STA 10+656 TO 10+664 SOLID LT & RT
STA 10+670 TO 10+681 SOLID LT & RT
STA 10+670 TO 10+681 SOLID RT (PAINTED ISLAND)-TH 462
STA 10+687 TO 10+760 SOLID LT & RT

DURABLE 200mm YELLOW LINE
STA 10+670 TO 10+680 SOLID RT (ISLAND W/DIAG LINES)

DURABLE LETTER OR SYMBOL ~~(TYPE I TAPE)~~
STA 10+685 RT-"STOP" (TH 462)

TEMPORARY LETTERS OR SYMBOLS
STA 10+685 RT-"STOP" (TH 462)

DURABLE 600mm STOP BAR ~~(TYPE I TAPE)~~
STA 10+682 RT (TH 462)

TEMPORARY 600mm STOP BAR
STA 10+682 RT (TH 462)

REHABILITATION OF DI, CB, OR MH, CLASS I
STA 10+645 LT (CB)
STA 10+653 RT (CB)
STA 10+660 LT (CB)
STA 10+734 RT (CB)
STA 10+735 LT (CB)

CHANGING ELEV. OF DI, CB, OR MH
STA 10+600 LT (TMH)

CHANGING ELEVATION OF SEWER MANHOLE
STA 10+667 RT
STA 10+670 RT

ADJUST ELEVATION OF VALVE BOX
STA 10+587 RT
STA 10+650 RT
STA 10+666 RT
STA 10+681 RT-TH 462
STA 10+689 RT
STA 10+729 RT
STA 10+755 RT
STA 10+756 LT
STA 10+757 RT

ERECTING SALVAGED SIGNS
AS SHOWN - 4

REMOVING SIGNS
AS SHOWN - 18

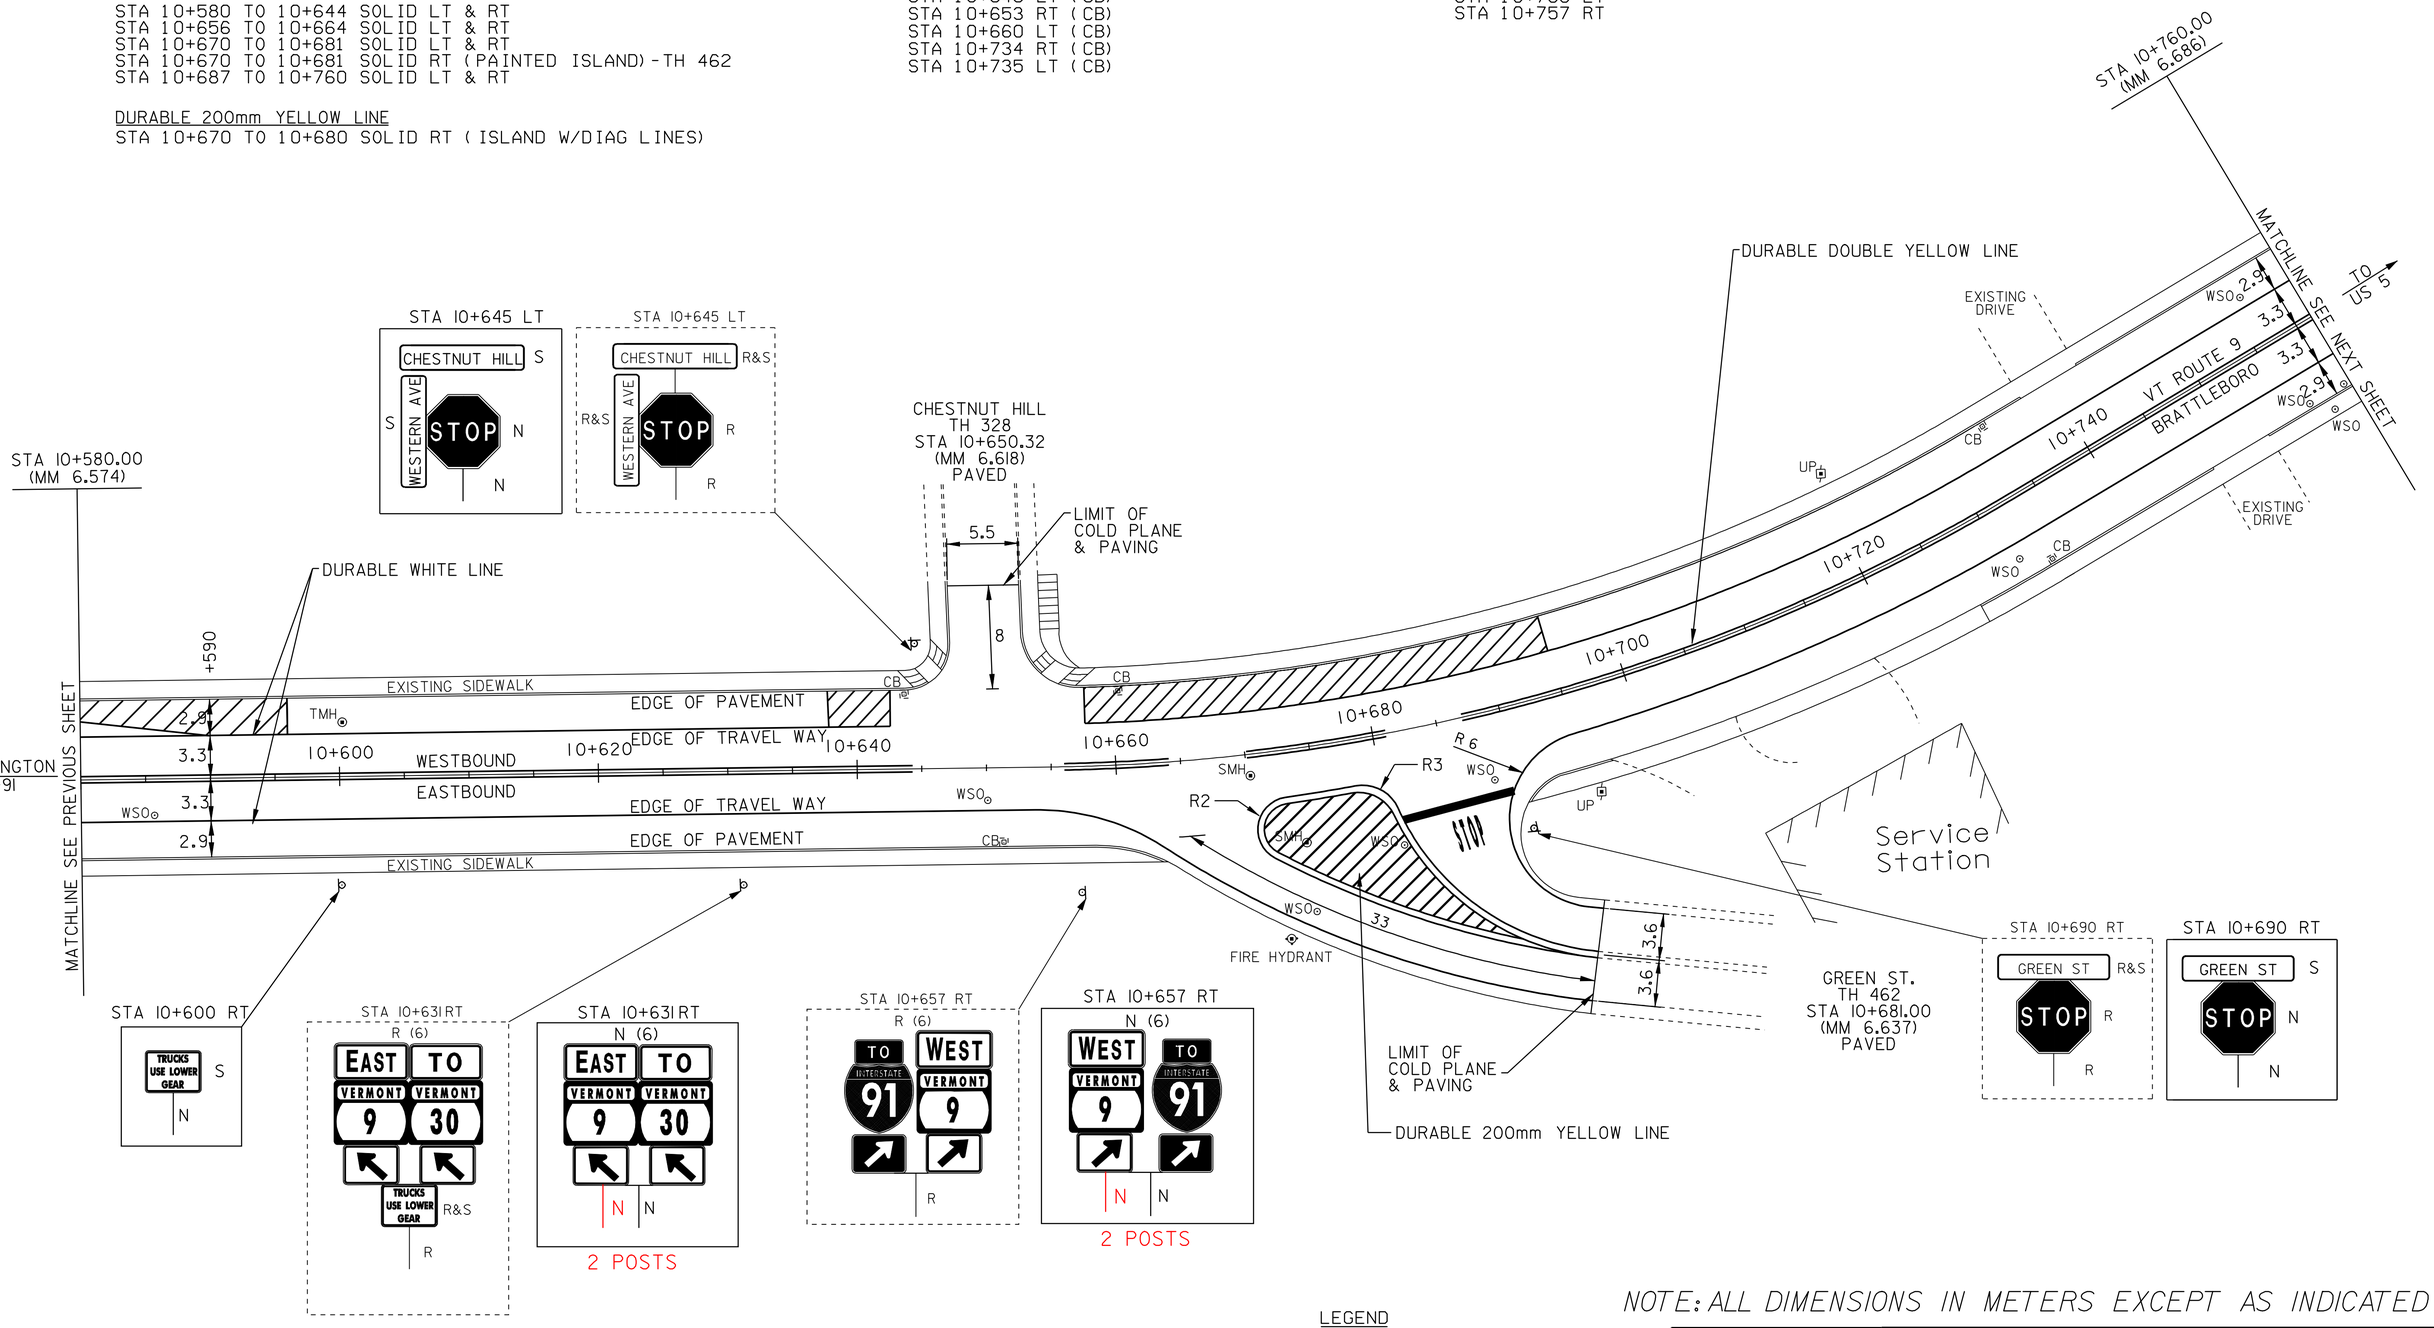

NOT TO SCALE

NOTE: ALL DIMENSIONS IN METERS EXCEPT AS INDICATED

LEGEND

R	=	REMOVE EXISTING
S	=	SALVAGE
R&S	=	REMOVE AND SALVAGE
N	=	NEW
RET	=	RETAIN
B-B	=	BACK TO BACK

PAVING PROJECT LAYOUT #22

PROJECT NAME: BRATTLEBORO
PROJECT NUMBER: ST-STP 2303(I)S

FILE NAME: /PAVE/OIDO26/PDO26.dgn
PROJECT LEADER: WRH
DESIGNED BY: -
CLD REF. NO.: pd026122.i
PLOT DATE: $DATE$
DRAWN BY: JAC
CHECKED BY: NLL
SHEET 30 OF 55