STATE OF VERMONT
AGENCY OF TRANSPORTATION

TRAFFIC SIGN SUMMARY SHEET 10

VAOT Metric

KILOMETER MARKER, STATION, OR SIGN NUMBER	SIGN LEGEND	SIGN DIMENSIONS EA	WIDTH (mm)	HEIGHT (mm)	NEW & SALVAGED SIGNS "A"	"B"	SALV SIGN	SALV TIS	EXIST POST RETAIN	EXIST POST SALVAGE	NEW SIGN POSTS NO. OF POSTS	FLANGED CHANNEL kg/m 1.7	3.0	4.5	SQUARE STEEL (mm) kg/m 44 3.4	49 3.9	63 5.0	ANCHOR	SLEEVE	TUBULAR ALUMINUM Ø (mm) kg/m 75 1.9	100 2.5	100 MOD 2.5	TUBULAR STEEL Ø (mm) FOUNDATION	kg/m 75 11.3	89 13.4	100 16.1	125 21.7	W-SHAPE STEEL FTG. SIZE 600 mm	750 mm	WEIGHT	POST SIZE	SIGN FRAME REQUIRED	REMARKS	SIGN DETAIL DETAIL ON SHEET NUMBER	STD. SHEET NUMBER
														OPTION ITEMS																							
STA 9+554 LT	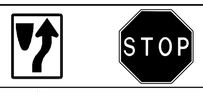	1	600	750	0.45						1			X 13′		X																	BACK TO BACK		E-144M
		1	750	750	0.56																														E-143M
		1	450	450	0.20																														E-150M
STA 9+556 RT		1	600	300	0.18						2			X		X																X	RETAIN POSTS		E-136BM
		1	600	300	0.18																														E-136BM
		1	600	300	0.18																														E-136BM
		1	600	600	0.36																														E-136BM
		1	600	600	0.36																														E-136BM
		1	600	600	0.36																														E-136BM
		1	525	375	0.20																														E-136BM
		1	525	375	0.20																														E-136BM
		1	525	375	0.20																														E-136BM
STA 9+586 RT		1	1200	750	0.90						1			X 9.5′		X																		E-145M
STA 9+626 LT		1	750	750	0.56						1			X 13′		X																	BACK TO BACK		E-143M
		1	750	750	0.56																														E-143M
		1	900	300	0.27																														E-142M
		1	900	300	0.27																														E-142M
STA 9+628 LT		1	760	764	0.58						1			13′																					
STA 9+639 LT		1	600	750	0.45						1			X 13′		X																	BACK TO BACK		E-144M
		1	750	750	0.56																														E-143M
		1	450	450	0.20																														E-150M
STA 9+639 RT		1	600	300	0.18						2			X		X																X	RETAIN POSTS		E-136BM
		1	600	300	0.18																														E-136BM
		1	600	300	0.18																														E-136BM
		1	600	600	0.36																														E-136BM
		1	600	600	0.36																														E-136BM
		1	600	600	0.36																														E-136BM
		1	525	375	0.20																														E-136BM
		1	525	375	0.20																														E-136BM
		1	525	375	0.20																														E-136BM
												m	m	m 36.8	m	m 36.8	m		EA	kg	kg	kg		kg	kg	kg	kg								
TOTALS		m² ~~9.42~~ 10	m²	EA.	m²							m ~~36.8~~ 61.5′ = 18.75m			m ~~36.8~~					kg	EA.	kg		EA.	EA.	kg								

FINAL POST LENGTHS ARE TO BE DETERMINED IN THE FIELD. POST SIZES ARE COMPUTED BASED ON INFORMATION FURNISHED ON THE STANDARD SHEETS AND THE TRAFFIC & SAFETY DIVISION'S "SIGN POST DESIGN GUIDELINE."

FUR 12-21-04

DAN TYLER

PROJECT NAME: BRATTLEBORO
PROJECT NUMBER: ST-STP 2303(I)S

FILE NAME: /PAVE/OID026/PD026.dgn
PROJECT LEADER: WRH
DESIGNED BY: -
CLD REF. NO.: pd026tss10.1
PLOT DATE: $DATE$
DRAWN BY: JAC
CHECKED BY: NLL
SHEET 44 OF 55