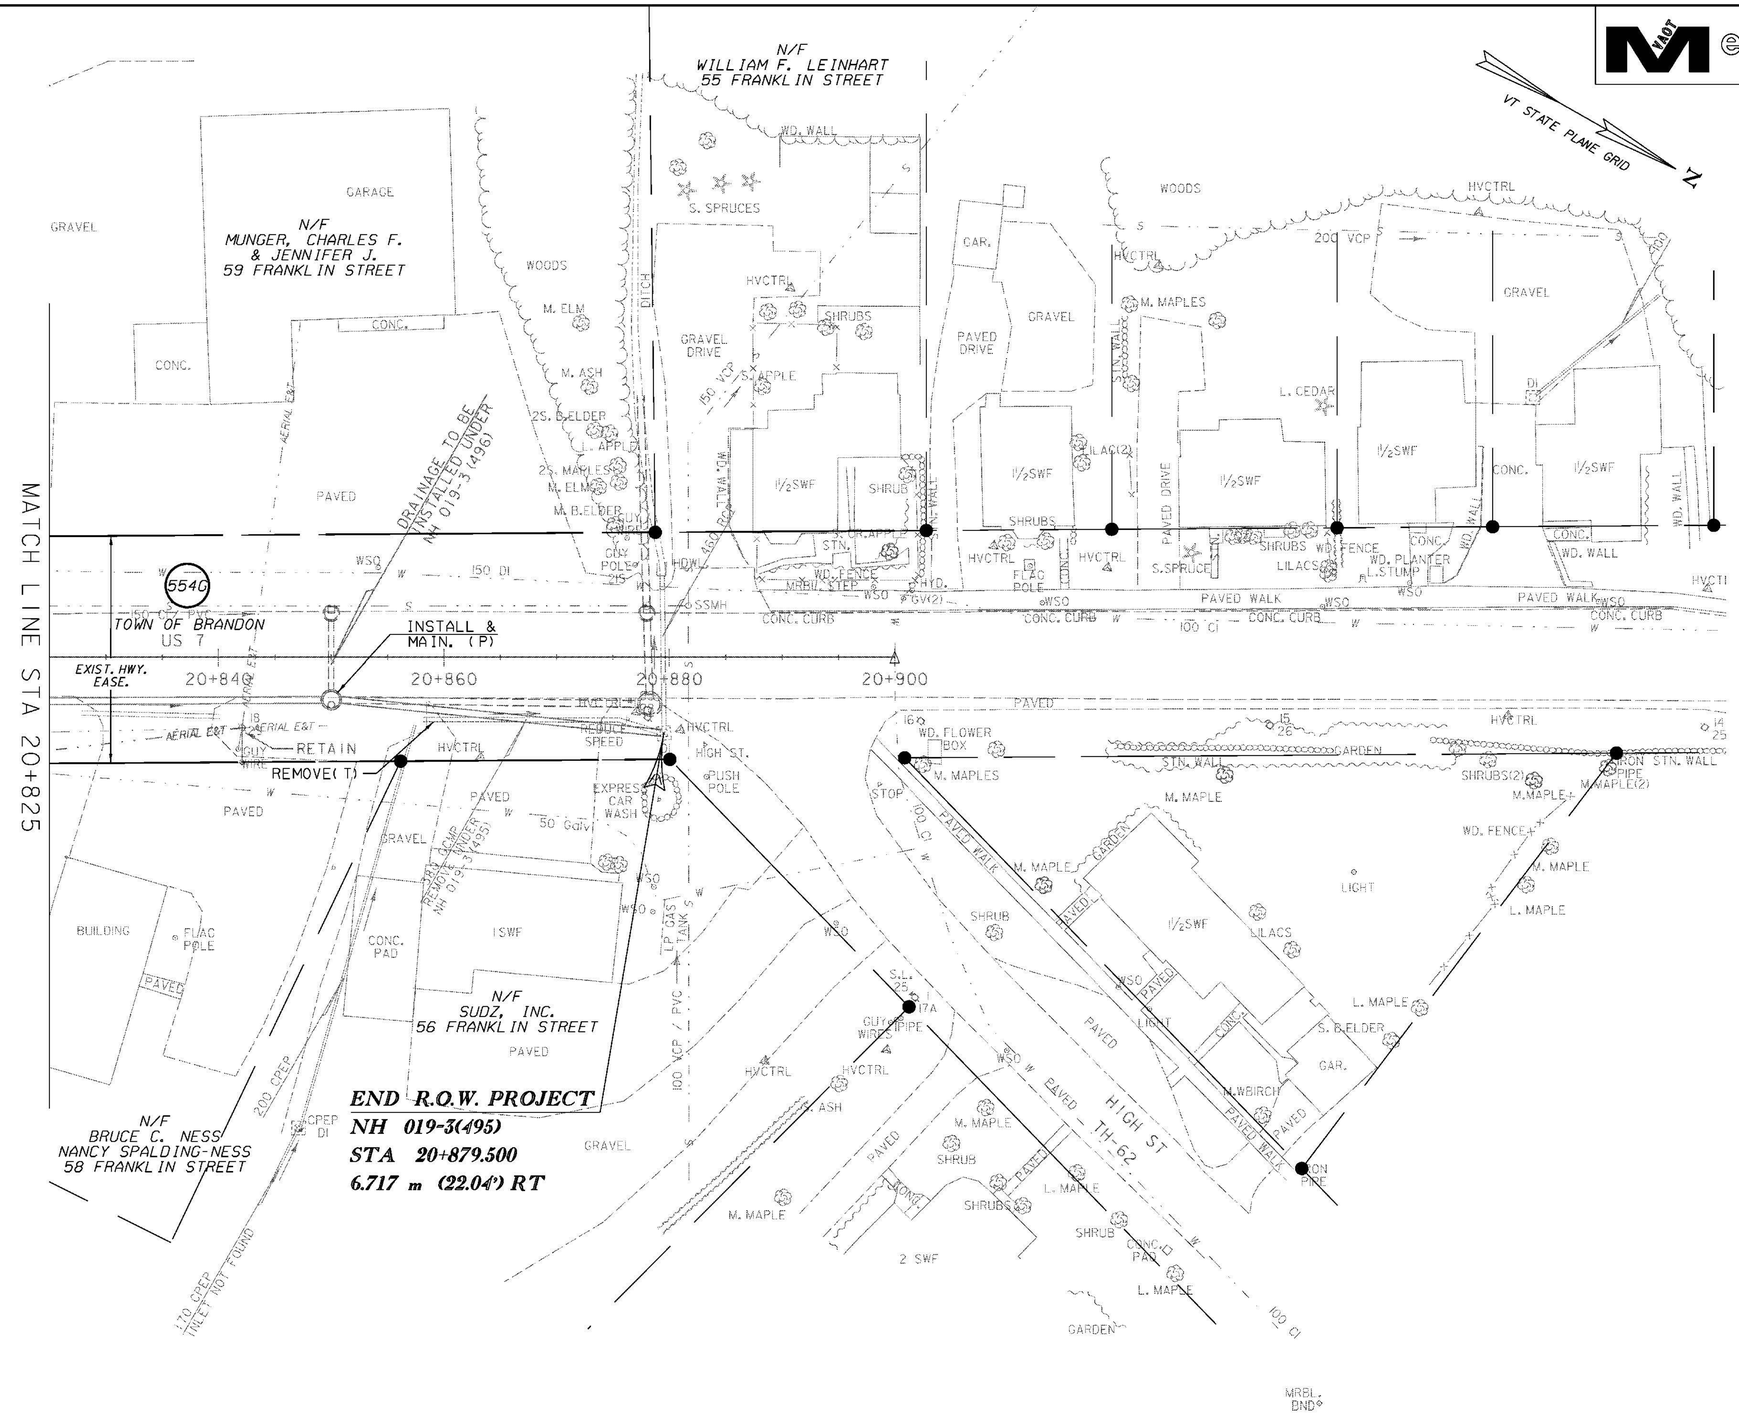

LINES SHOWN ON THIS PLAN AS EXISTING PROPERTY LINES (P/L) ARE BELIEVED TO BE ACCURATE BUT SHOULD NOT BE RELIED UPON FOR PURPOSES UNRELATED TO THE STATE OF VERMONT ACQUISITION OF LAND AND RIGHTS FOR THIS PROJECT

WATER - BRANDON FIRE DISTRICT #1
SEWER - TOWN OF BRANDON, WASTEWATER TREATMENT.

⊗ DENOTES TREE OR STUMP REMOVAL

0 10 20 30
SCALE IN METERS

RIGHT-OF-WAY LAYOUT 29

PROJECT NAME: BRANDON
PROJECT NUMBER: NH 019-3(495)

FILE NAME: zb008s5-ROW29.dgn
PROJECT LEADER: CRB
DESIGNED BY: PTS
ROW SHEET 49 OF 164

PLOT DATE: 9/3/2009
DRAWN BY: JCS
CHECKED BY: PTS
SHEET 64 OF 546