CONSTRUCT DRIVES
STA 16+730.0 RT - 6.8 m WIDE, PAVED-COMM.
STA 16+775.0 LT - 7.2 m WIDE, PAVED-COMM.

REMOVAL AND DISPOSAL OF GUARDRAIL
STA 16+749.4 - 16+764.7 LT
STA 16+783.6 - 16+807.0 LT

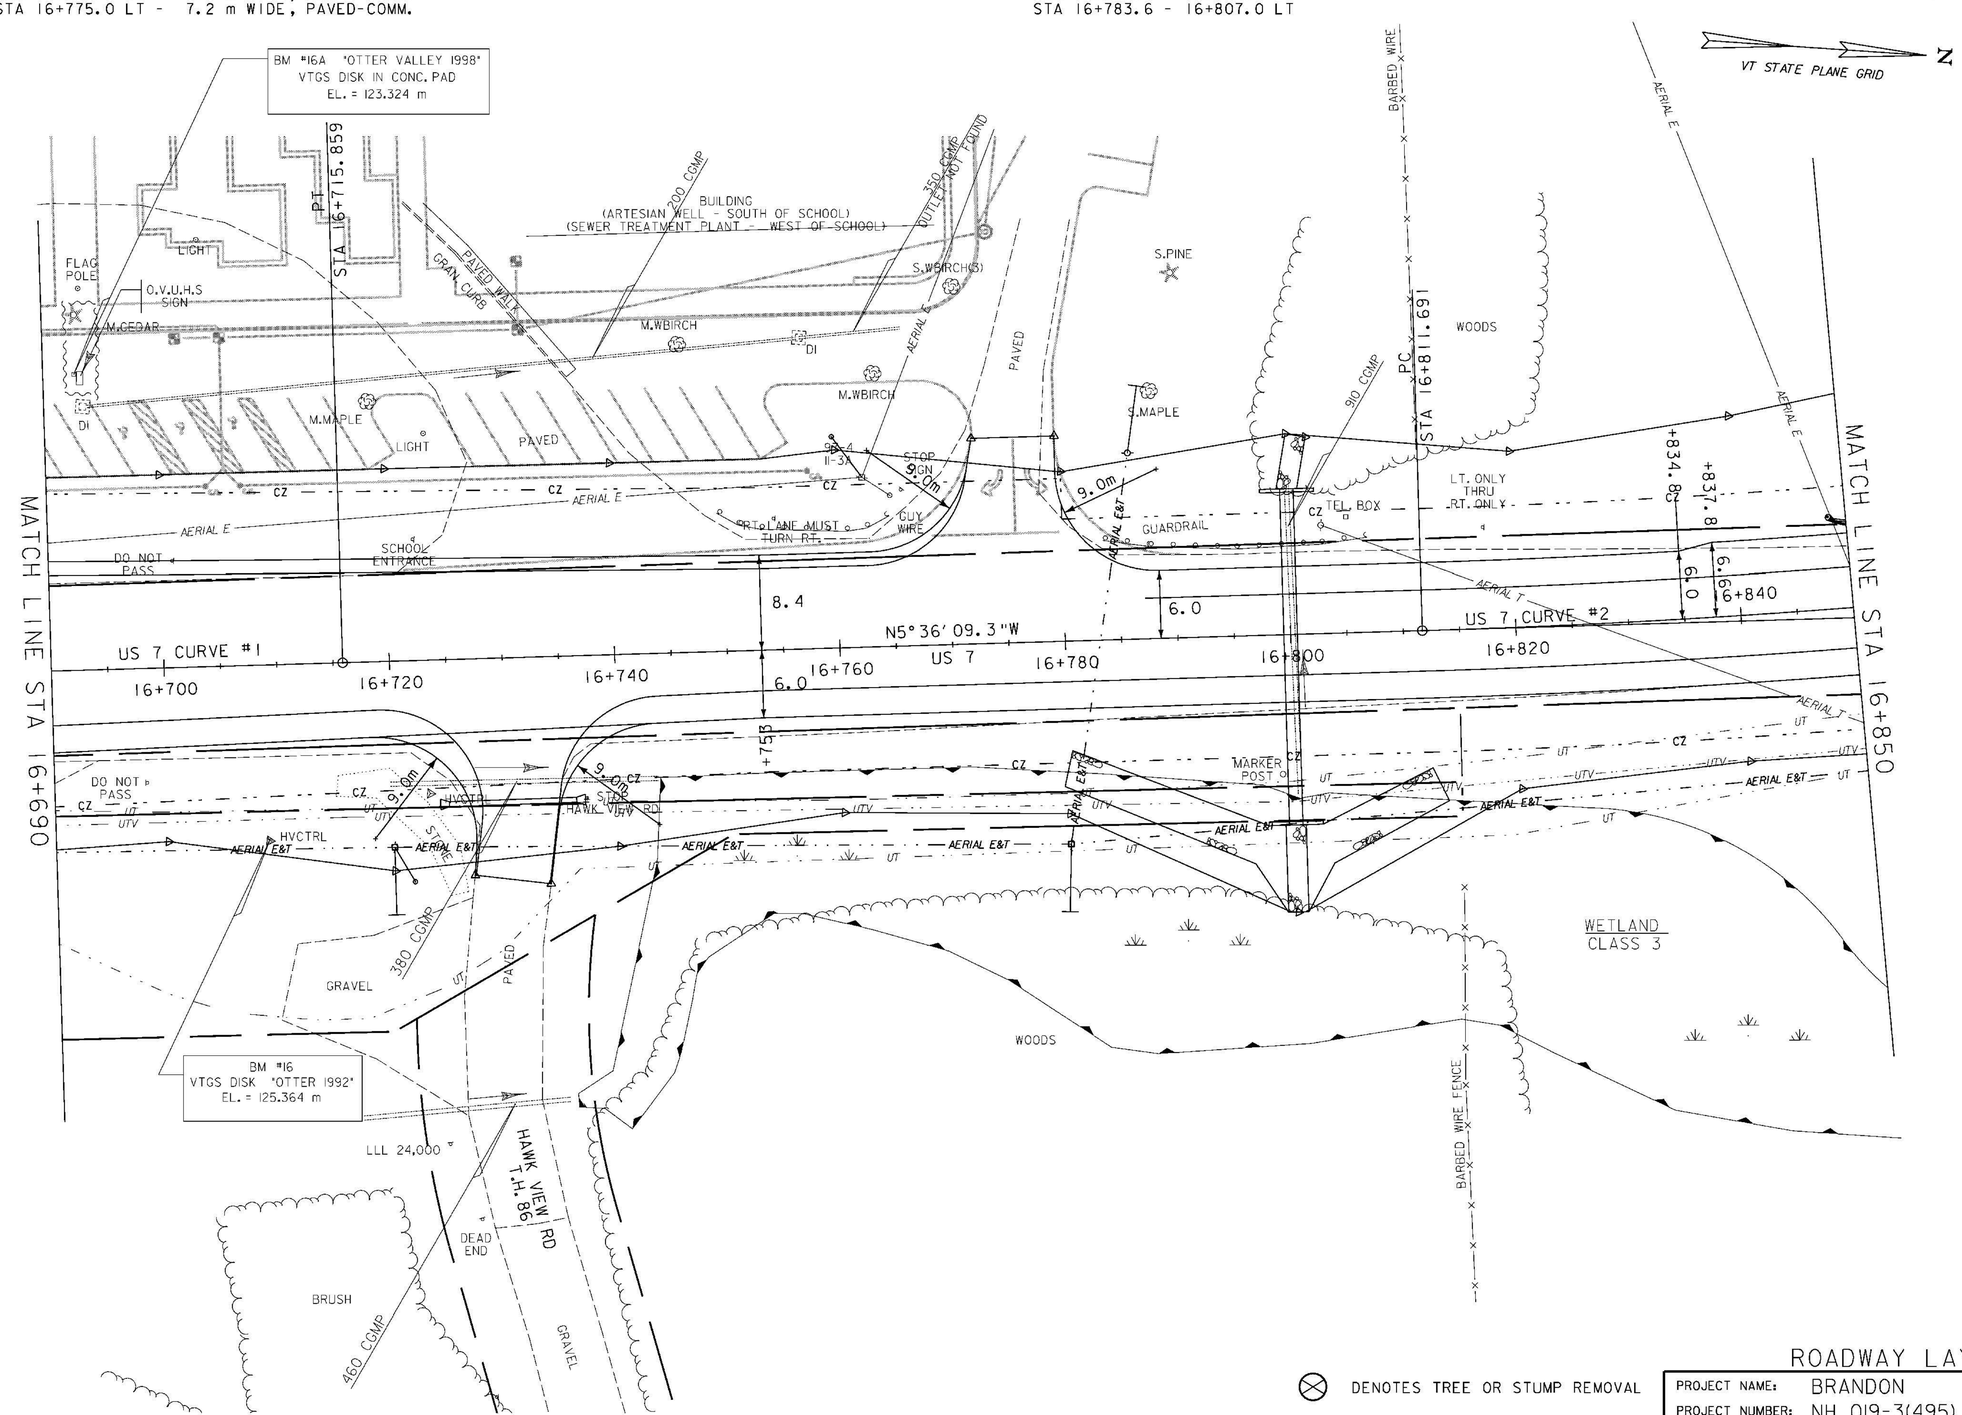

⊗ DENOTES TREE OR STUMP REMOVAL

0 10 20 30
SCALE IN METERS

ROADWAY LAYOUT 3

PROJECT NAME: BRANDON	
PROJECT NUMBER: NH 019-3(495)	
FILE NAME: zb008s5-gen03.dgn	PLOT DATE: 9/3/2009
PROJECT LEADER: CRB	DRAWN BY: NLL
DESIGNED BY: DAM	CHECKED BY: PTS
CLD 02-0149	SHEET 72 OF 546