

STONE FILL, TYPE I (IN DITCHES)
 GEOTEXTILE UNDER STONE FILL
 STA 18+025 - 18+035 RT

TEMPORARY STONE CHECK DAM, TYPE I
 STA 17+950 - 18+070 LT
 STA 17+950 - 18+010 RT



TEMPORARY EROSION MATTING (IN DITCHES)
 STA 17+950 - 18+070 LT
 STA 17+950 - 18+010 RT

PROJECT DEMARCATION FENCE
 STA 17+950 - 18+070 LT
 STA 17+950 - 18+011 RT
 STA 18+040 - 18+060 RT
 STA 18+062 - 18+083 RT
 STA 18+100 - 18+110 LT

INLET PROTECTION DEVICE, TYPE I
 STA 18+012 RT
 STA 18+035 RT

GEOTEXTILE FOR SILT FENCE
 STA 18+039 - 18+100 RT (3)

BARRIER FENCE
 STA 18+070 - 18+100 LT
 STA 18+083 - 18+110 RT

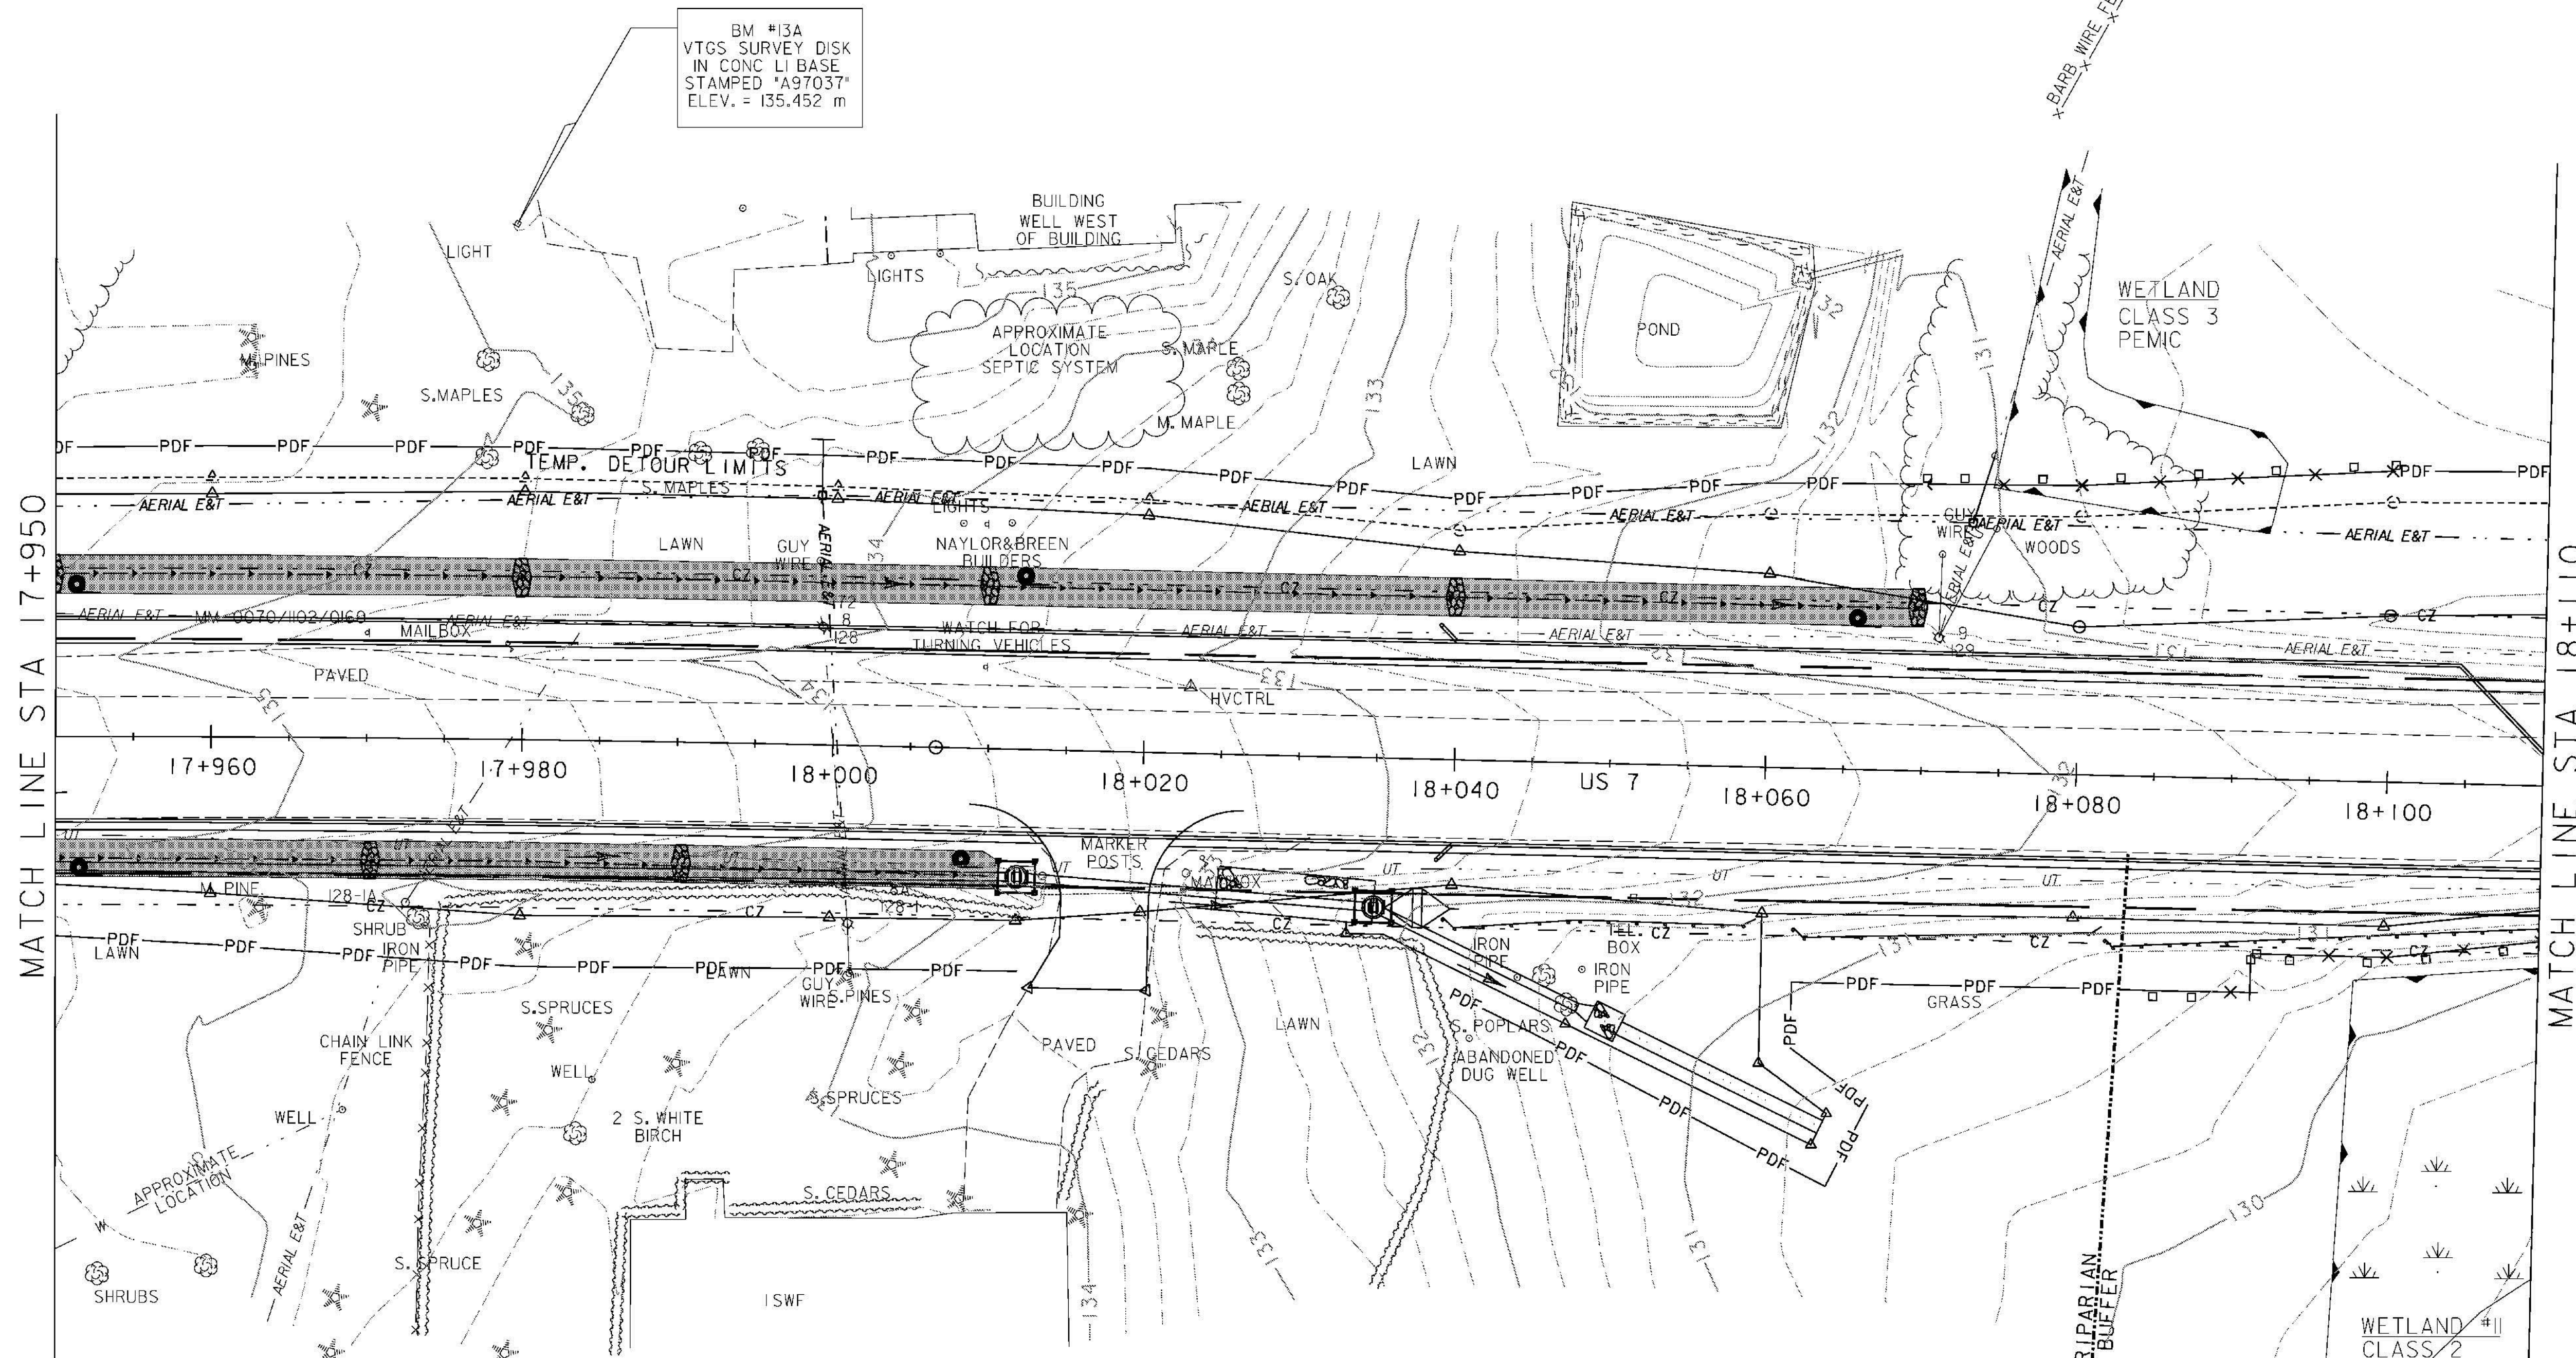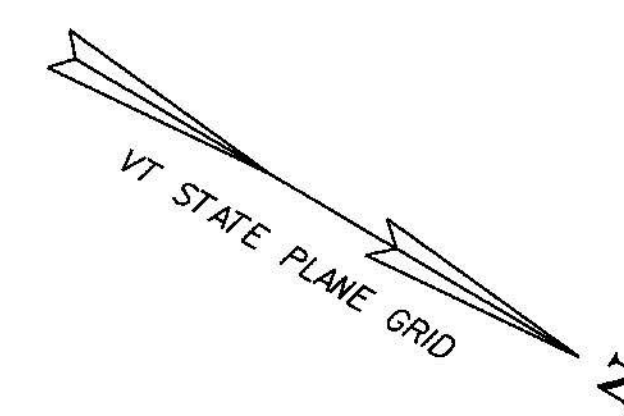

MATCH LINE STA 17+950

MATCH LINE STA 18+110

LEGEND	
	ROADSIDE DITCH/SLOPE PROTECTION
	DETOUR SLOPE LIMITS
	PERMANENT SLOPE LIMITS
	SILT FENCE
	INLET PROTECTION DEVICE, TYPE I
	PIPE INLET PROTECTION
	EROSION MATTING
	CHECK DAM - TEMPORARY
	BARRIER FENCE
	PROJECT DEMARCATION FENCE
	FILTER CURTAIN

- NOTES:**
- SILT FENCE LOCATIONS SHOWN ON THIS DRAWING ARE APPROXIMATE. THE CONTRACTOR IS RESPONSIBLE FOR INSTALLING THE SILT FENCE IN ACCORDANCE WITH THE GUIDELINES SET FORTH IN THE VERMONT GENERAL PERMIT FOR STORMWATER RUNOFF FROM CONSTRUCTION SITES. THE RESIDENT ENGINEER AND ON SITE COORDINATOR SHALL APPROVE ALL SILT FENCE LOCATIONS PRIOR TO PLACEMENT.
 - FOR EROSION PREVENTION AND SEDIMENT CONTROL PLAN GENERAL NOTES, SEE SHEETS 147 - 148, AND DETAILS, SEE SHEETS 177 - 180.



EROSION CONTROL PLAN II	
PROJECT NAME:	BRANDON
PROJECT NUMBER:	NH 019-3(495)
FILE NAME:	zb008s5-ec11.dgn
PROJECT LEADER:	CRB
DESIGNED BY:	NLL
CLD 02-0149	
PLOT DATE:	9/3/2009
DRAWN BY:	NLL
CHECKED BY:	PTS
	SHEET 159 OF 546