

TEMPORARY STONE CHECK DAM, TYPE 1
 STA 18+350 LT
 STA 18+360 RT

INLET PROTECTION DEVICE, TYPE 1
 STA 18+298 LT


TEMPORARY EROSION MATTING (IN DITCHES)
 STA 18+270 - 18+283 LT
 STA 18+299 - 18+380 LT
 STA 18+420 - 18+430 LT

TEMPORARY EROSION MATTING (ON SLOPES)
 STA 18+380 - 18+410 RT


GEOTEXTILE FOR SILT FENCE
 STA 18+270 - 18+336 RT (4)
 STA 18+425 - 18+427 RT

PROJECT DEMARCATION FENCE
 STA 18+270 - 18+287 LT
 STA 18+270 - 18+415 RT
 STA 18+292 - 18+430 LT

BARRIER FENCE
 STA 18+415 - 18+430 RT

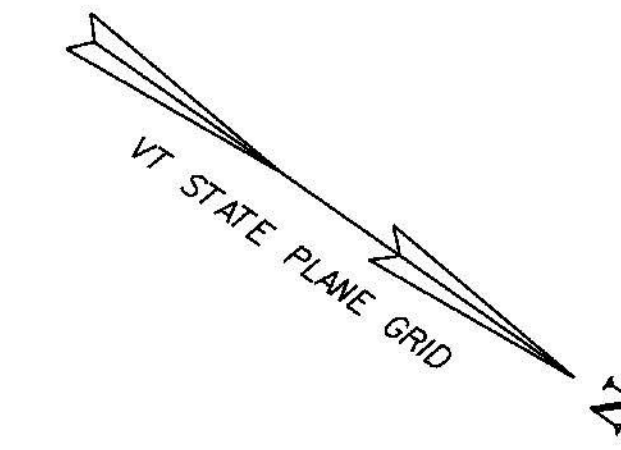

BM #12
 VT SURVEY R-O-W DISK
 STAMPED '864 1989'
 ELEV. = 133.788 m

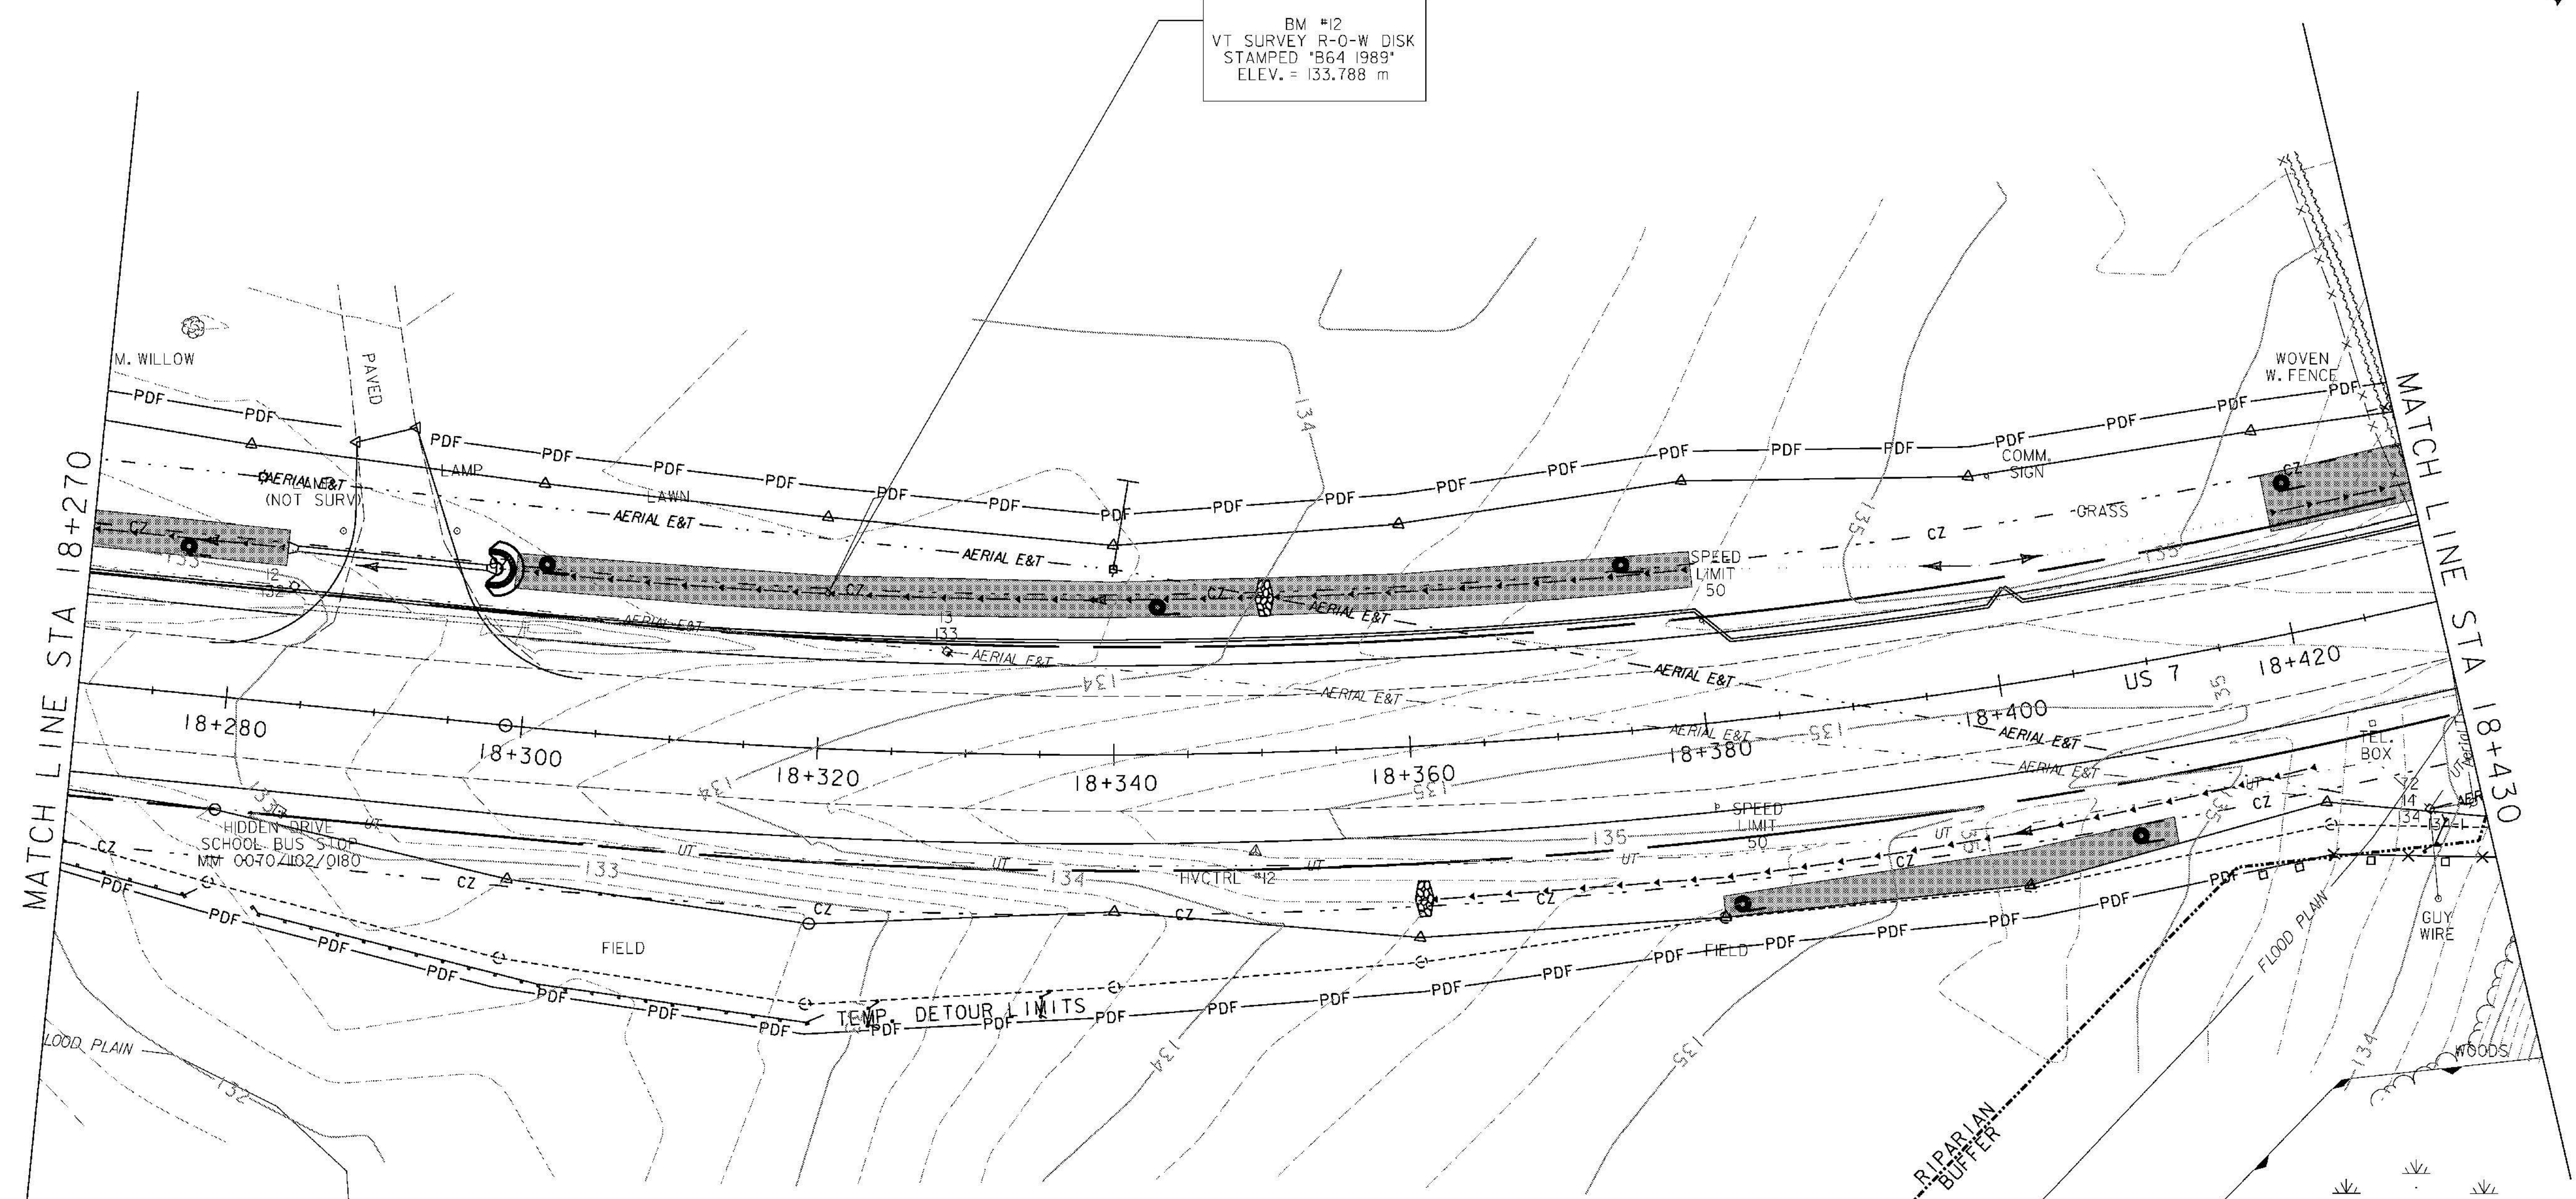

LEGEND

- ROADSIDE DITCH/SLOPE PROTECTION
- DETOUR SLOPE LIMITS
- PERMANENT SLOPE LIMITS
- SILT FENCE
- INLET PROTECTION DEVICE, TYPE 1
- PIPE INLET PROTECTION
- EROSION MATTING
- CHECK DAM - TEMPORARY
- BARRIER FENCE
- PROJECT DEMARCATION FENCE
- FILTER CURTAIN

NOTES:

1. SILT FENCE LOCATIONS SHOWN ON THIS DRAWING ARE APPROXIMATE. THE CONTRACTOR IS RESPONSIBLE FOR INSTALLING THE SILT FENCE IN ACCORDANCE WITH THE GUIDELINES SET FORTH IN THE VERMONT GENERAL PERMIT FOR STORMWATER RUNOFF FROM CONSTRUCTION SITES. THE RESIDENT ENGINEER AND ON SITE COORDINATOR SHALL APPROVE ALL SILT FENCE LOCATIONS PRIOR TO PLACEMENT.
2. FOR EROSION PREVENTION AND SEDIMENT CONTROL PLAN GENERAL NOTES, SEE SHEETS 147 - 148, AND DETAILS, SEE SHEETS 177 - 180.

WETLAND #12
 CLASS 2
 PSSI/EMY

EROSION CONTROL PLAN 13

PROJECT NAME:	BRANDON	PLOT DATE:	9/3/2009
PROJECT NUMBER:	NH 019-3(495)	DRAWN BY:	NLL
FILE NAME:	zb008s5-ec13.dgn	CHECKED BY:	PTS
PROJECT LEADER:	CRB	CLD 02-0149	SHEET 161 OF 546

