

STONE FILL, TYPE II (ON SLOPES)
 GEOTEXTILE UNDER STONE FILL
 STA 18+620 - 18+681 LT
 STA 18+685 - 18+730 LT

TEMPORARY STONE CHECK DAM, TYPE I
 STA 18+640 LT

INLET PROTECTION DEVICE, TYPE I
 STA 18+593 LT
 STA 18+593 RT
 STA 18+689 LT

TEMPORARY EROSION MATTING (ON SLOPES)
 STA 18+590 - 18+620 LT
 STA 18+730 - 18+750 LT



TEMPORARY EROSION MATTING (IN DITCHES)
 STA 18+720 - 18+750 LT

GEOTEXTILE FOR SILT FENCE
 STA 18+590 - 18+740 RT

GEOTEXTILE FOR FILTER CURTAIN
 STA 18+590 - 18+597 RT

PROJECT DEMARCATION FENCE
 STA 18+590 - 18+683 LT
 STA 18+688 - 18+750 LT

BARRIER FENCE
 STA 18+595 - 18+750 RT

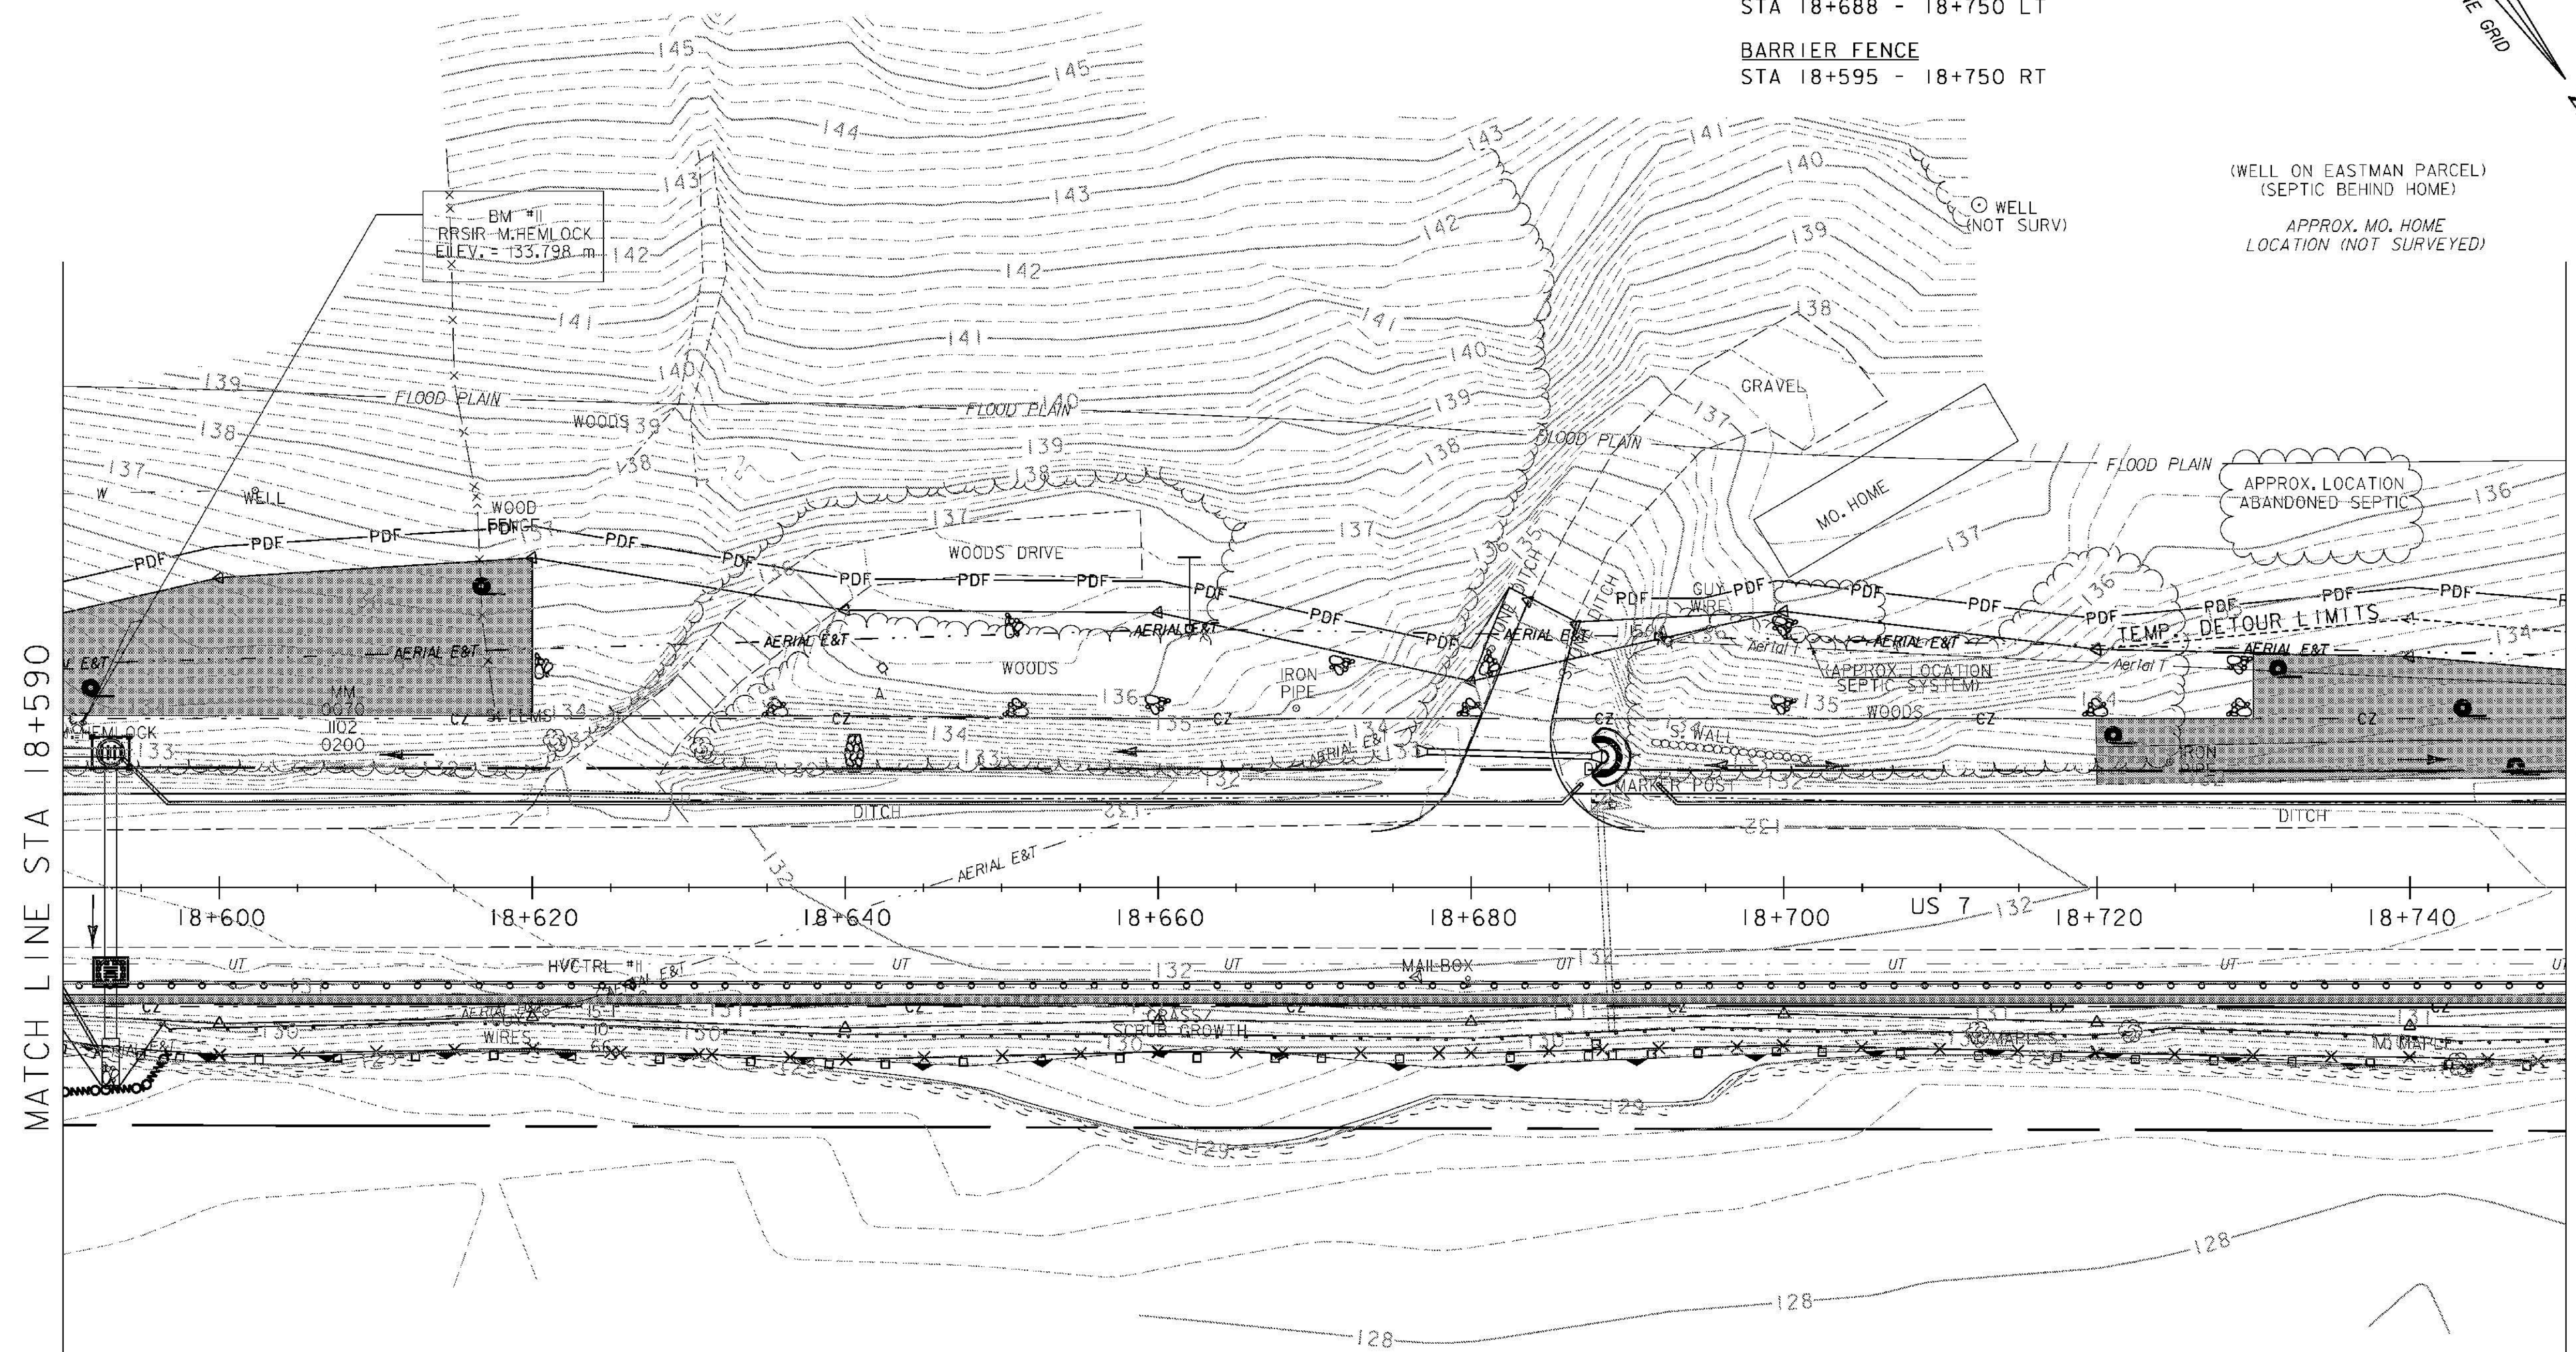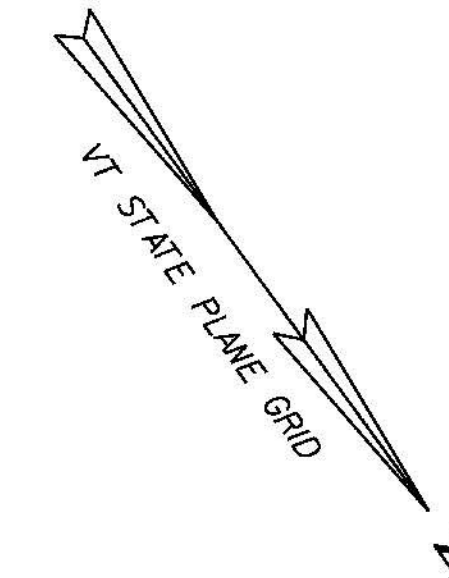

MATCH LINE STA 18+590

MATCH LINE STA 18+750

LEGEND	
	ROADSIDE DITCH/SLOPE PROTECTION
	DETOUR SLOPE LIMITS
	PERMANENT SLOPE LIMITS
	SILT FENCE
	INLET PROTECTION DEVICE, TYPE I
	PIPE INLET PROTECTION
	EROSION MATTING
	CHECK DAM - TEMPORARY
	BARRIER FENCE
	PROJECT DEMARCATION FENCE
	FILTER CURTAIN

NOTES:

- SILT FENCE LOCATIONS SHOWN ON THIS DRAWING ARE APPROXIMATE. THE CONTRACTOR IS RESPONSIBLE FOR INSTALLING THE SILT FENCE IN ACCORDANCE WITH THE GUIDELINES SET FORTH IN THE VERMONT GENERAL PERMIT FOR STORMWATER RUNOFF FROM CONSTRUCTION SITES. THE RESIDENT ENGINEER AND ON SITE COORDINATOR SHALL APPROVE ALL SILT FENCE LOCATIONS PRIOR TO PLACEMENT.
- FOR EROSION PREVENTION AND SEDIMENT CONTROL PLAN GENERAL NOTES, SEE SHEETS 147 - 148, AND DETAILS, SEE SHEETS 177 - 180.

JONES MILL POND
 WETLAND #12
 CLASS 2
 PSSI/EMY



EROSION CONTROL PLAN 15	
PROJECT NAME:	BRANDON
PROJECT NUMBER:	NH 019-3(495)
FILE NAME:	zb008s5-ec15.dgn
PROJECT LEADER:	CRB
DESIGNED BY:	NLL
CLD 02-0149	
PLOT DATE:	9/3/2009
DRAWN BY:	NLL
CHECKED BY:	PTS
SHEET	163 OF 546