VAOT Metric

TEMPORARY STONE CHECK DAM, TYPE I
STA 19+390 - 19+493 RT

INLET PROTECTION DEVICE, TYPE I
STA 19+495 RT
STA 19+520 RT

GEOTEXTILE FOR SILT FENCE
STA 19+390 - 19+438 LT
STA 19+456 - 19+501 LT
STA 19+539 - 19+550 LT

PROJECT DEMARCATION FENCE
STA 19+390 - 19+448 LT
STA 19+393 - 19+495 RT
STA 19+454 - 19+550 LT

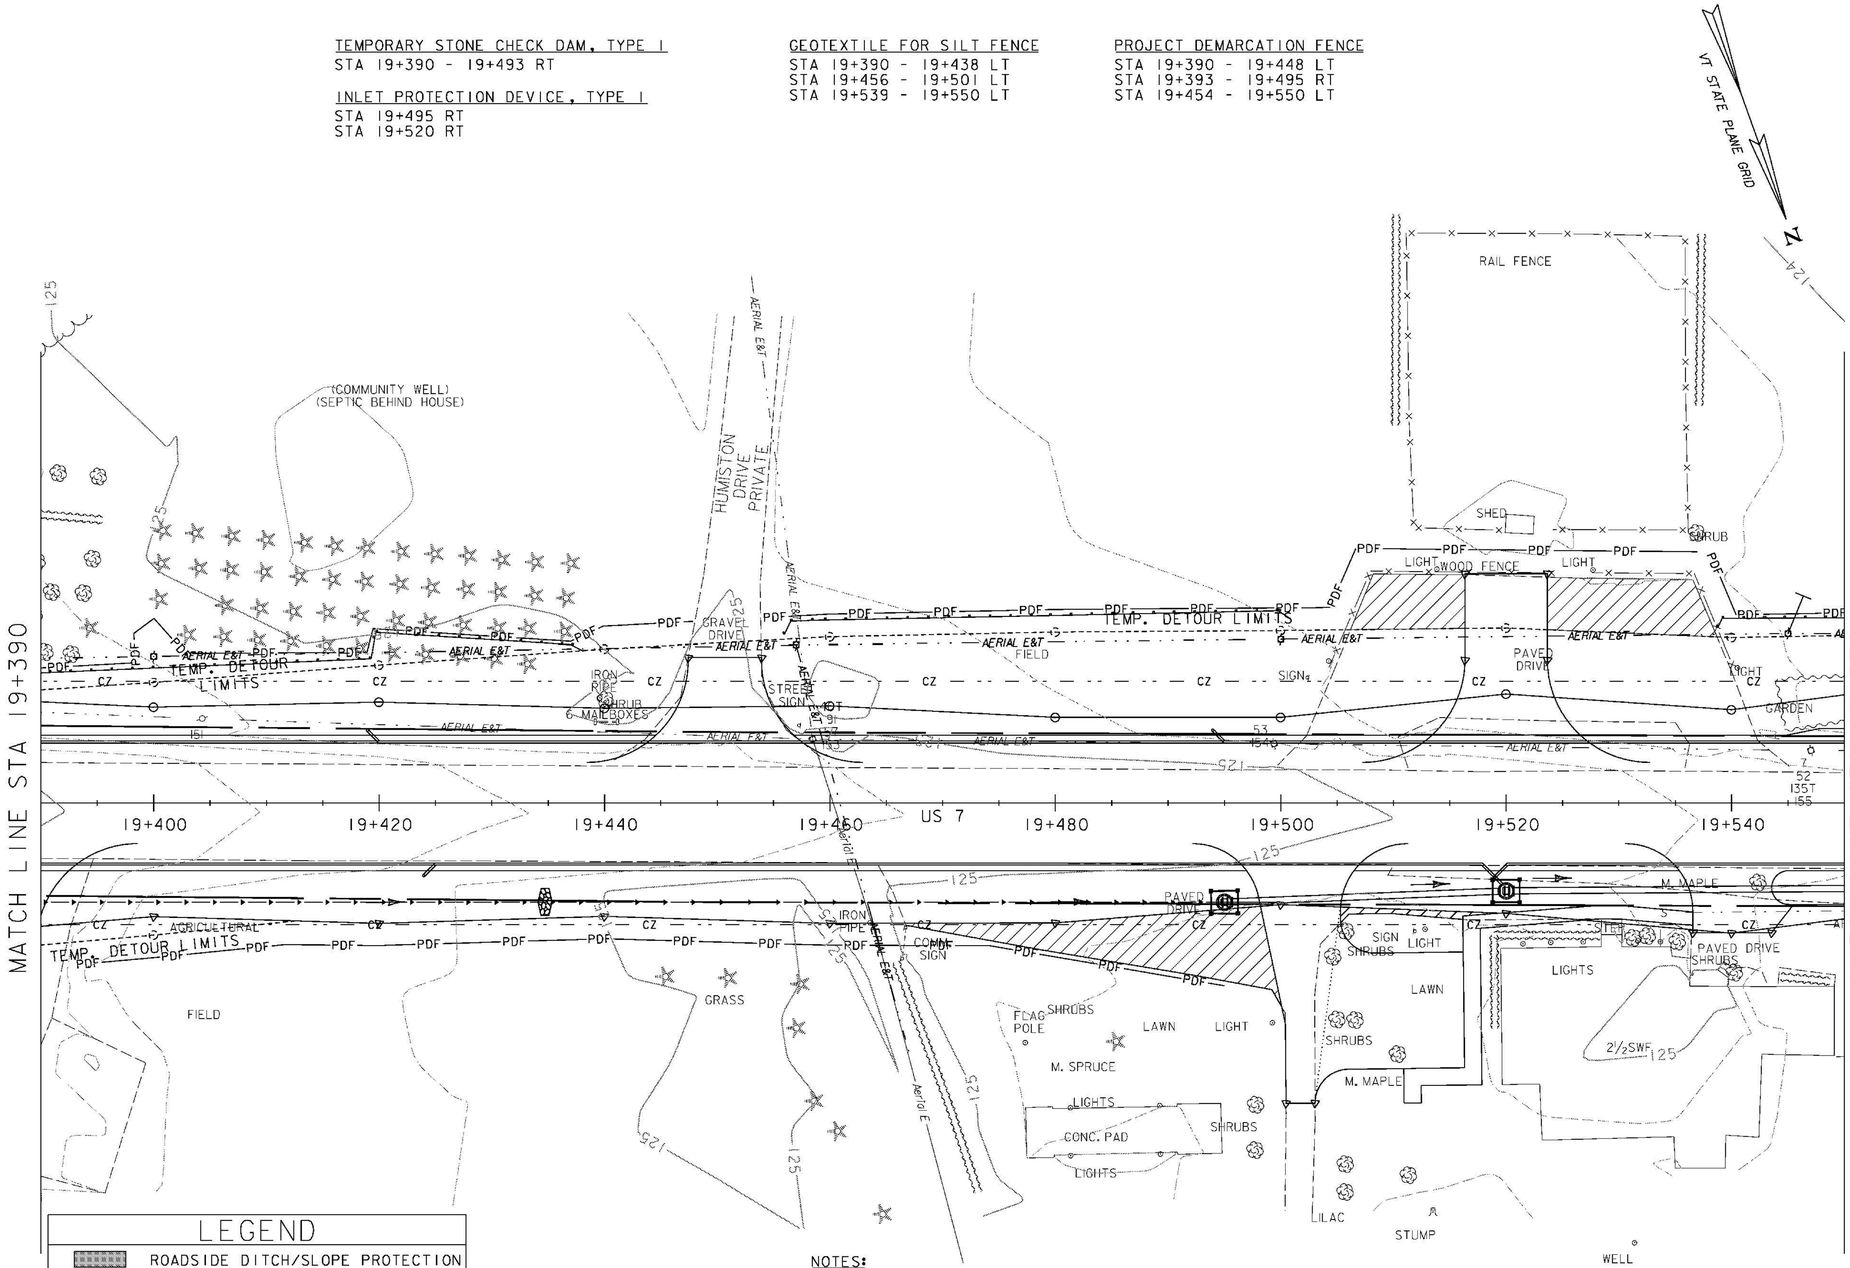

LEGEND

- ROADSIDE DITCH/SLOPE PROTECTION
- DETOUR SLOPE LIMITS
- PERMANENT SLOPE LIMITS
- SILT FENCE
- INLET PROTECTION DEVICE, TYPE I
- PIPE INLET PROTECTION
- EROSION MATTING
- CHECK DAM - TEMPORARY
- BARRIER FENCE
- —PDF— PROJECT DEMARCATION FENCE
- FILTER CURTAIN

NOTES:

1. SILT FENCE LOCATIONS SHOWN ON THIS DRAWING ARE APPROXIMATE. THE CONTRACTOR IS RESPONSIBLE FOR INSTALLING THE SILT FENCE IN ACCORDANCE WITH THE GUIDELINES SET FORTH IN THE VERMONT GENERAL PERMIT FOR STORMWATER RUNOFF FROM CONSTRUCTION SITES. THE RESIDENT ENGINEER AND ON SITE COORDINATOR SHALL APPROVE ALL SILT FENCE LOCATIONS PRIOR TO PLACEMENT.

2. FOR EROSION PREVENTION AND SEDIMENT CONTROL PLAN GENERAL NOTES, SEE SHEETS 147 - 148, AND DETAILS, SEE SHEETS 177 - 180.

0 10 20 30
SCALE IN METERS

EROSION CONTROL PLAN 20

PROJECT NAME: BRANDON
PROJECT NUMBER: NH 019-3(495)

FILE NAME: zb008s5-ec20.dgn
PROJECT LEADER: CRB
DESIGNED BY: NLL
CLD 02-0149

PLOT DATE: 9/3/2009
DRAWN BY: NLL
CHECKED BY: PTS