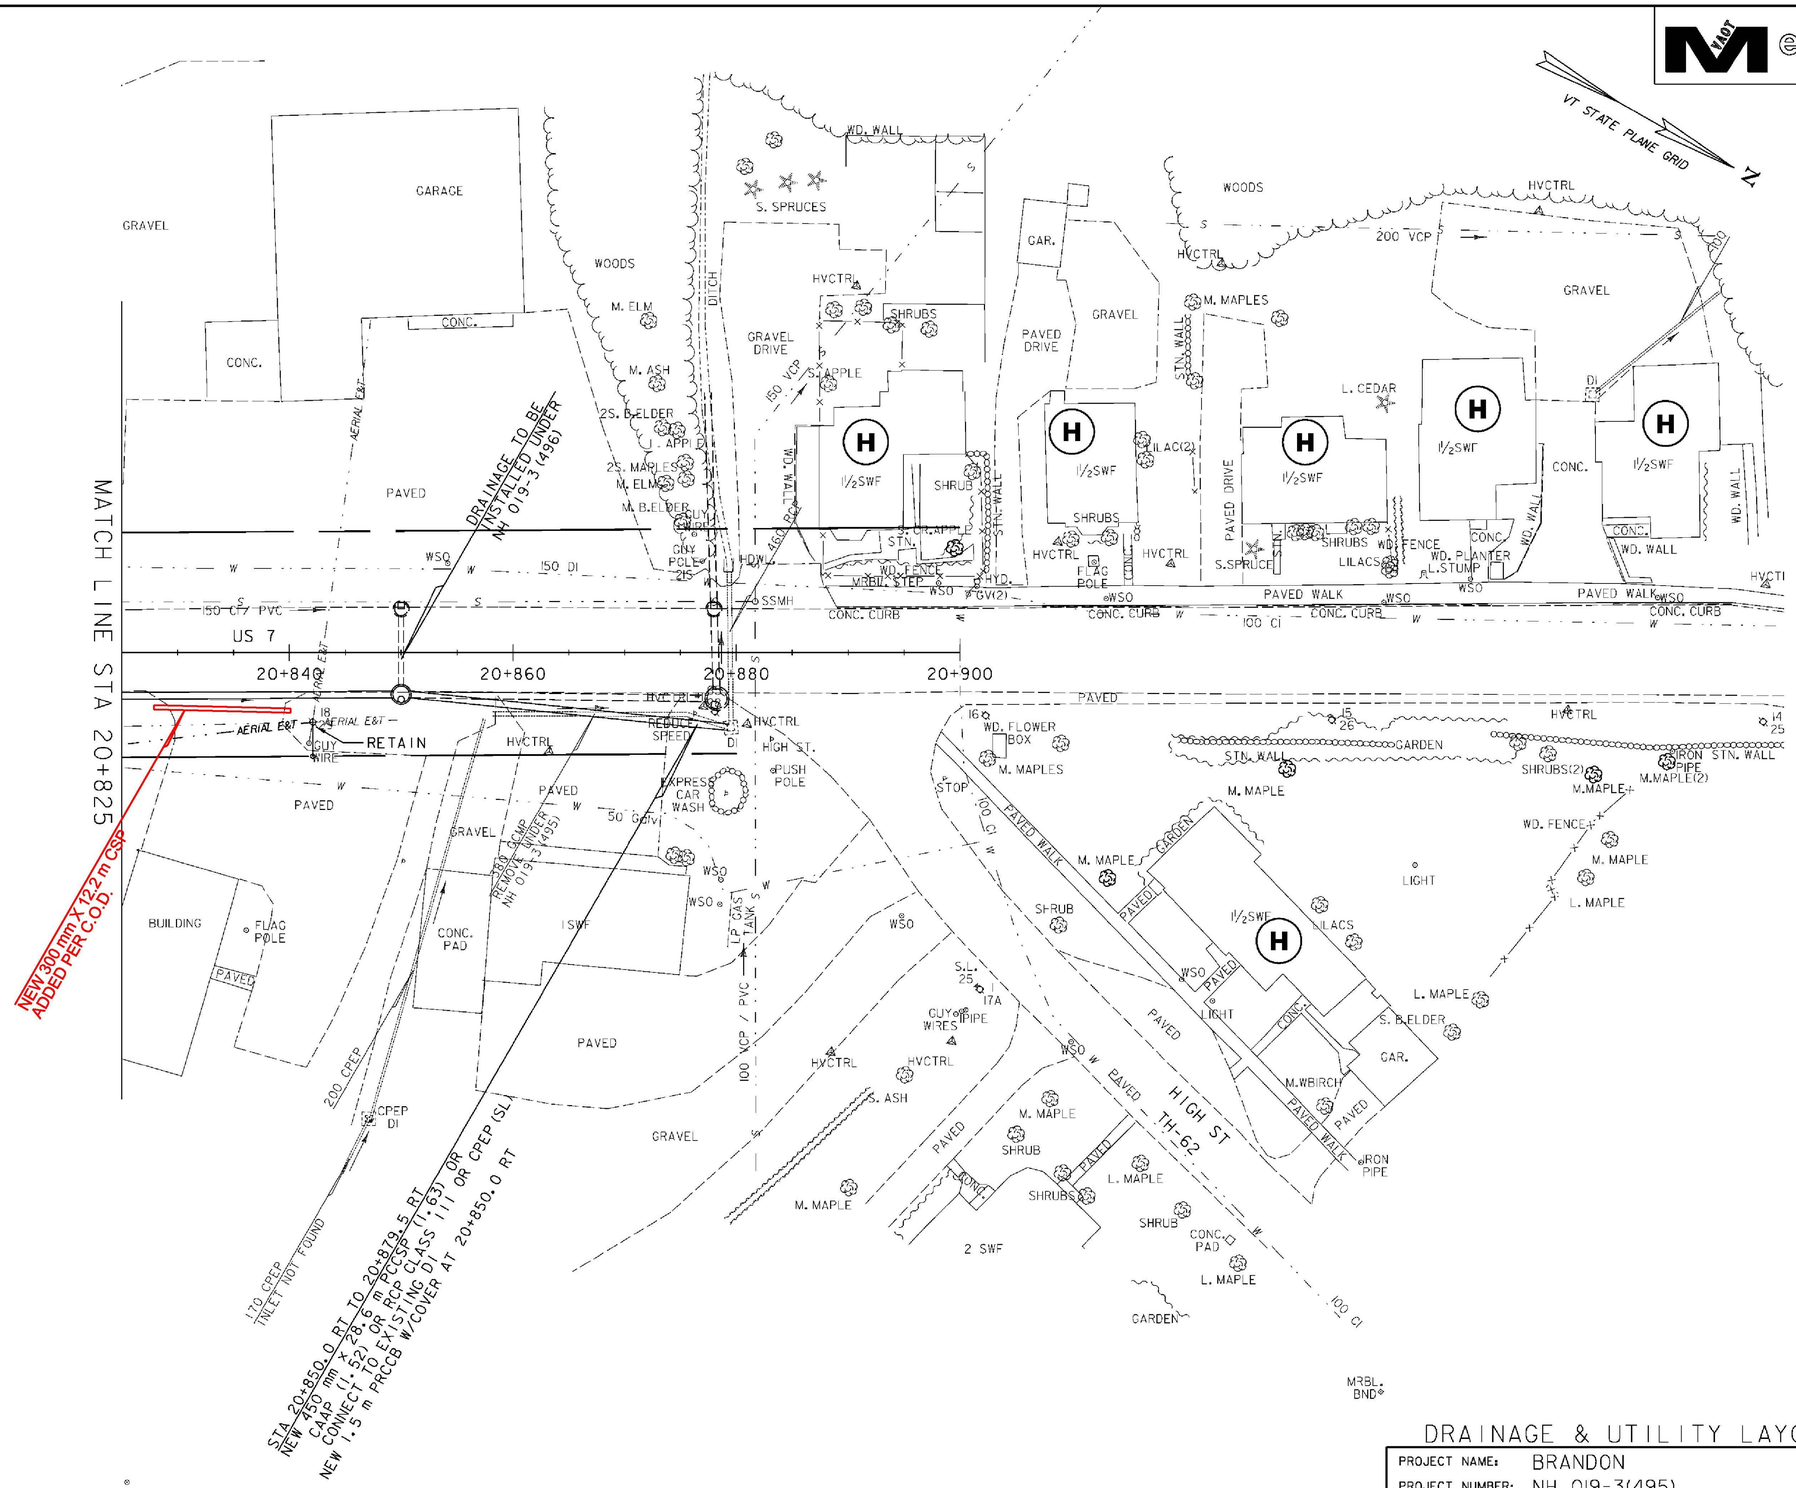

WATER - BRANDON FIRE DISTRICT #1
SEWER - TOWN OF BRANDON, WASTEWATER TREATMENT.

0 10 20 30
SCALE IN METERS

DRAINAGE & UTILITY LAYOUT 29

PROJECT NAME:	BRANDON
PROJECT NUMBER:	NH 019-3(495)

FILE NAME: zb008s5-drn29.dgn	PLOT DATE: 9/3/2009
PROJECT LEADER: CRB	DRAWN BY: NLL
DESIGNED BY: DAM	CHECKED BY: PTS
CLD 02-0149	SHEET 209 OF 546