DECIDUOUS SHRUBS
STA 16+555 TO 16+573 RT - 45 PO

LANDSCAPE BACKFILL, TRUCK MEASUREMENT
STA 16+530 TO 16+535 RT - 5 m x 0.8 m x 1 m
STA 16+555 TO 16+573 RT - 20 m x 4 m x 1 m

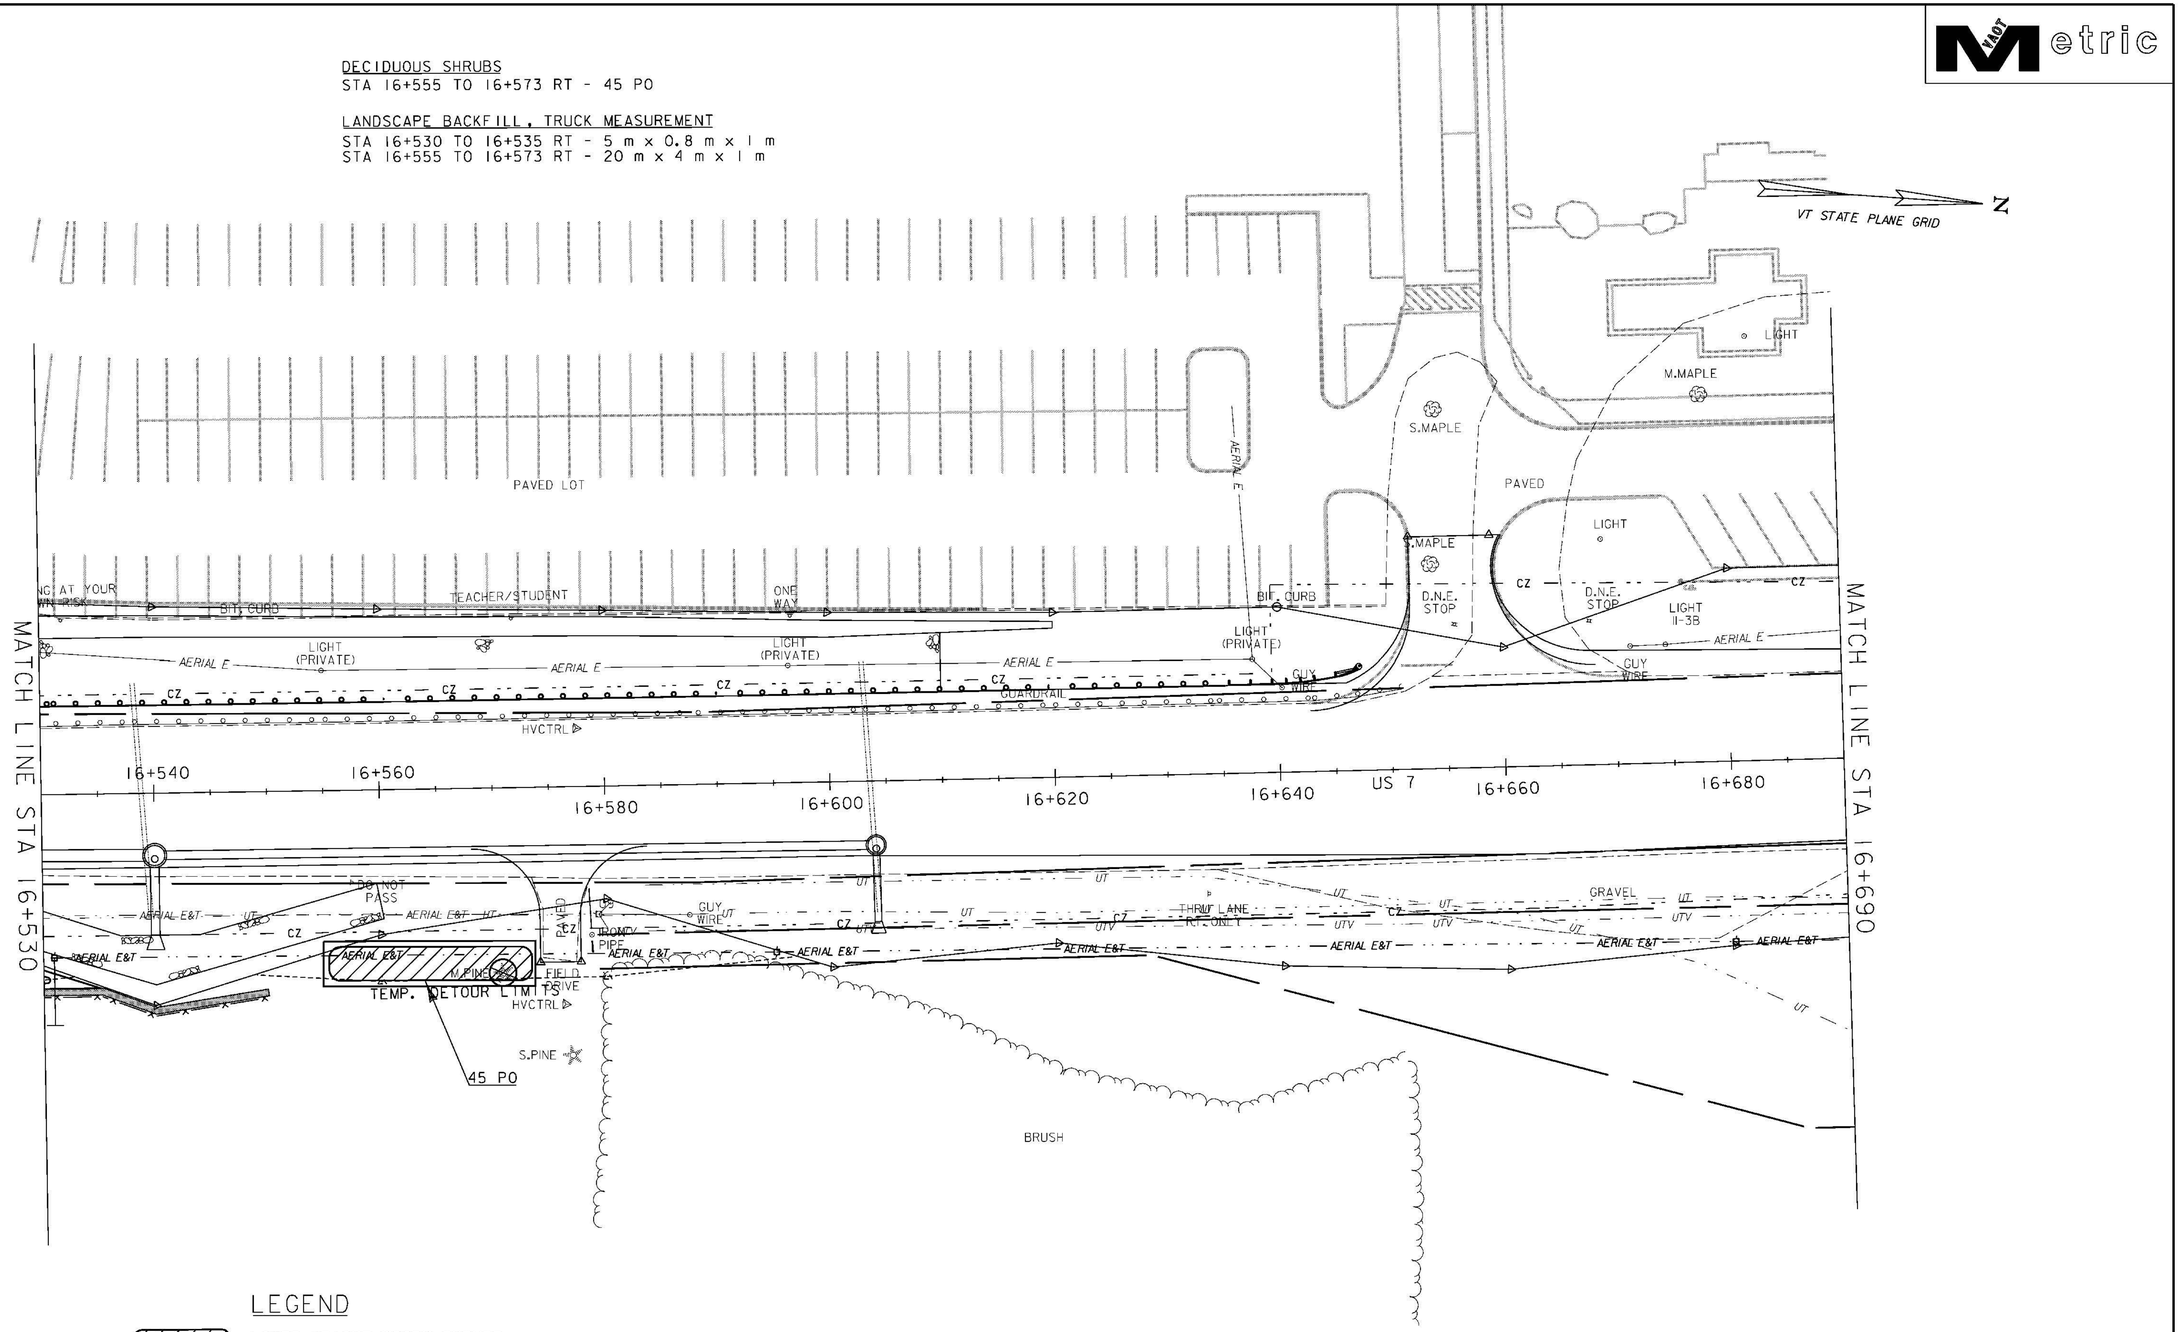

LEGEND

- LOWER HEIGHT WOODY SHRUBS
- PROPOSED DECIDUOUS TREE
- PROPOSED CONIFEROUS TREE
- SAVE TREE / TREE PROTECTION ZONE WITH FENCING (TPZ)
- LIMIT OF CUT & FILL / GRASS SEEDING OF DISTURBED AREAS
- LANSCAPE BACKFILL
- DENOTES TREE OR STUMP REMOVAL

0 10 20 30
SCALE IN METERS

LANDSCAPE PLAN 2

PROJECT NAME: BRANDON	
PROJECT NUMBER: NH 019-3(495)	
FILE NAME: zb008s5-ldsc02.dgn	PLOT DATE: 9/3/2009
PROJECT LEADER: VTRANS	DRAWN BY: JCS
DESIGNED BY: VTRANS	CHECKED BY: VTRANS
CLD 02-0149	SHEET 214 OF 546