DECIDUOUS SHRUBS
STA 17+950 TO 17+975 LT - 44 RT
STA 17+975 TO 18+013 RT - 10 PO
STA 18+080 TO 18+110 LT - 44 RT

DECIDUOUS TREES
STA 17+975 TO 18+013 RT - 3 BP, 2 AG
STA 18+065 TO 18+090 RT - 3 AF

EVERGREEN TREES
STA 17+975 TO 18+013 RT - 18 PG, 7 TO

TREE PROTECTION
STA 17+970 TO 17+980 RT - 1 TREE
STA 17+999 TO 18+000 LT - 1 TREE
STA 17+565 RT - 3.5 m X 1.25 m X 1 m

LANDSCAPE BACKFILL, TRUCK MEASUREMENT
STA 17+950 TO 17+975 LT - 30 m x 3 m x 0.3 m
STA 18+080 TO 18+110 LT - 30 m x 3 m x 0.3 m
STA 18+060 TO 18+090 RT - 30 m x 3 m x 1 m

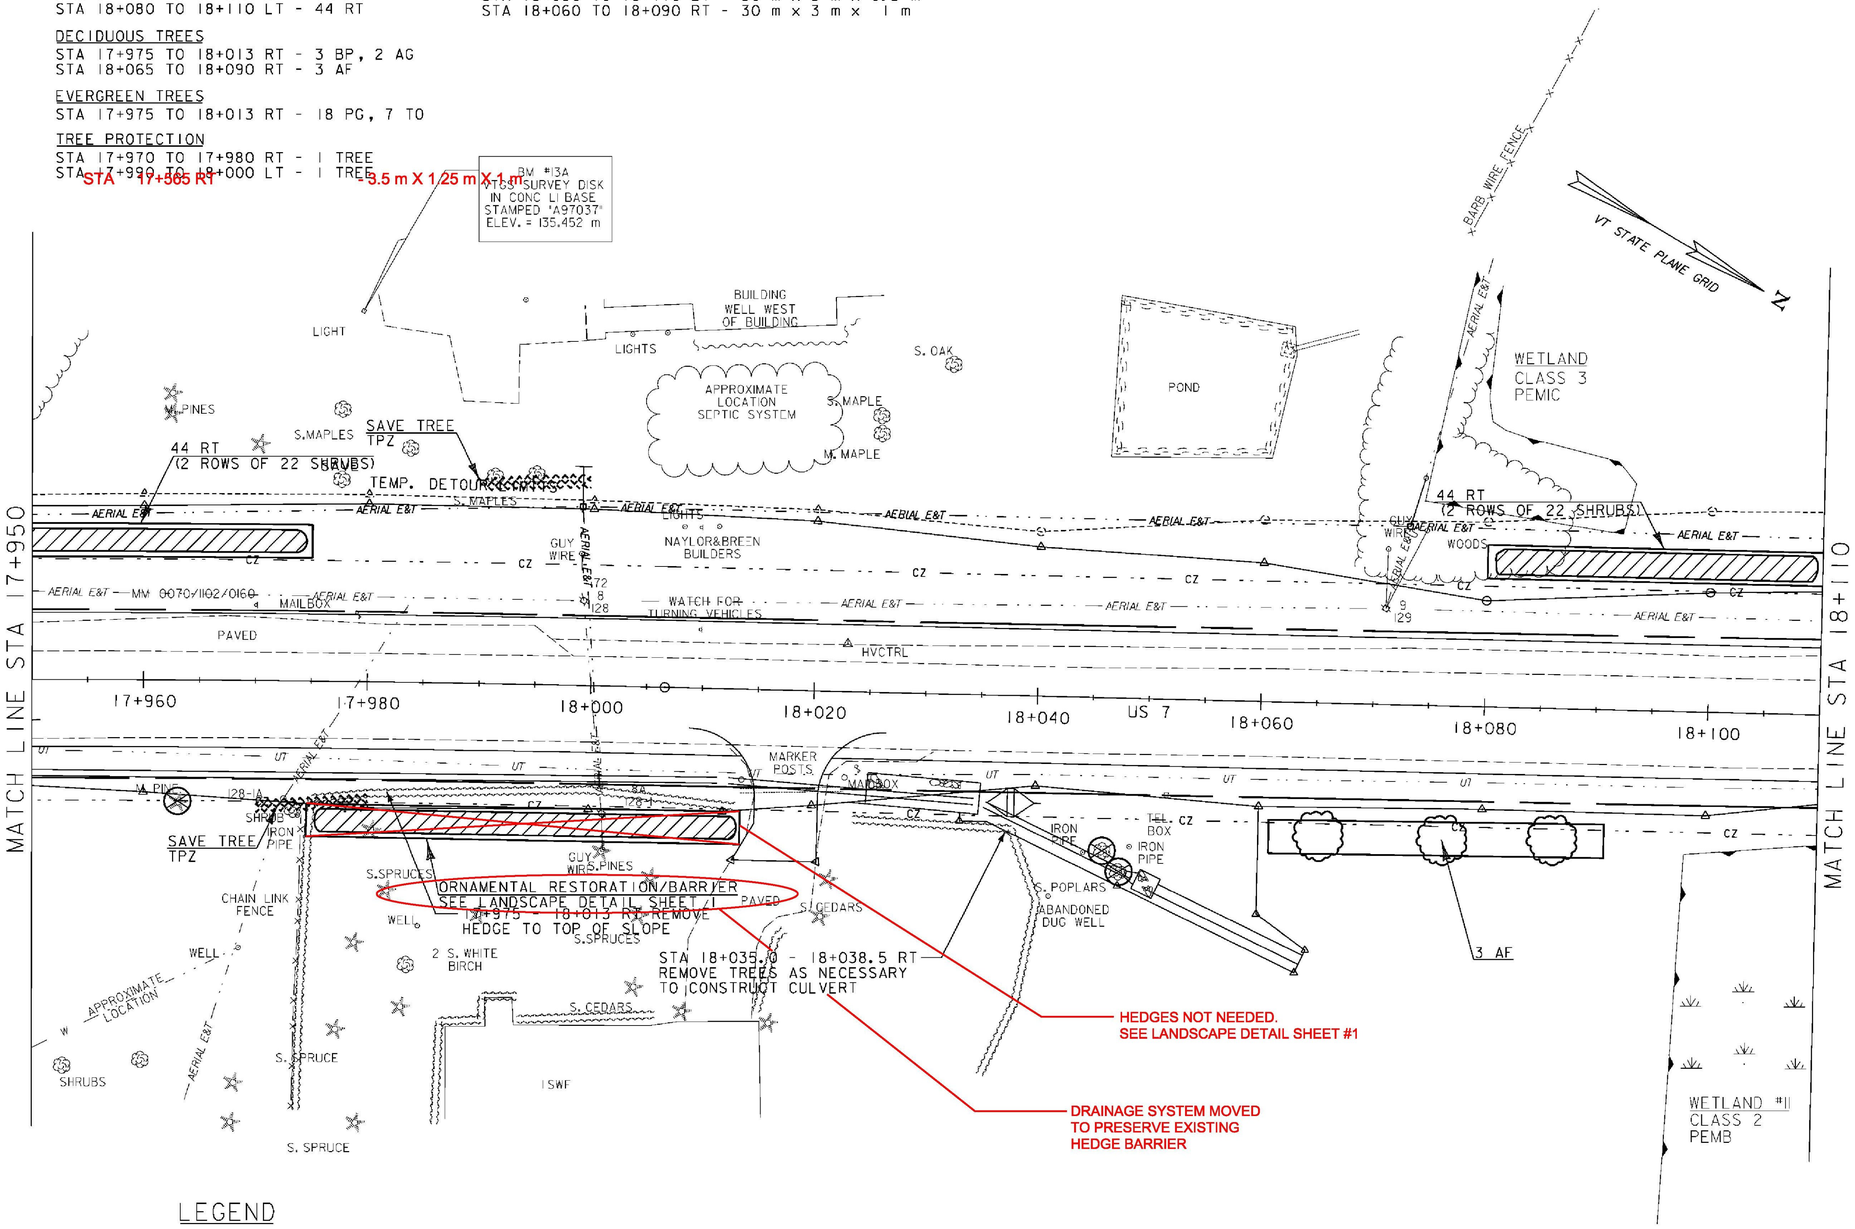

LEGEND

- LOWER HEIGHT WOODY SHRUBS
- PROPOSED DECIDUOUS TREE
- PROPOSED CONIFEROUS TREE
- SAVE TREE / TREE PROTECTION ZONE WITH FENCING (TPZ)
- LIMIT OF CUT & FILL / GRASS SEEDING OF DISTURBED AREAS
- LANDSCAPE BACKFILL
- DENOTES TREE OR STUMP REMOVAL

0 10 20 30
SCALE IN METERS

LANDSCAPE PLAN 11

PROJECT NAME: BRANDON
PROJECT NUMBER: NH 019-3(495)

FILE NAME: zb008s5-ldscll.dgn
PROJECT LEADER: VTRANS
DESIGNED BY: VTRANS
CLD 02-0149

PLOT DATE: 9/3/2009
DRAWN BY: JCS
CHECKED BY: VTRANS
SHEET 223 OF 546