DECIDUOUS SHRUBS
STA 18+860 to 18+880 LT - 32 PO

LANDSCAPE BACKFILL, TRUCK MEASUREMENT
STA 18+860 TO 18+880 LT - 22 m x 3 m x 1 m

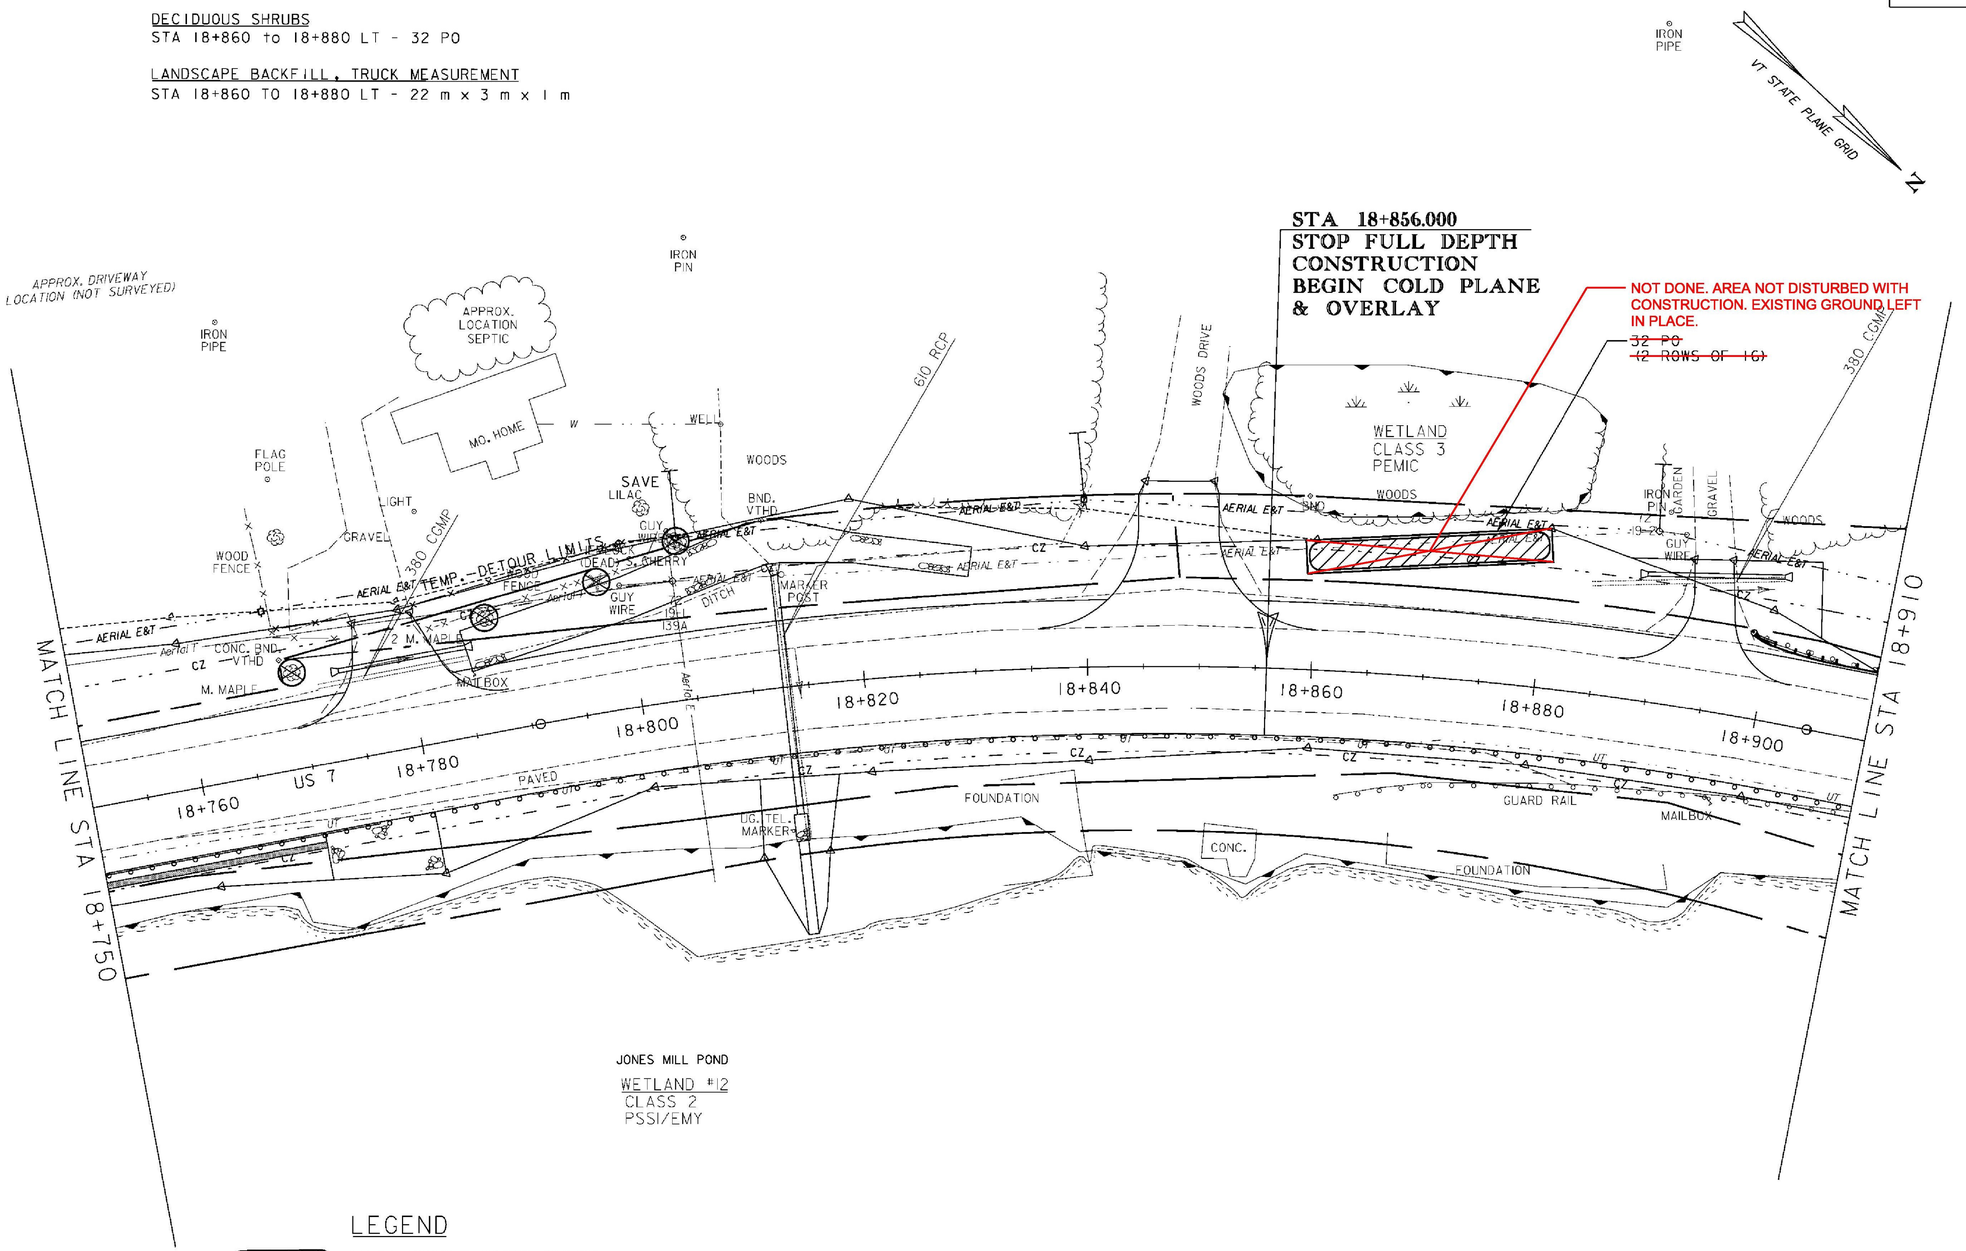

LEGEND

- LOWER HEIGHT WOODY SHRUBS
- PROPOSED DECIDUOUS TREE
- PROPOSED CONIFEROUS TREE
- SAVE TREE / TREE PROTECTION ZONE WITH FENCING (TPZ)
- LIMIT OF CUT & FILL / GRASS SEEDING OF DISTURBED AREAS
- LANDSCAPE BACKFILL
- DENOTES TREE OR STUMP REMOVAL

0 10 20 30
SCALE IN METERS

LANDSCAPE PLAN 16

PROJECT NAME: BRANDON
PROJECT NUMBER: NH 019-3(495)

FILE NAME: zb008s5-ldscl6.dgn
PROJECT LEADER: VTRANS
DESIGNED BY: VTRANS
CLD 02-0149

PLOT DATE: 9/3/2009
DRAWN BY: JCS
CHECKED BY: VTRANS
SHEET 228 OF 546